


A-03

Snið

1:100

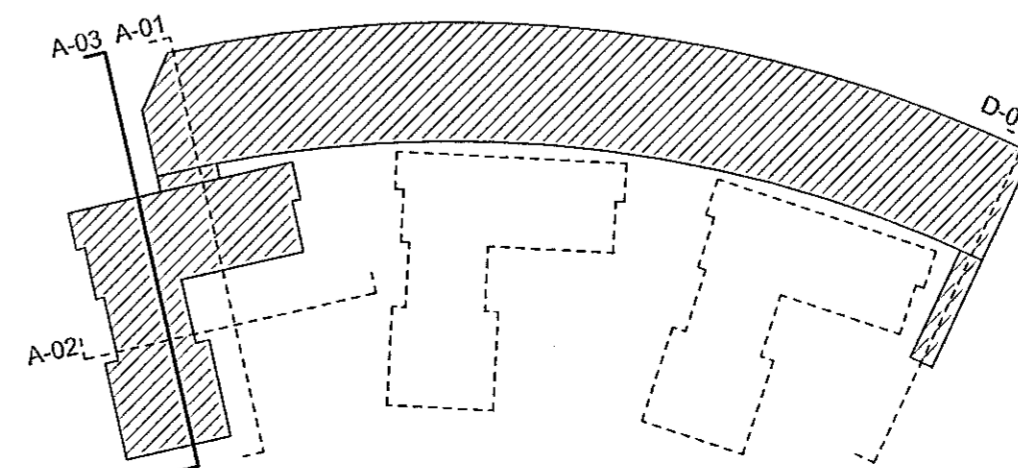

Yfirfarið af  
brunahönnuði  
**EFLA**  
VERKFRÆÐISTOFA

Aldis Rún  
Lárusdóttir  
Rafraen undirritun  
12.05.2022

Hringhamar 9  
Hafnarfjörður  
Snið A-03

SHS  
12.04.2022

dags.	12.04.2022
mkv.	1:100
teikn.	AB, AK
verknr.	2201

Haraldur Ingvarsson arkitekt 030956-3369 hi@plusark.is  
Páll Hjaltason arkitekt 070859-2119 ph@plusark.is  
Fiskisöld 31 101 Reykjavík 562-5959 www.plusark.is

A.4.3