


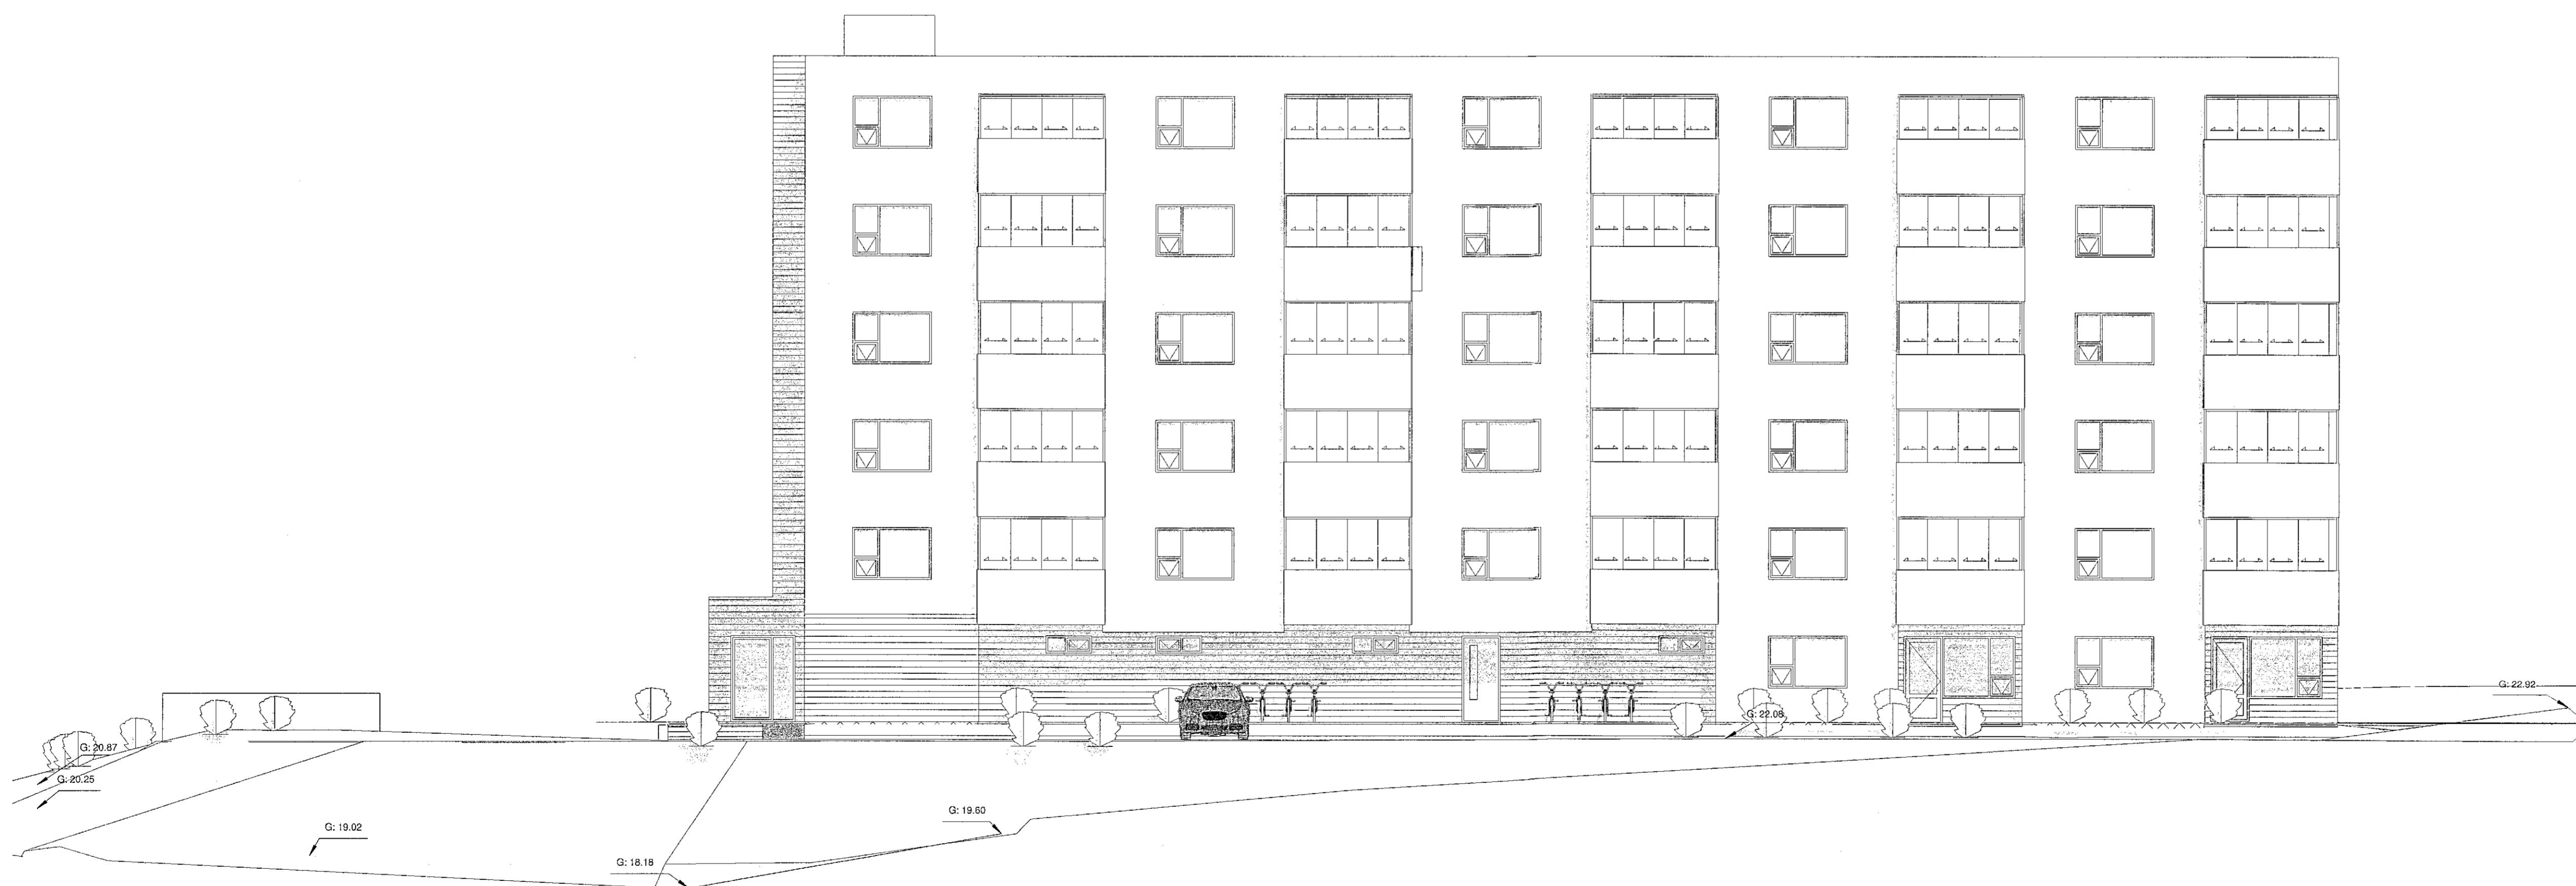

1 Suður
1:100



2 Vestur
1:100



JHS
24.05.22

Breytingar 05.05.2022:

1) Kornid fyrir gler gústlokun á einkasvölum íbúða.

mansard

teiknistofa ehf
Suðurlandsbraut 30 - 108 Reykjavík
www.mansard.is / jonhraf@mansard.is
Kl.: 570394-2079 - s:862-7102

Verkhelti: Eskivellir 11 - 220 Hafnarfirði

Efni: Aðaluppdrættir :
Útlit

Verknúmer: A-15-03-03	Mkv.: 1:100	A1
Teikn. nr.: A-109	Dags.: 22.08.2017	
Hannað: JHH	Teiknað: JHH	
Jón Hrafn Hildóversson byggingafræðingur BFI		
Kl.: 260662-6519		
Samþykkt:		