



GRUNNMYND 4.HÆÐ



SNÍÐ AA

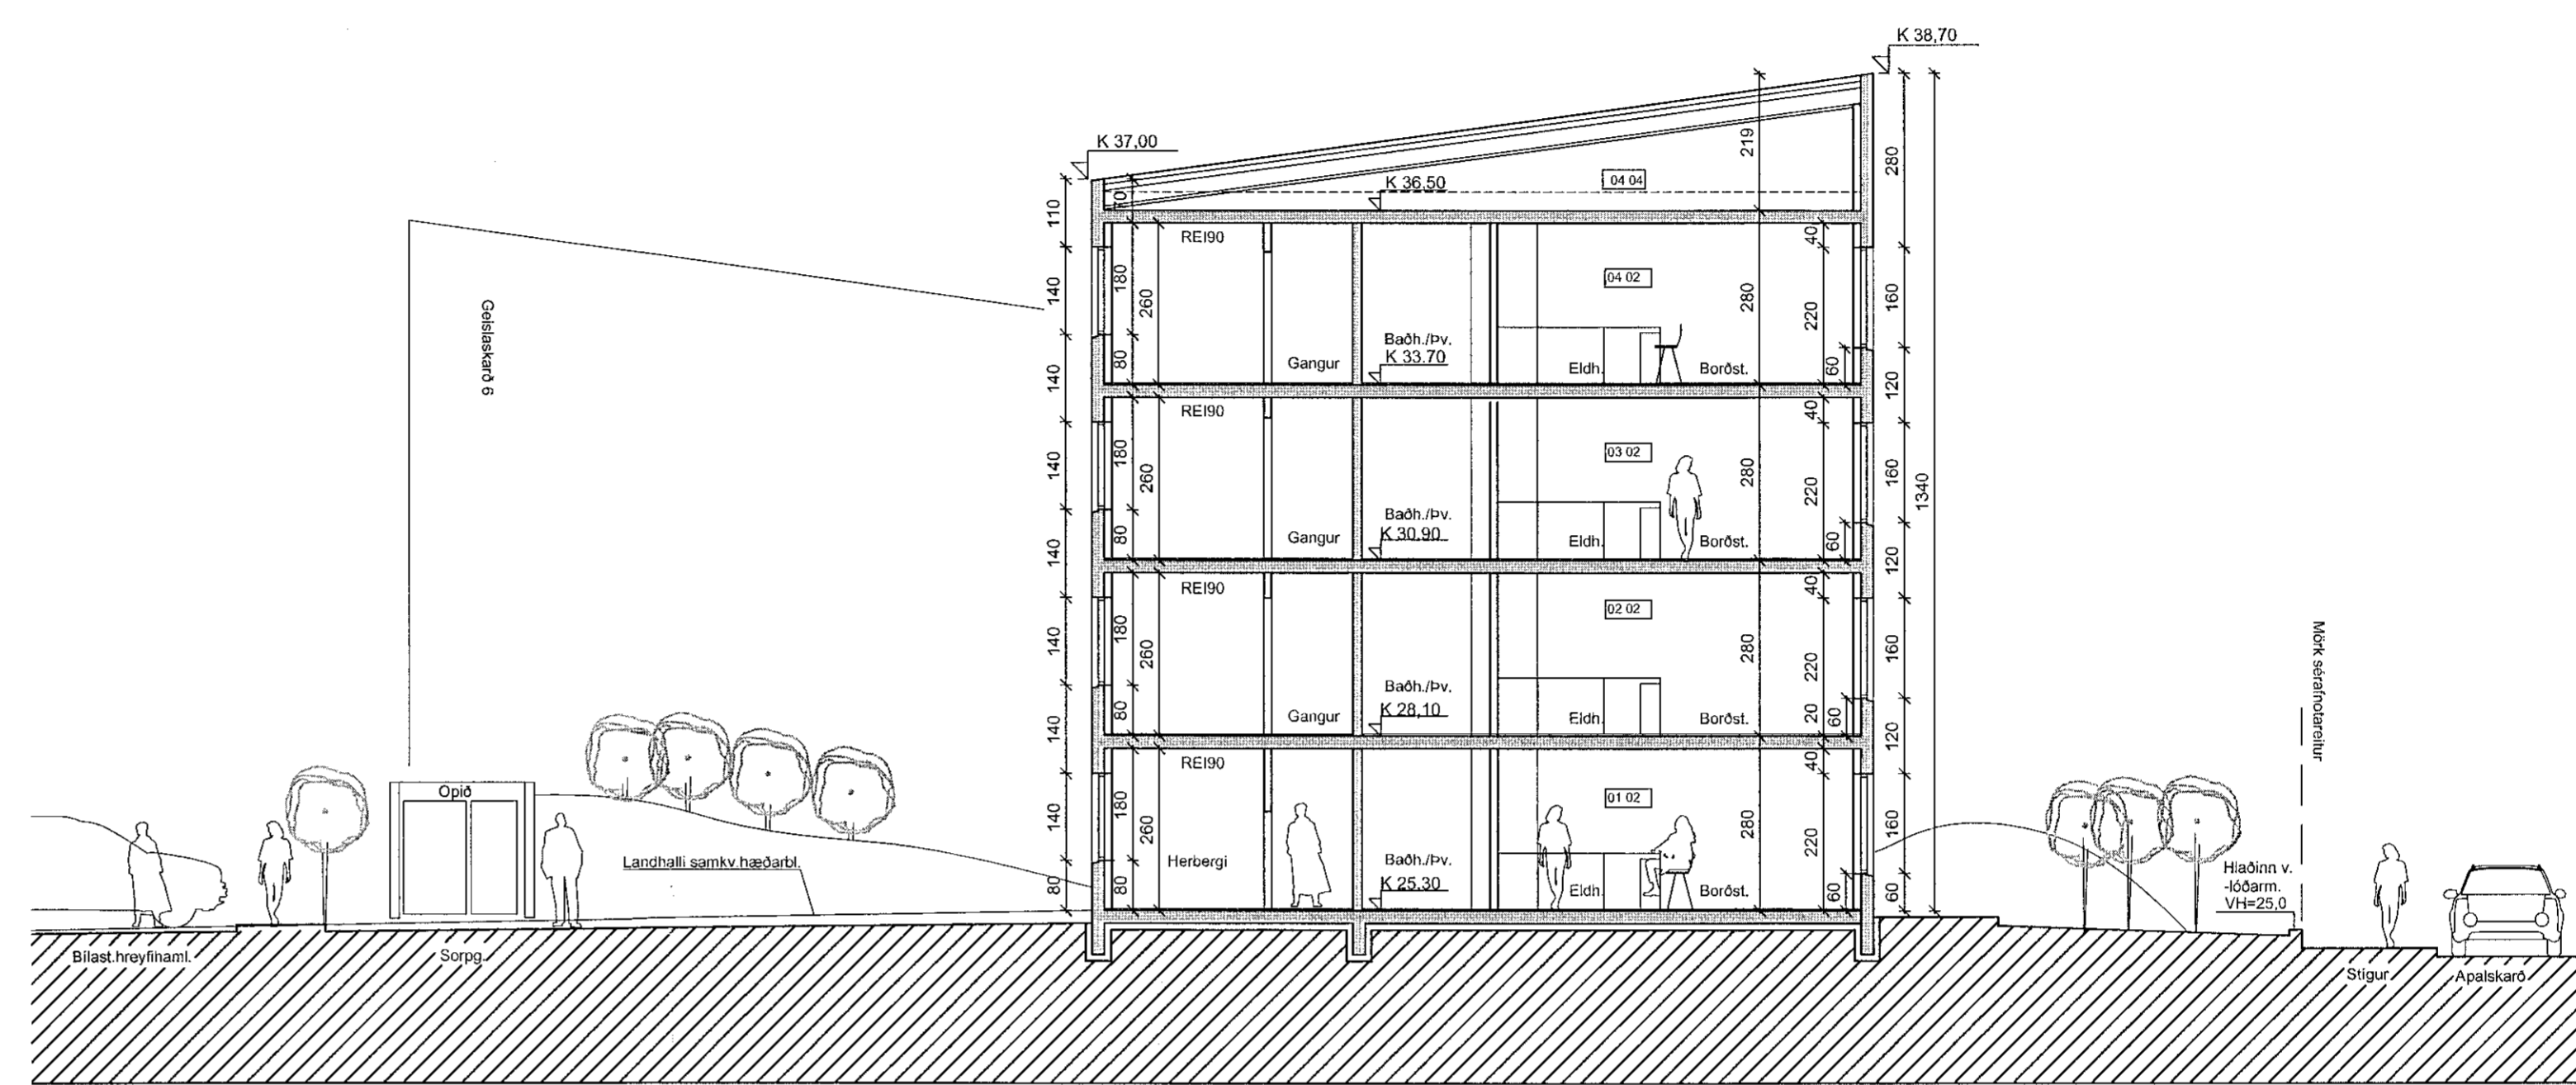

ÚTLIT VESTUR

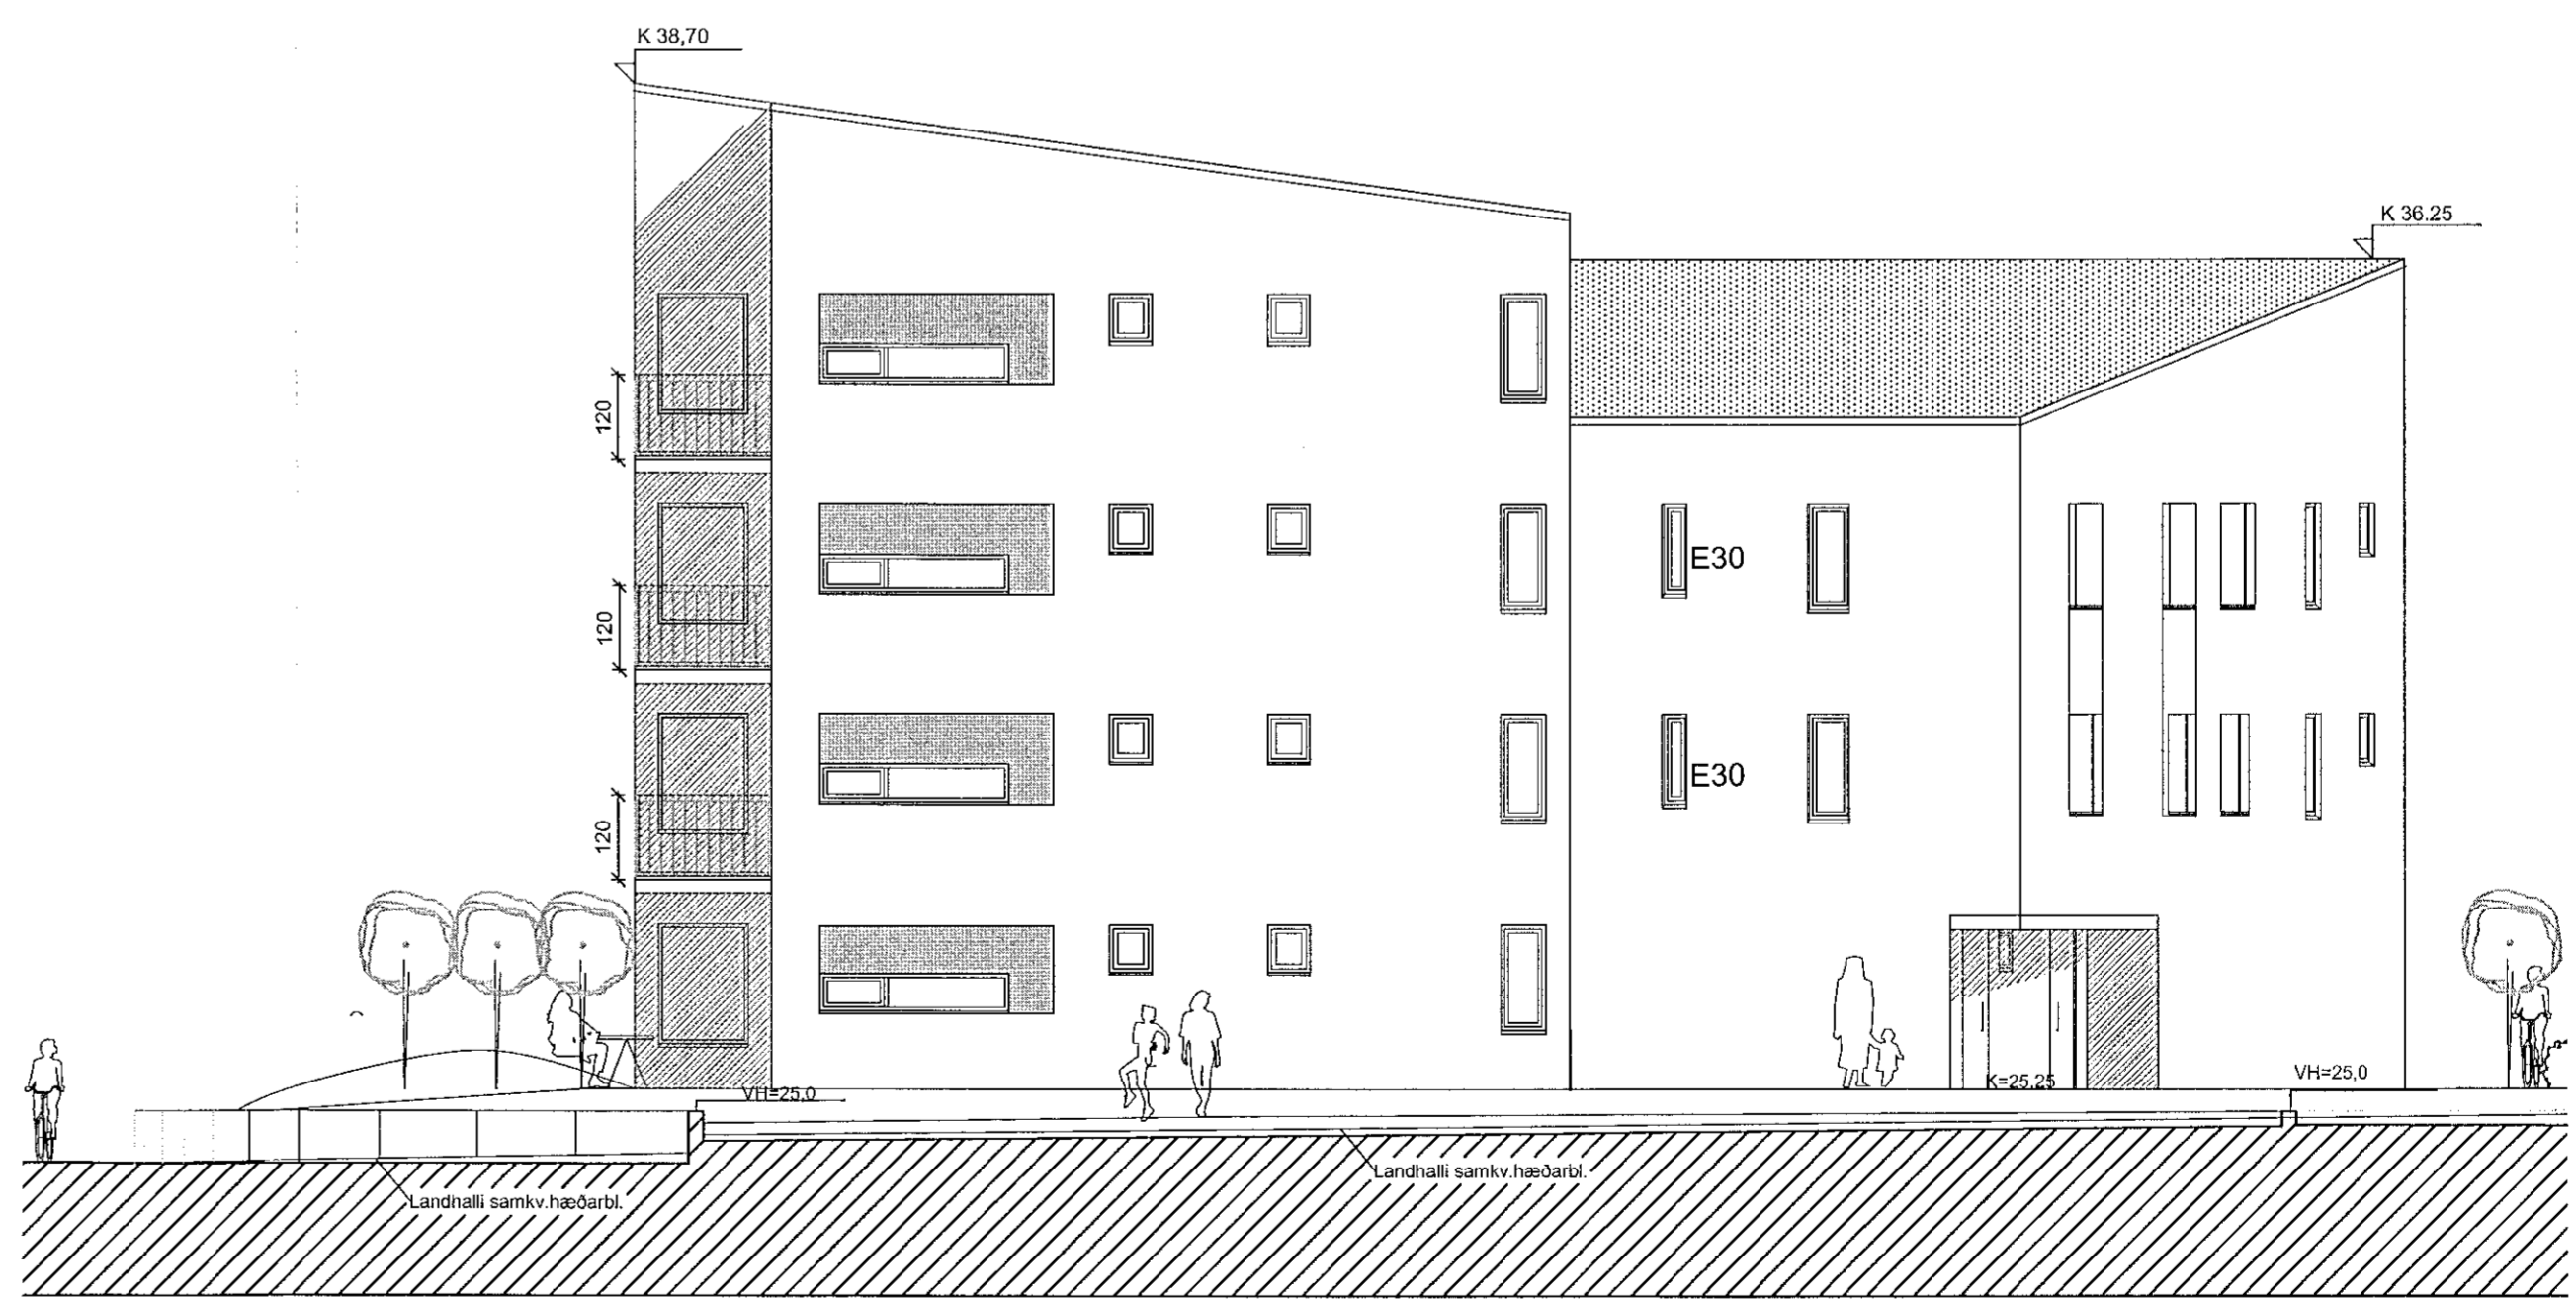

ÚTLIT AUSTUR

C:
B:
A: Reyndaruppráttur, sjnir breyt. og samr.v. verkteknir 25.05.21
BREYTINGAR: DAGS:

Digitally signed by
Stefán Þryggvason
DN: cn=Stefán Þryggvason, o=Stefán Þryggvason, email=stefan@stefan.is
Reason: I am the author of this document
Date: 2021.06.24 10:02

HÁDEGISSKARD 2 - HAFNARFIRÐI

VERK: 1710-GEIS2
KVARDI: 1:100
DAGS: 19,12-17
TEIKN: BOS-GS
AFST.MYND-GRUNNM.-ÚTLIT SKRÁ: Grunnur.dwg

ÚTI INNI

ARKITEKTAR
ÞINGHOLTSTRÆTI 27 101 REYKJAVÍK
SÍMAR 552 7600 & 552 7601 FAX 552 7601
NETFANG u@u.is VEFFANG u.is

BALDUR Ó. SWAVARSSON ARKITEKTAR FAI
120357-5149
JÓN ÞÓR ÞORVALDSSON ARKITEKTAR FAI
021256-7579