



Samþykkt þann
2.0. JÚLÍ 2022
Byggingarfulltrúi i Hafnarfirði
Sólveig Þorvaldsson

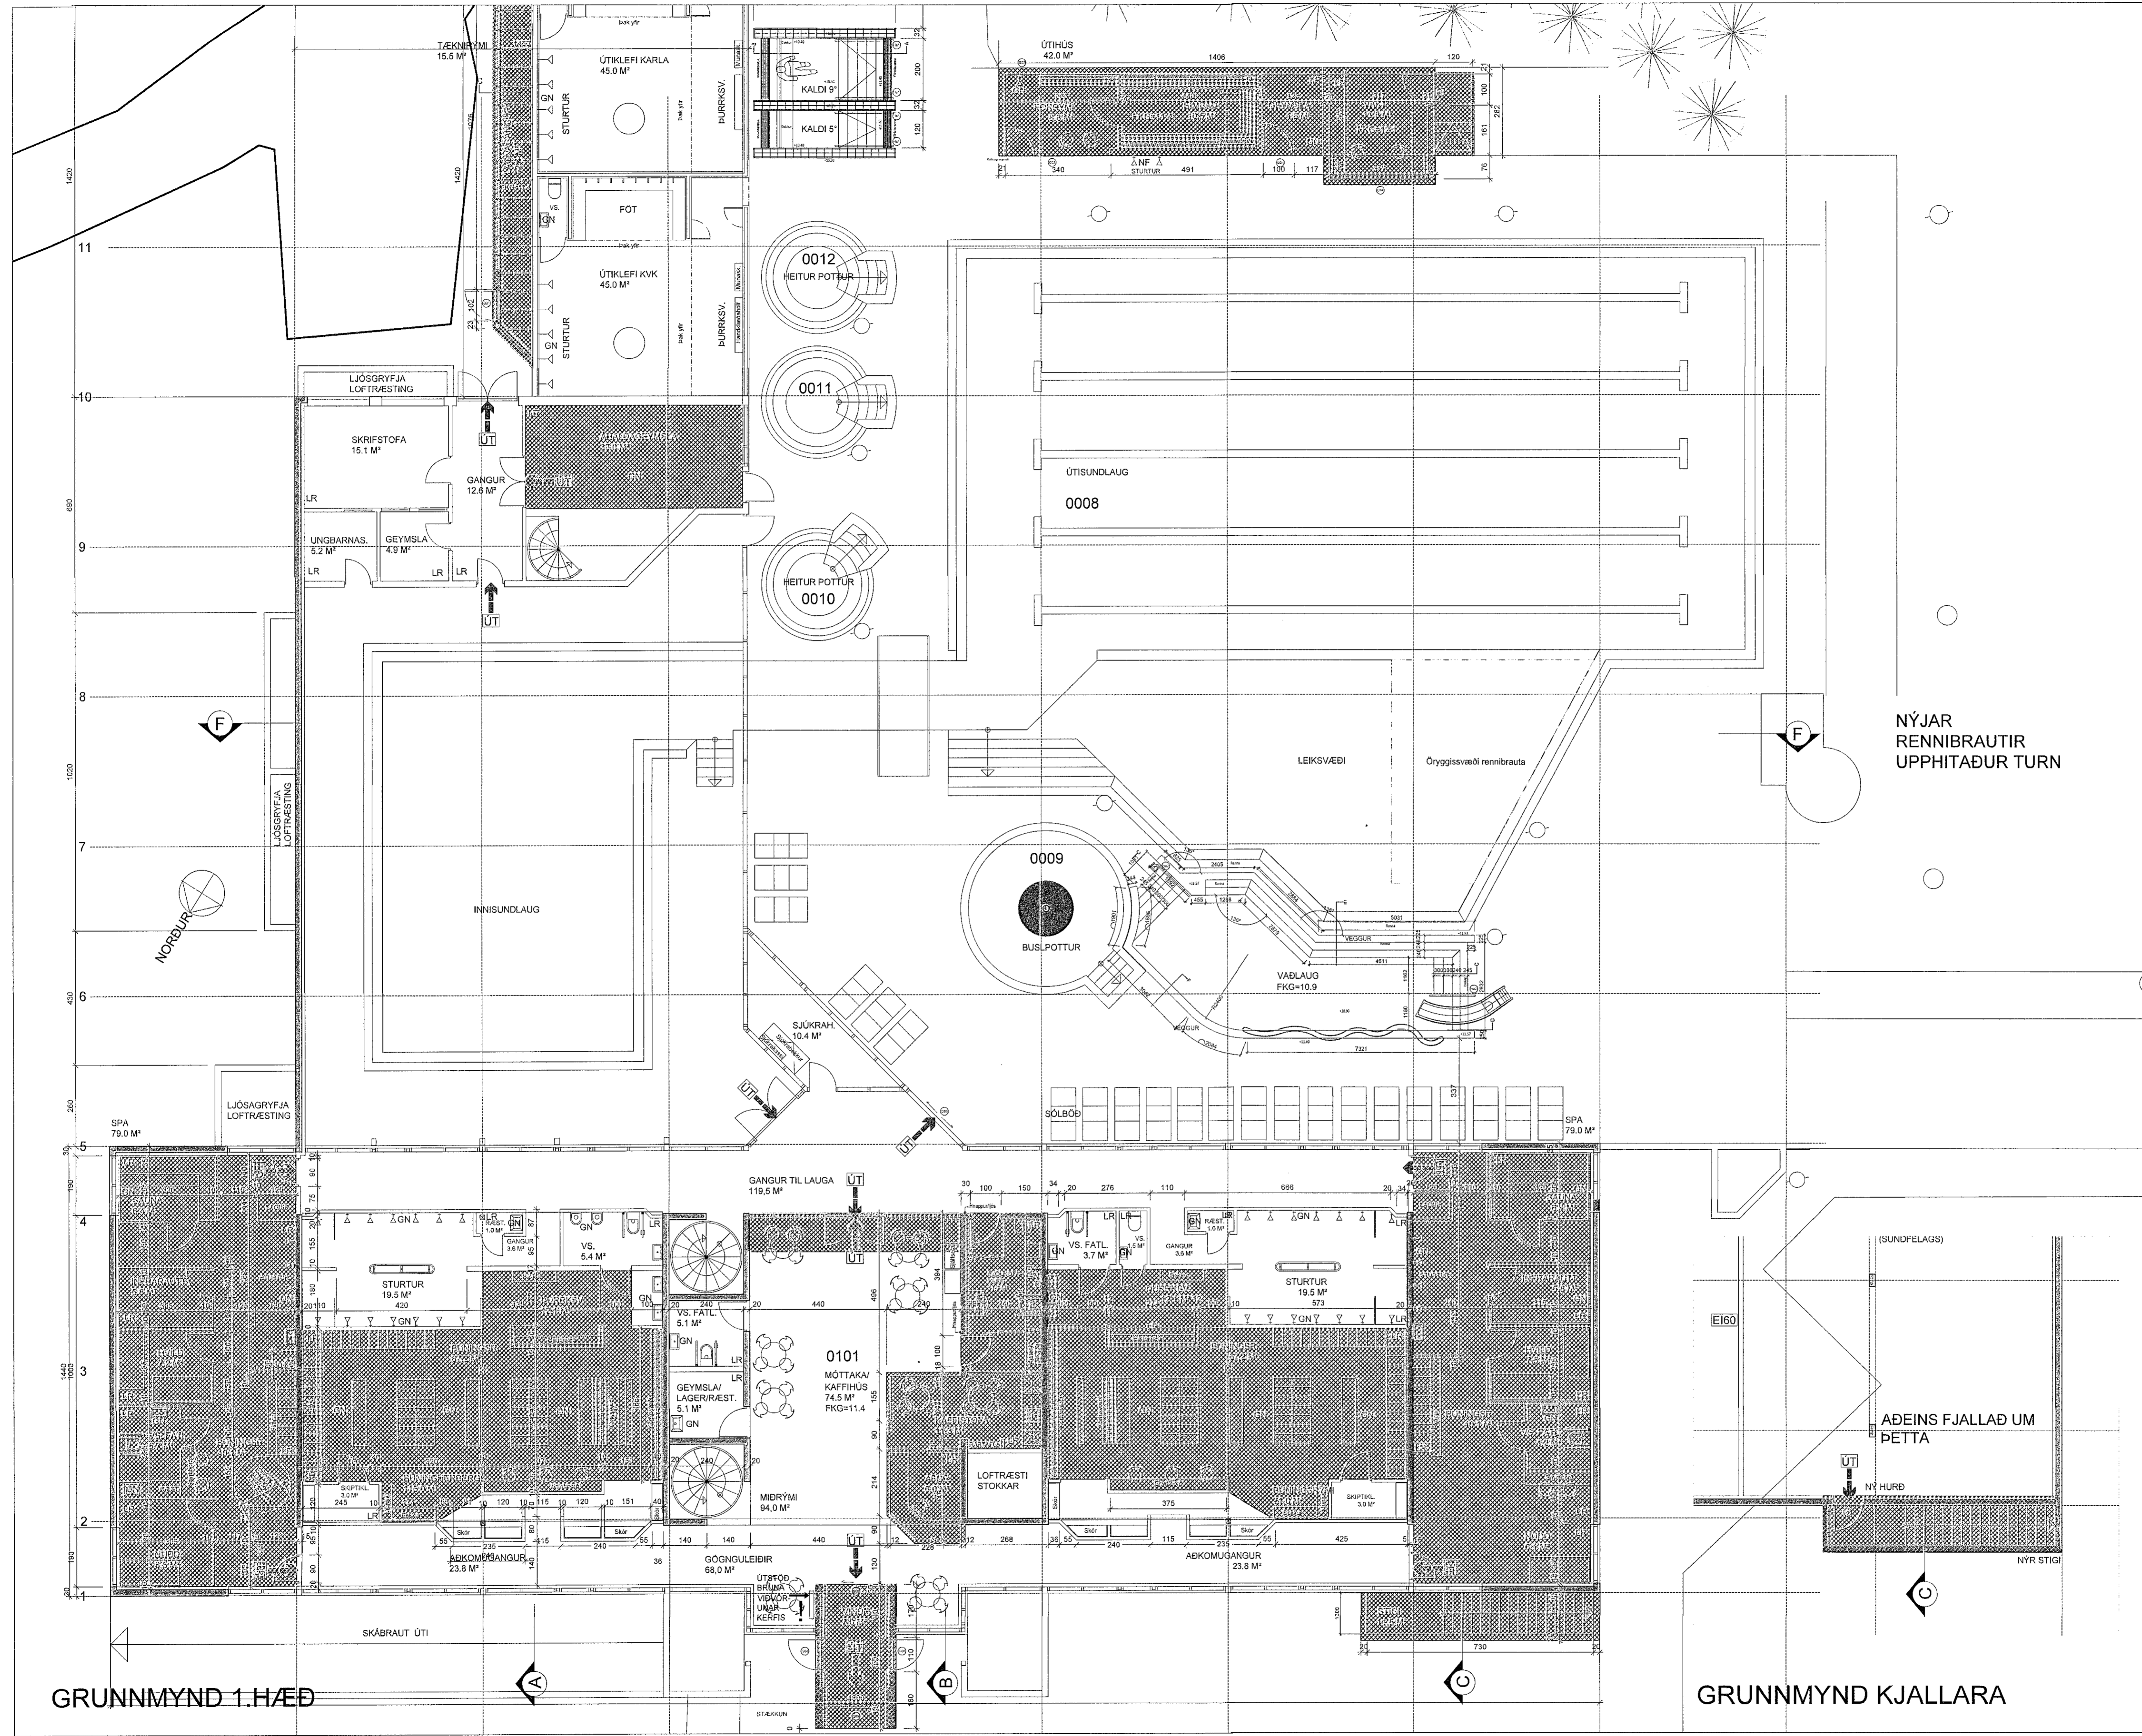

NÝJAR
RENNIBRAUTIR
UPPHITADUR TURN

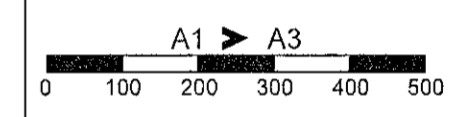

C:
B:
A:
BREYTINGAR: DAGS:

SKS
19.7.2022



ÁDALUPPDRATTUR

SUBURBÆJARLAUG HAFNARFIRÐI
BREYTINGAR ÚTI OG INNI
BREYTINGAR
GRUNNMYND 1. HÆÐ

VERK: 2135
KVARNÍ: 1:100
DAGS: 04.07.2022
TEKNI: Jþb
SKRÁ: 2135 grunnur.dwg

ÚTI INNI

ARKITEKTAR
DINGHOLTSSTRÆTI 27 101 REYKJAVÍK
SÍMAR 5527660 & 5527660 FAX 5527681
NETFANG w@ul.is VEFFANG www.ul.is

BALDUR Ó. SVAVRSSON ARKITEKTAR FAI
120357-5149
JÓN ÞÓR ÞORVALDSSON ARKITEKTAR FAI
021258-7579

GRUNNMYND 1. HÆÐ

GRUNNMYND KJALLARA