

skýringar:



Austur
 1 : 100



Vestur
 1 : 100

breytingar:

Verkhelli:
 Hringhamar 39 og 41


Aðalteikning

Útlit

Hannað af:	GG, AM, NA	Mælikvarði:	1 : 100
Teiknað af:	NA	Dagsetning:	30.08.2022

Samþykkt:

ARCHUS arkitektar
 Guðmundur Gunnlaugsson, arkitekt FAÍ
 kt: 190554-3419
 Archus slf, teiknistofa, Stórhóla 17,
 110 Reykjavík. s: 567 7735 gsm: 898 7894
 gg@archus.is - www.archus.is

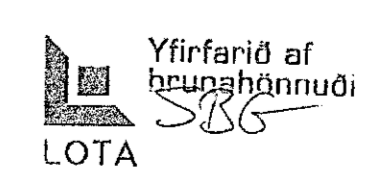

SHS
 13.9.22