


Útlit - Austur - Inngarður

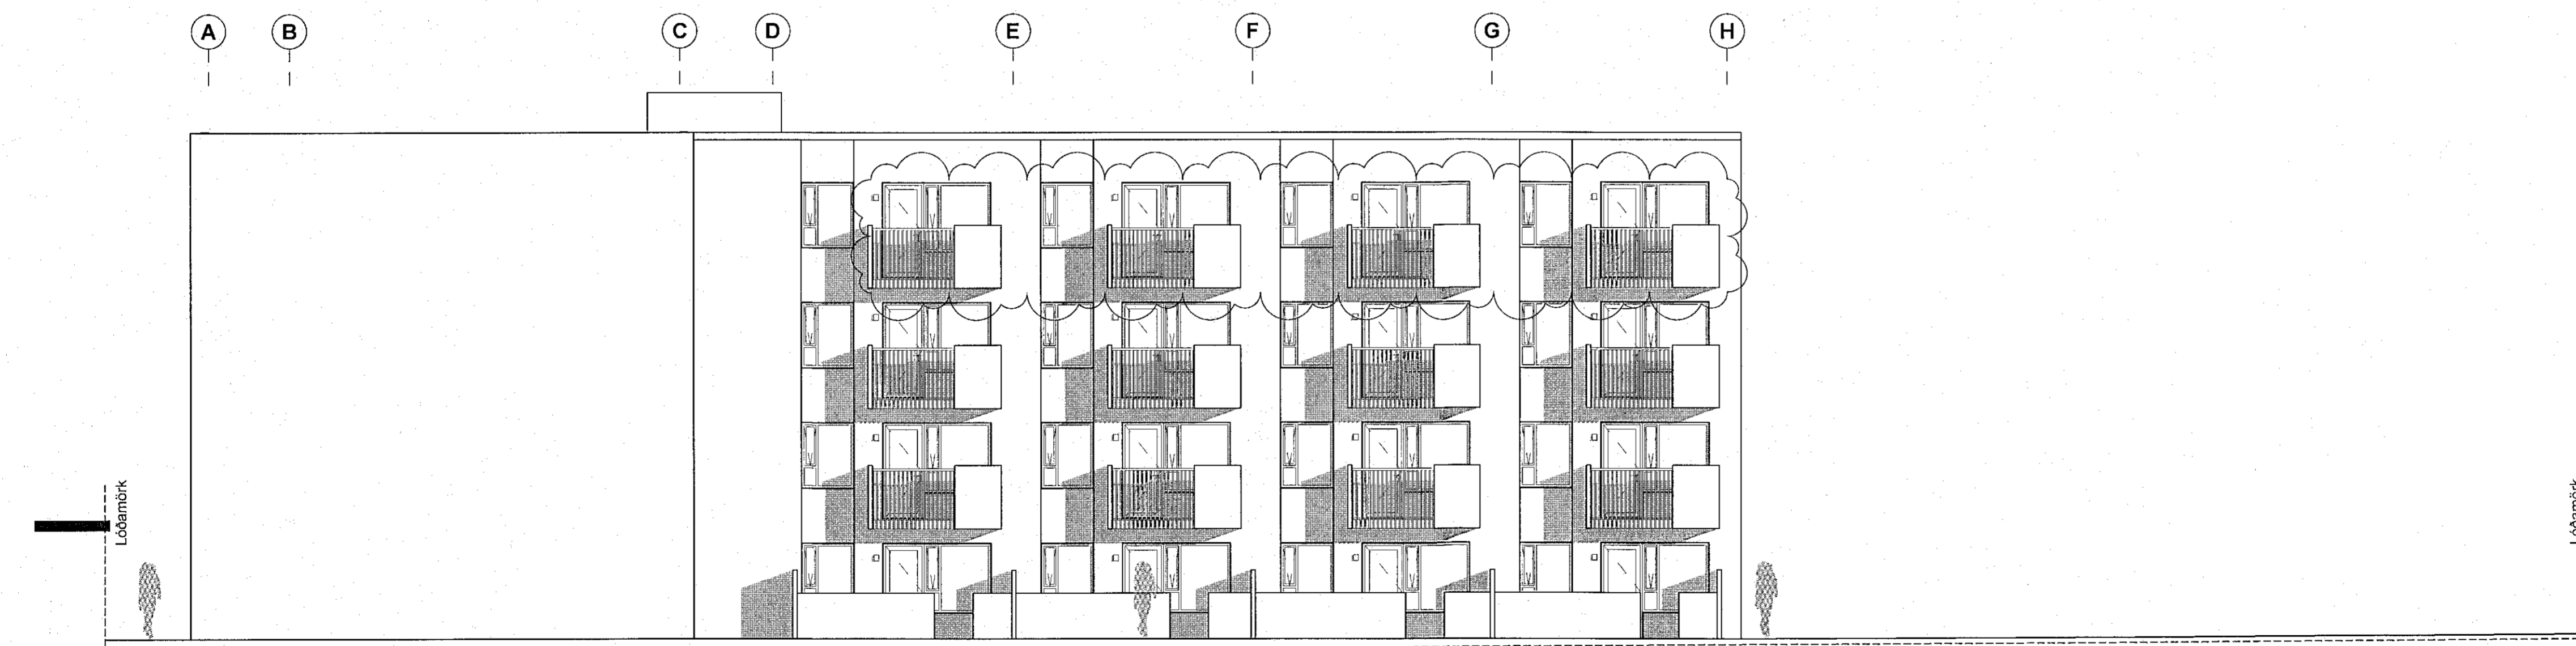


Útlit - Vestur - Inngarður



B 25.10.2022 AI Svalahurðum og svólum speglað, svalaveggur hækkar  
 A 31.05.2021 HI Br.v.athugas.b.fulltrúa

BREYTINGAR

*SHS 09.06.2022*

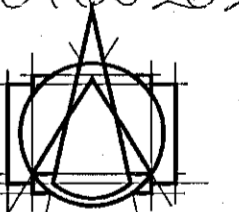

**T.ark**  
 ARKITEKTAR  
 HÁITÚNI 2B - 105 REYKJAVÍK  
 Sími: 540 5700  
 tark@tark.is - www.tark.is

VERJAMEN  
 Nónhamar 1-3, 221 Hafnarfj.  
 Fjölbýlishús, mhl 01  
 Aðaluppdrættir

VERK  
 Útlit - Inngarður Austur / Vestur

MÁL:	1 : 100	DAGS:	07.05.2021
HAÐAR:	ÁÁ	TEIÐAR:	HI/IL
YFIRAR:	ISC	FL. TEIKNINGAMER:	04 1.3-03
VERKINGMER:	753-16	CTG:	B

*Handwritten signature*

SAMP. Ásger Ágústsson / AUKENI MAA SAMARK KL 060161-5429

Öll réttindi og skráning er hluti af hækki. Er það samþykki höfundar, skv. ákveðnum hefurvaldaga.