


2.2x2.2	Brunalokanir
Ei.60Csm	Gólfniðurfall
GN	Gólfniðurfall
LR	Loftræsting
→ UT	Neyðarlýsing



B 25.10.2022 AI Vaski bætt við.
A 19.04.2021 HI Leiðrétt v. athugas. b.fulltr.

BREYTINGAR
SHS 13.04.2022

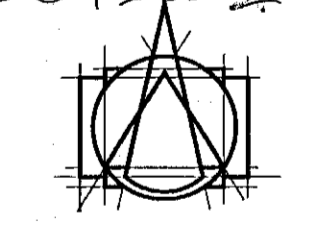

T.ark
ARKITEKTAR
HÁTÚNI 2b - 105 REYKJAVÍK
SÍMI: 540 5700
tark@tark.is - www.tark.is

VERKHÖFI
Nónhamar 1-3, 221 Hafnarfj.
Fjölbylishús, mhl 02, 1
Aðaluppdrættir

VERK
Grunnmynd kjallari

WÁL:	1: 100	DRAGS:	25.03.2021
Y-ANNAÐ:	ÁÁ	TEKNAÐ:	HI/IL
YFIRFARID:	ISC	FL. TEIKNINGANÖMUR:	OTC
VERKNÖMUR:	753-16	FL. TEIKNINGANÖMUR:	04 1.1-01
		OTC:	B

© 2022 og öftr teikninga, að litum eða meðal, er hald sambýkkt Íslandi, öv. ákveðnum höfundslögum.