


Snið A-A




Snið B-B

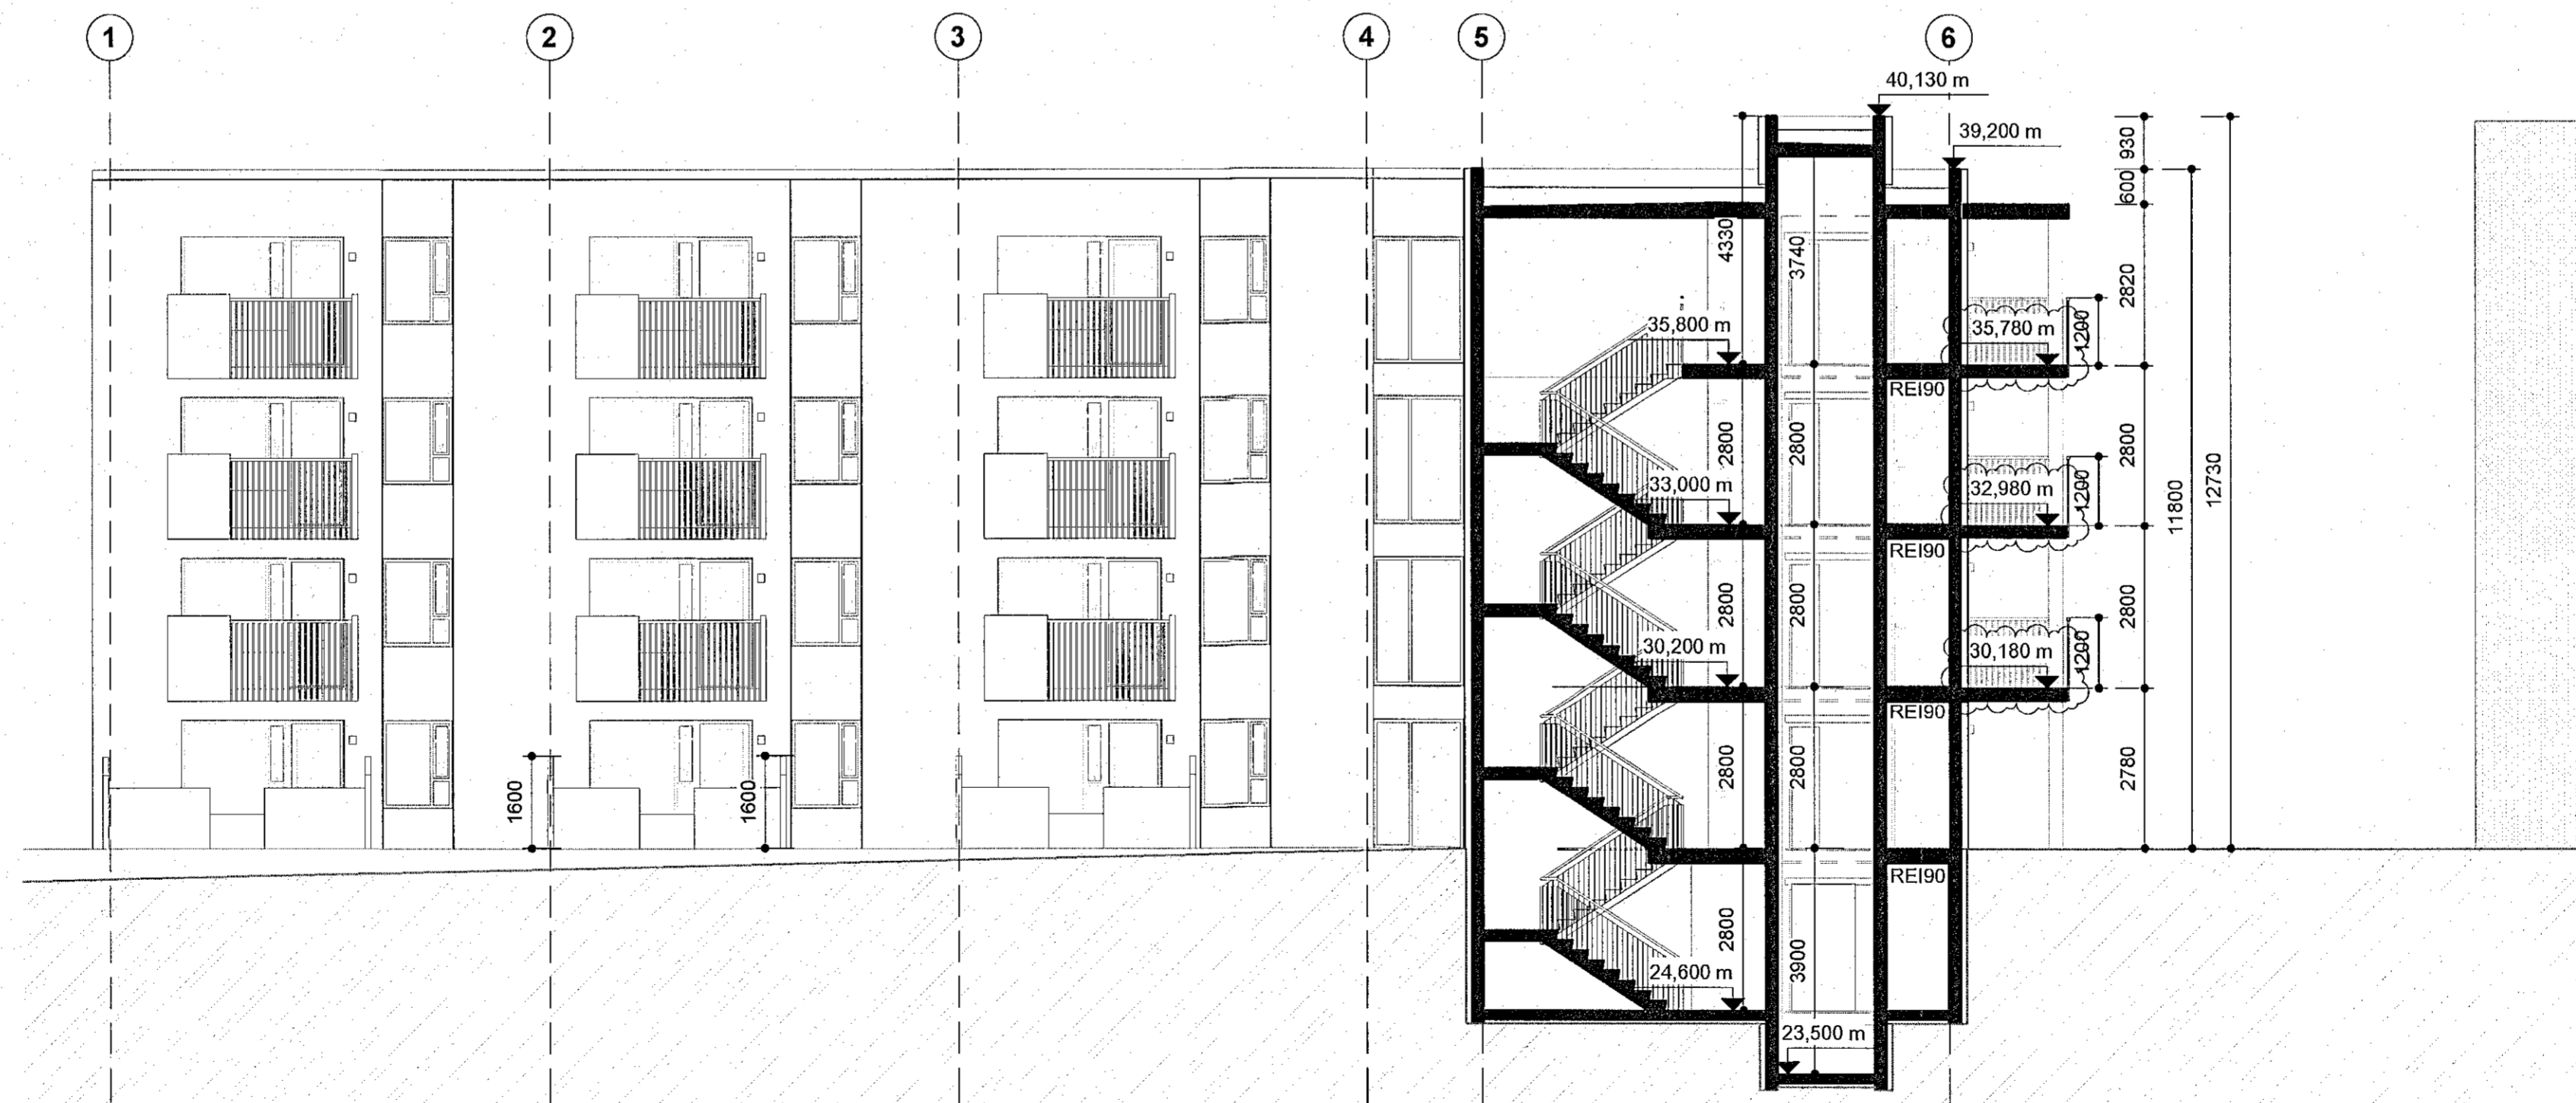

B 25.10.2022 AI Hæðakóta breytt  
A 19.04.2021 HI Leiðrétt v. athugas. b. fulltr.

BREYTINGAR  
SHS 13.04.2022

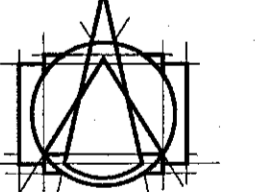

**T.ark**  
ARKITEKTAR  
HÁTÓNI 2B - 105 REYKJAVÍK  
SÍMI: 540 5700  
tark@tark.is - www.tark.is

VERKHEITI  
Nónhamar 1-3, 221 Hafnarfj.  
Fjölbýlishús, mhl 02,  
Aðaluppdrættir

VERK  
Sneiðingar A/B

MÁL:	DAGS:	
1 : 100	25.03.2021	
HANNAÐ:	TEIKNAD:	
ÁÁ	HI/IL	
YFIRFARID:		
ISC		
VERKNÖMUR	FL TEIKNINGANÖMUR	OTG
753-16	04 1.2-01	B

SAMM: Ásgunn Þjornólfsson Arkitekt MAA SAMARK KI.000161-5429