


Útlit - Suður

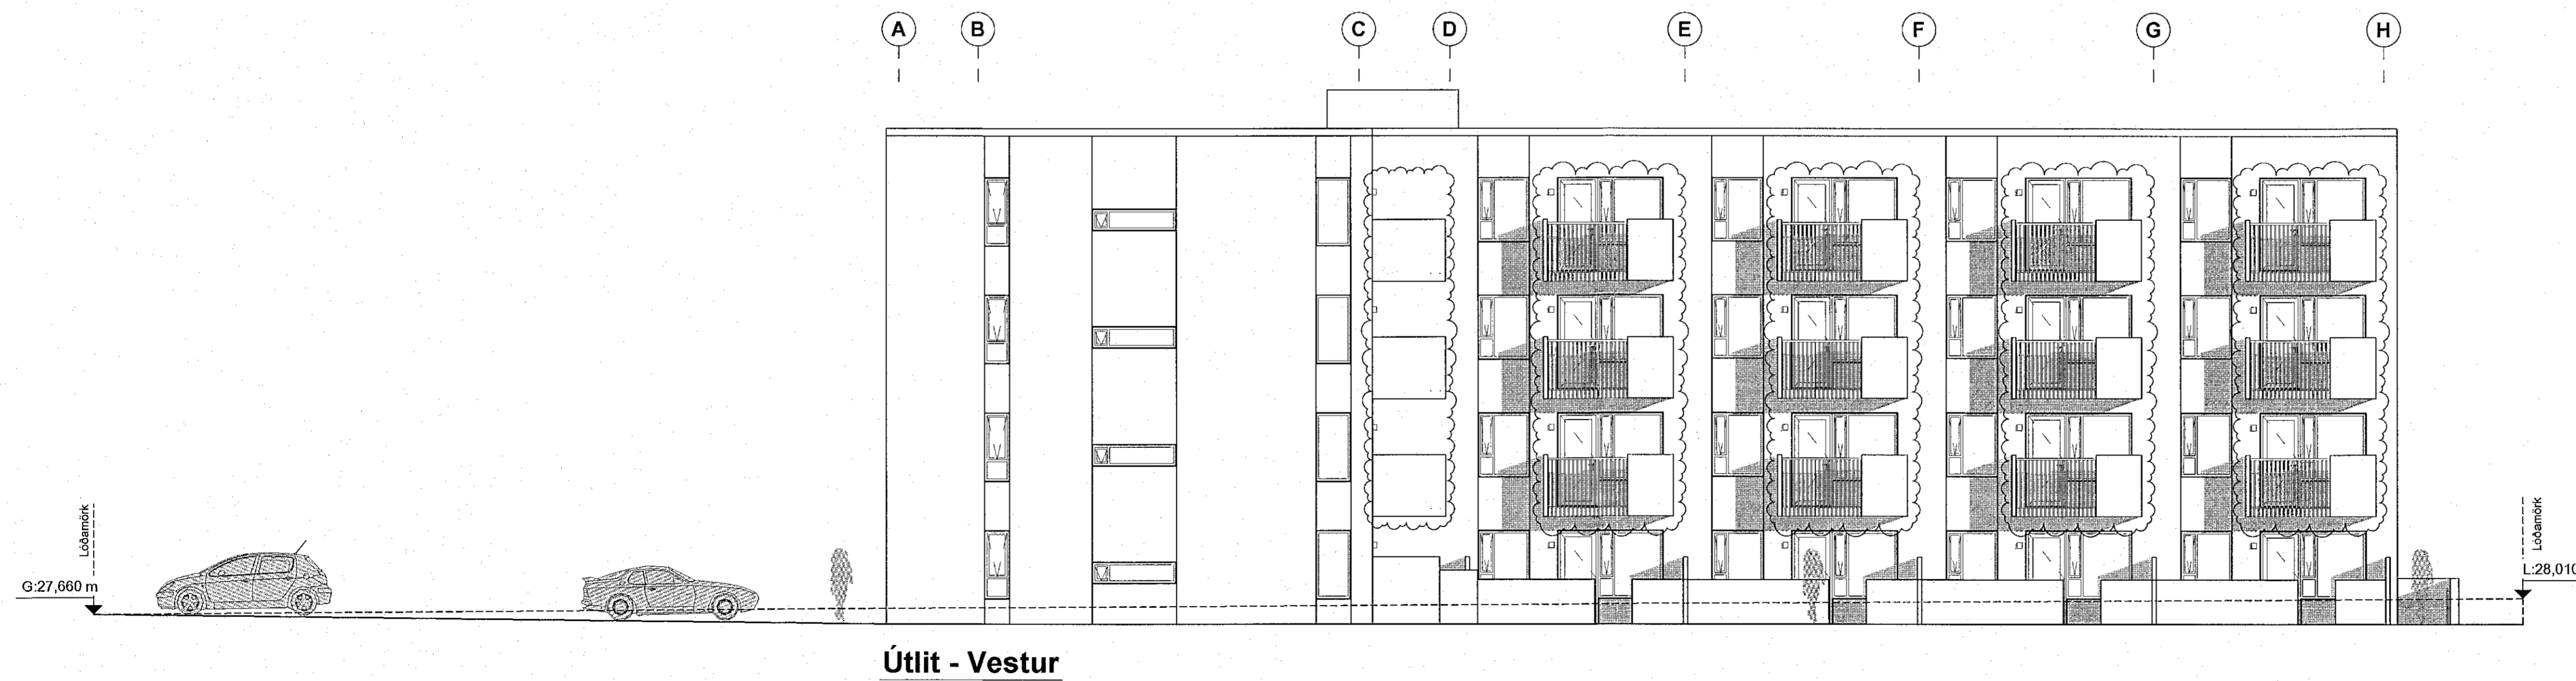


Útlit - Vestur

- B 25.10.2022 AI Svalahurðum og svólum speglað, svalaveggur hækkar
- A 19.04.2021 HI Leiðrétt v. athugas. b.fulltr.

BREYTINGAR

343 13.04.2022

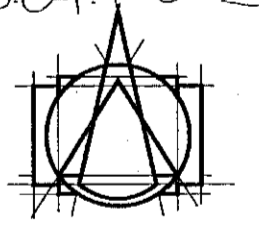

T.ark
ARKITEKTAR
HÁÚNI 2b - 105 REYKJAVÍK
SÍMI: 540 5700
tark@tark.is - www.tark.is

VERKJÓFT
Nónhamar 1-3, 221 Hafnarfj.
Fjölbýlishús, mhl 02,
Aðaluppdrættir

VERK
Útlit - Suður / Vestur

MÁL: 1 : 100
MÁLNAÐ: AA
YFIRFARÐ: ISC
VERKNÖMUR: 753-16
DAGS.: 25.03.2021
TEIKNNAÐ: H/IL
FL. TEIKNINGANÖMUR: 04
ÓTG: 1.3-02
B

SAMPR. ÁR/2021 ÁSGEIRSSON
ARKIT. MAA SAMARK KL.060101-0429