

BÚÐAHELLA

SHS
30.11.2021


HEILBRIGÐISEFTIRLIT
HAFNARFIARÐAR-
OG KÖPAVOGSSVÆÐIS
Garðatorgi 5 - 10. Garðabý
7/12 2021 *[Signature]*

VERK
DOFRAHELLA 7

TEIKNING
GRUNNMYND

VERKKAUPI
STJÓRNUSTÁL EHF

MÆLIKVARÐI: 1:100 (m.v. A1)	TEIKNING NR: 1
DAGSETNING: 15.4.2021	TEIKNAD: GÓJ

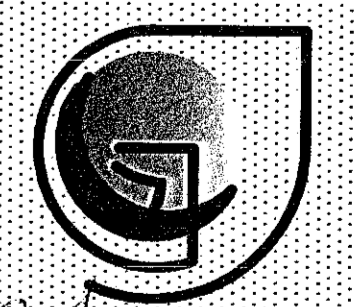

GUNNLAUGUR O. JOHNSON
Arkitekti fái
ARBÓT 270 MOSFELLSB.
KT 080657 7819
S 864 2625
E g.oj@centrum.is

GRUNNMYND

DOFRAHELLA