
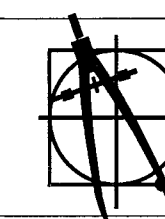
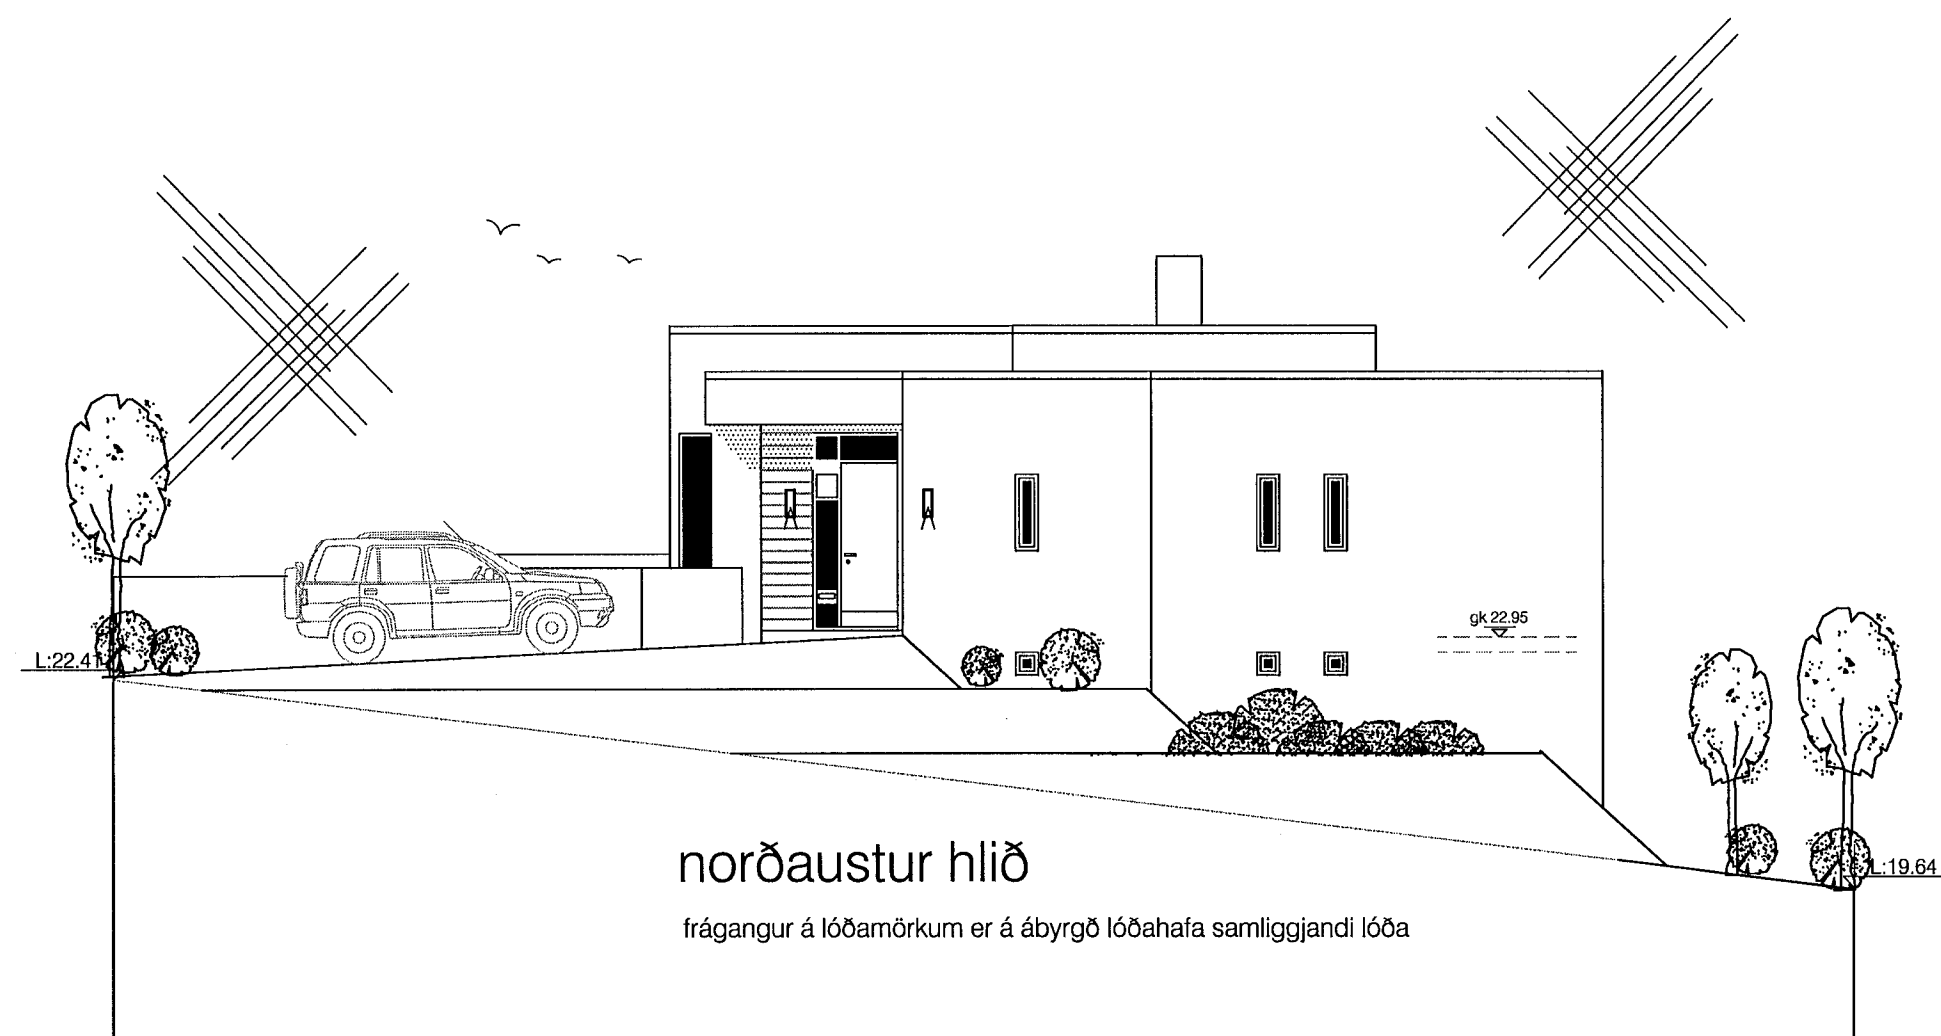


Sampykkt þann

21 MAY 2014

Byggingafultrúinn í Hafnarhóli
F.h. Sigurður Steinar Jónsson

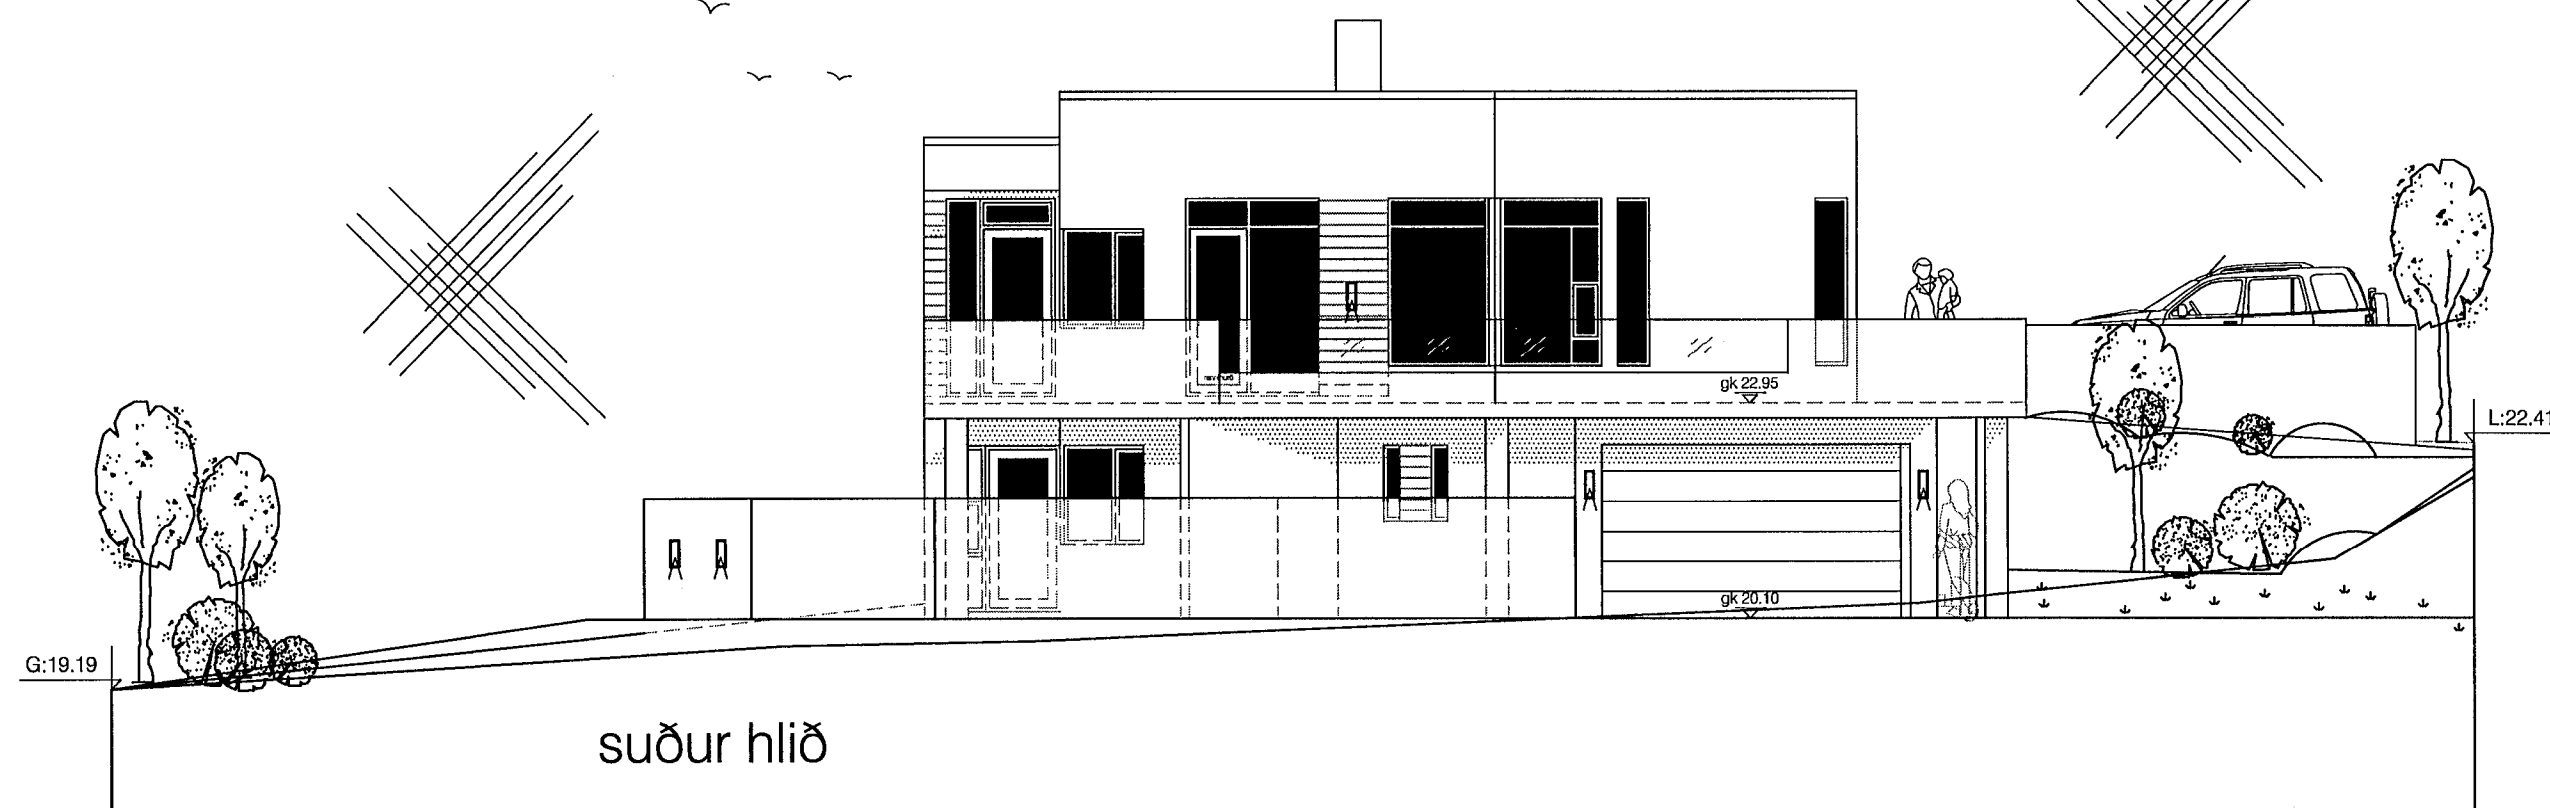

Glitberg 1

útlit

1:100
22.4. '14

04

Guðmundur Gunnlaugsson, arkitekt FAÍ
kt: 190554-3419
Archus slf, teiknistofa Stórhöfða 17.
kt: 681212-0860
110 Reykjavík. s: 5677735-8987894
gg@archus.is www.archus.is

br. 15.5.'14 - Hæðark. hækkar um 50cm.