
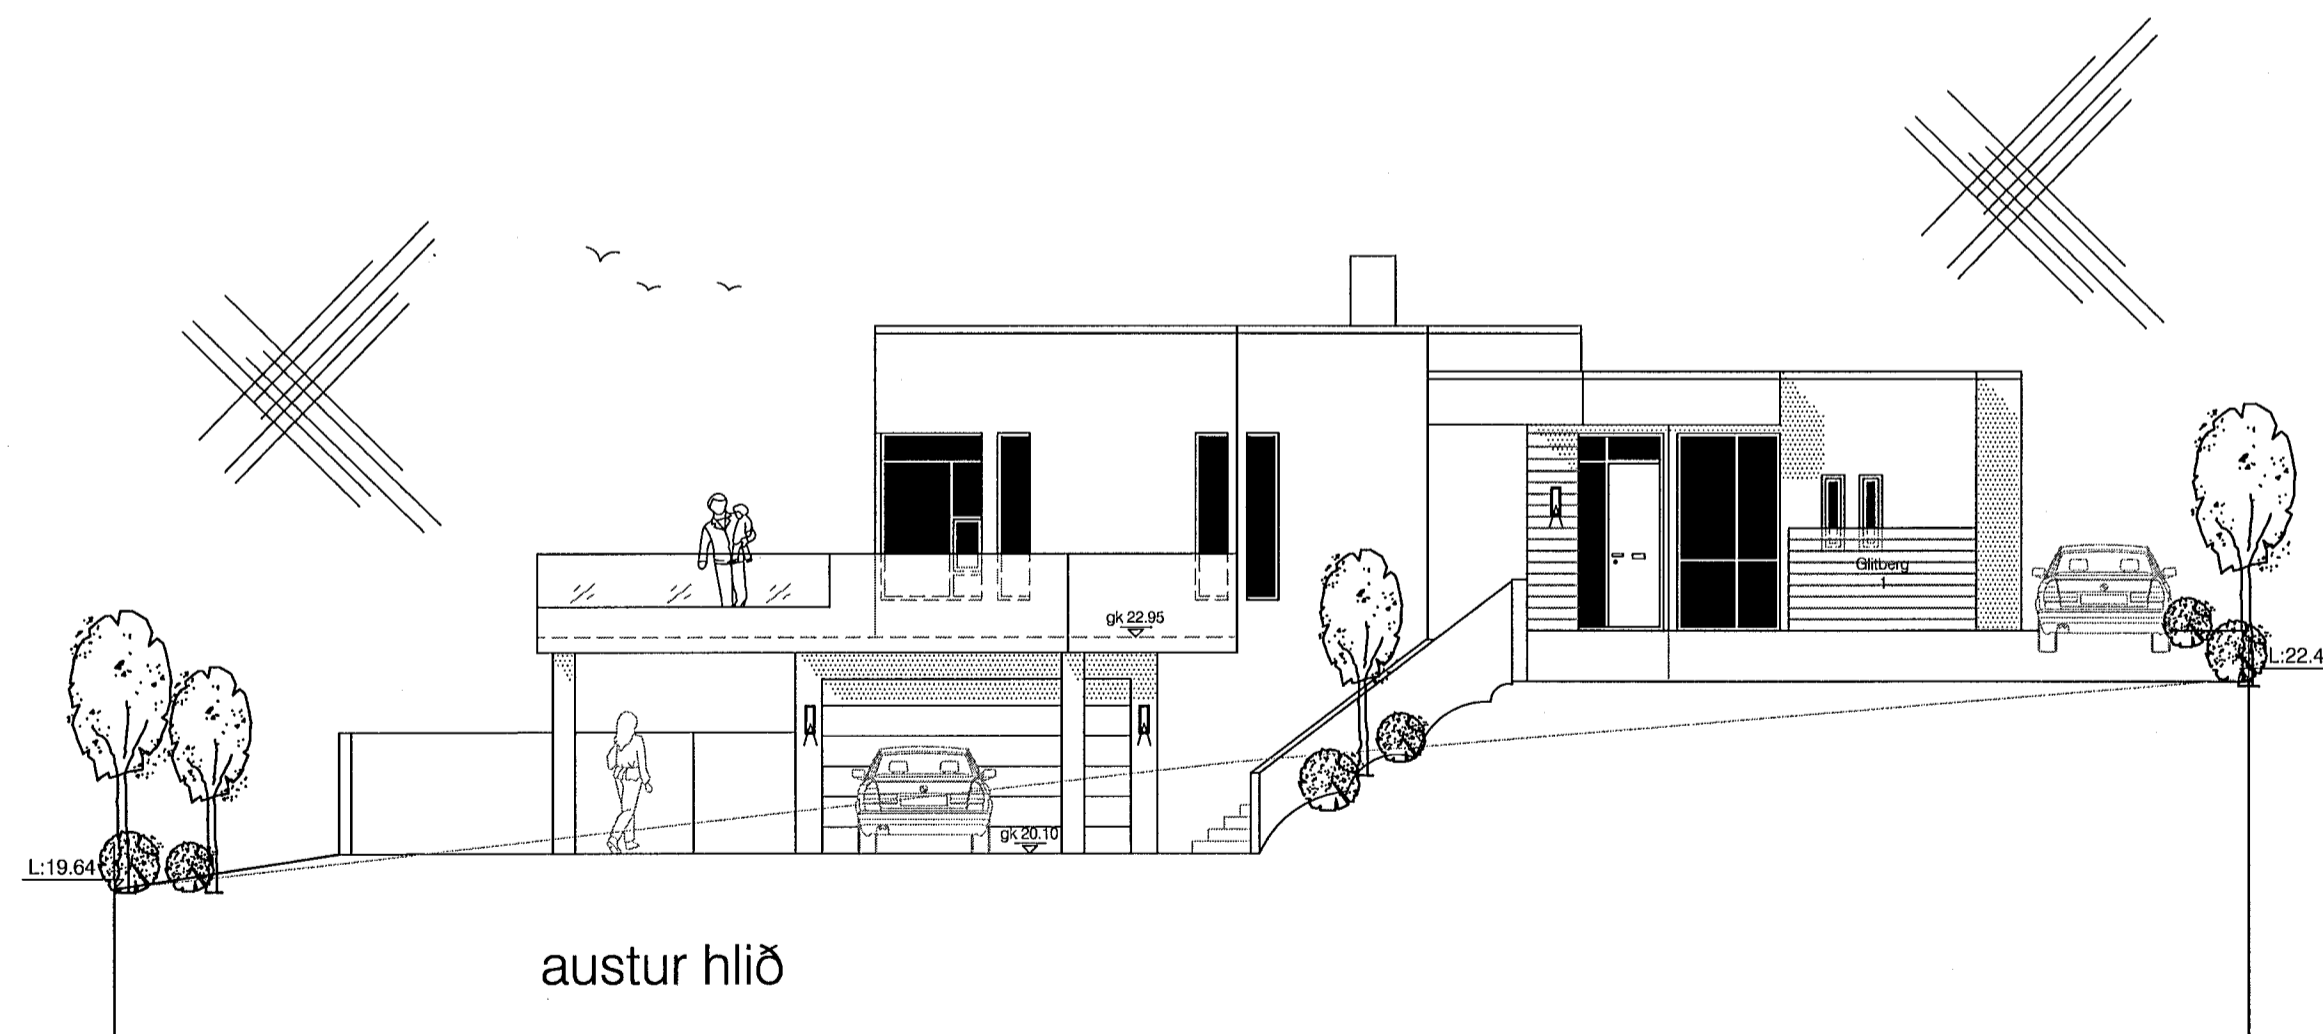


Samþykkt þann

21 MAY 2014

Byggingafulltrúinn / Hæðarfríði
F.h. Sigurður Steinar Jónsson

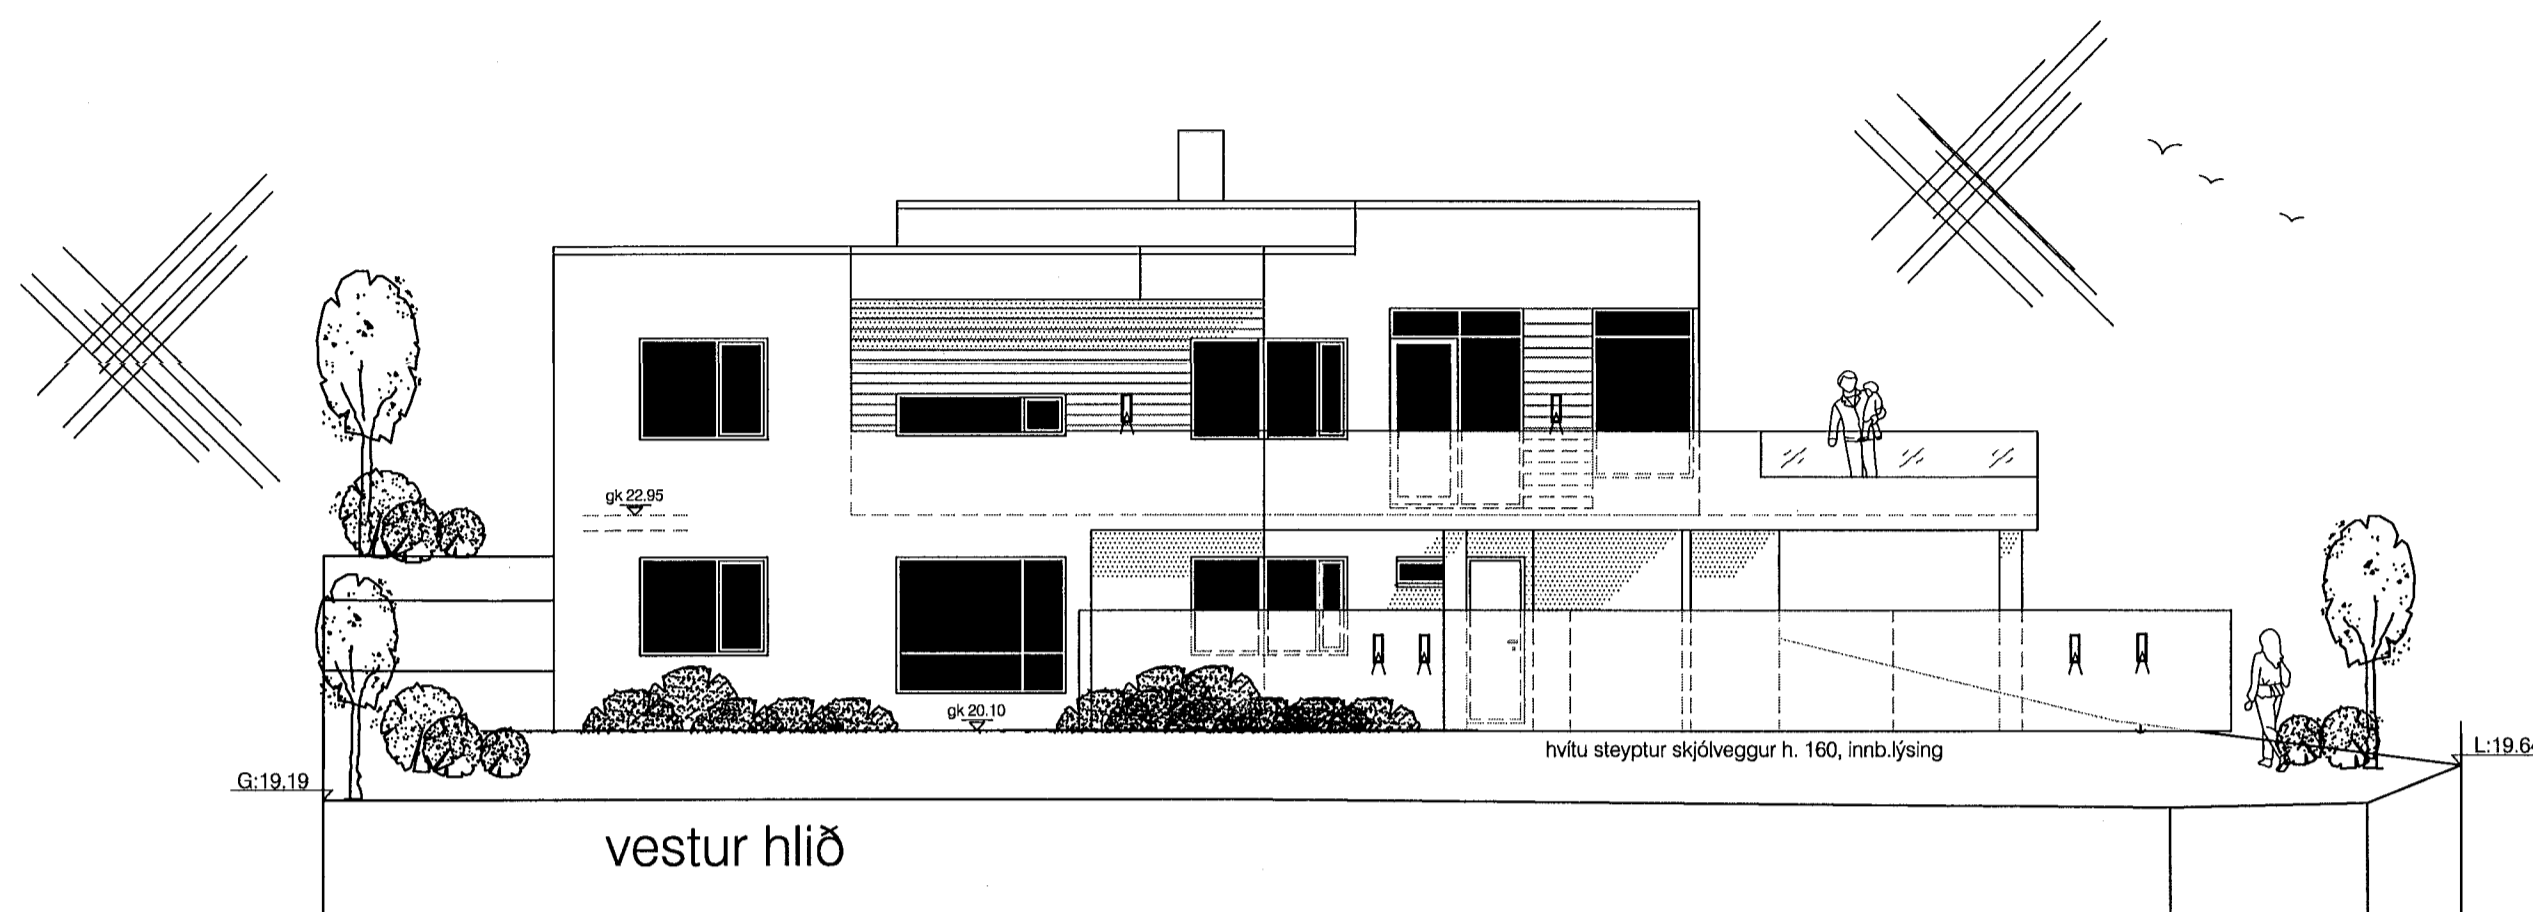

Glitberg 1
útlit

1:100
22.4.14

05

Guðmundur Gunnlaugsson, arkitekt FAÍ
kt: 190554-3419
Archus síf, teiknistofa Stórhöfða 17.
kt: 681212-0860
110 Reykjavík. s: 5677735-8987894
gg@archus.is www.archus.is

br. 15.5.14 - Hæðark. hækkar um 50cm.