


sudur

útlit

1:100


Sampviki  
28 MAÍ 2014  
Bjarki Johannesson  
Skipulags- og byggingarfulltrúi

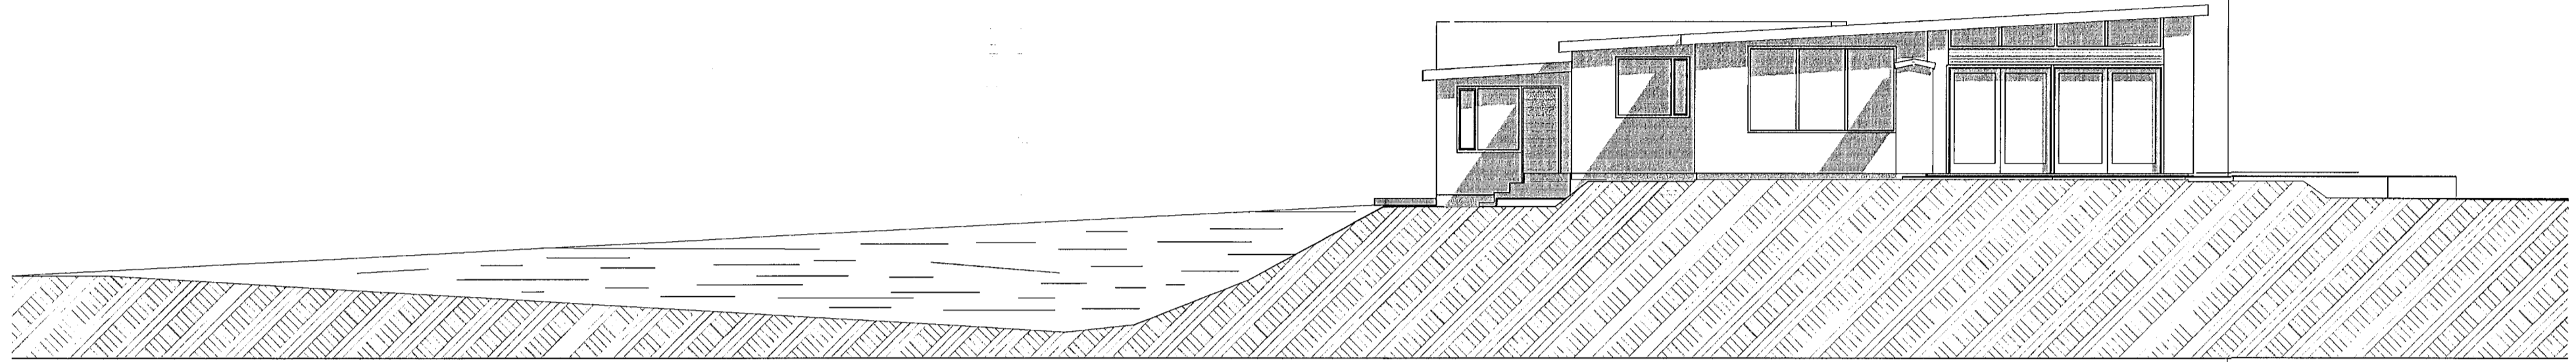

vestur

útlit


1:100

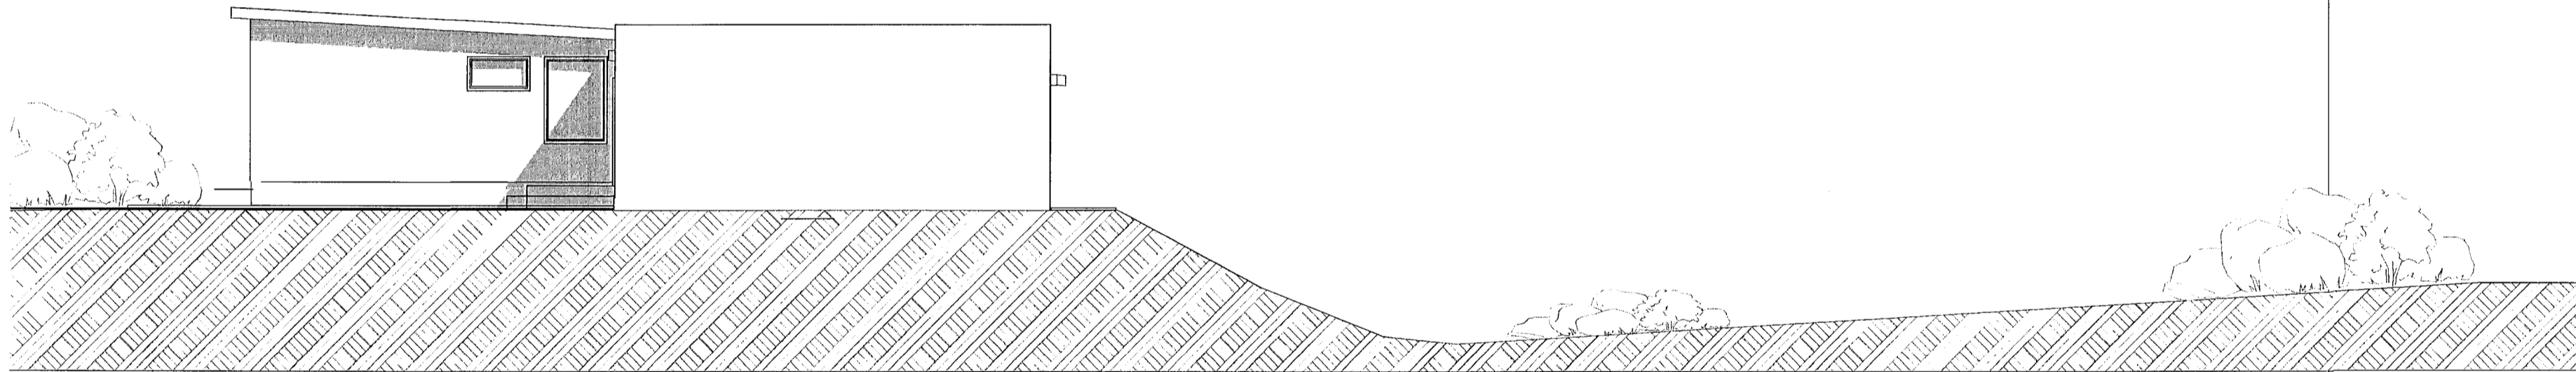

austur

útlit

1:100

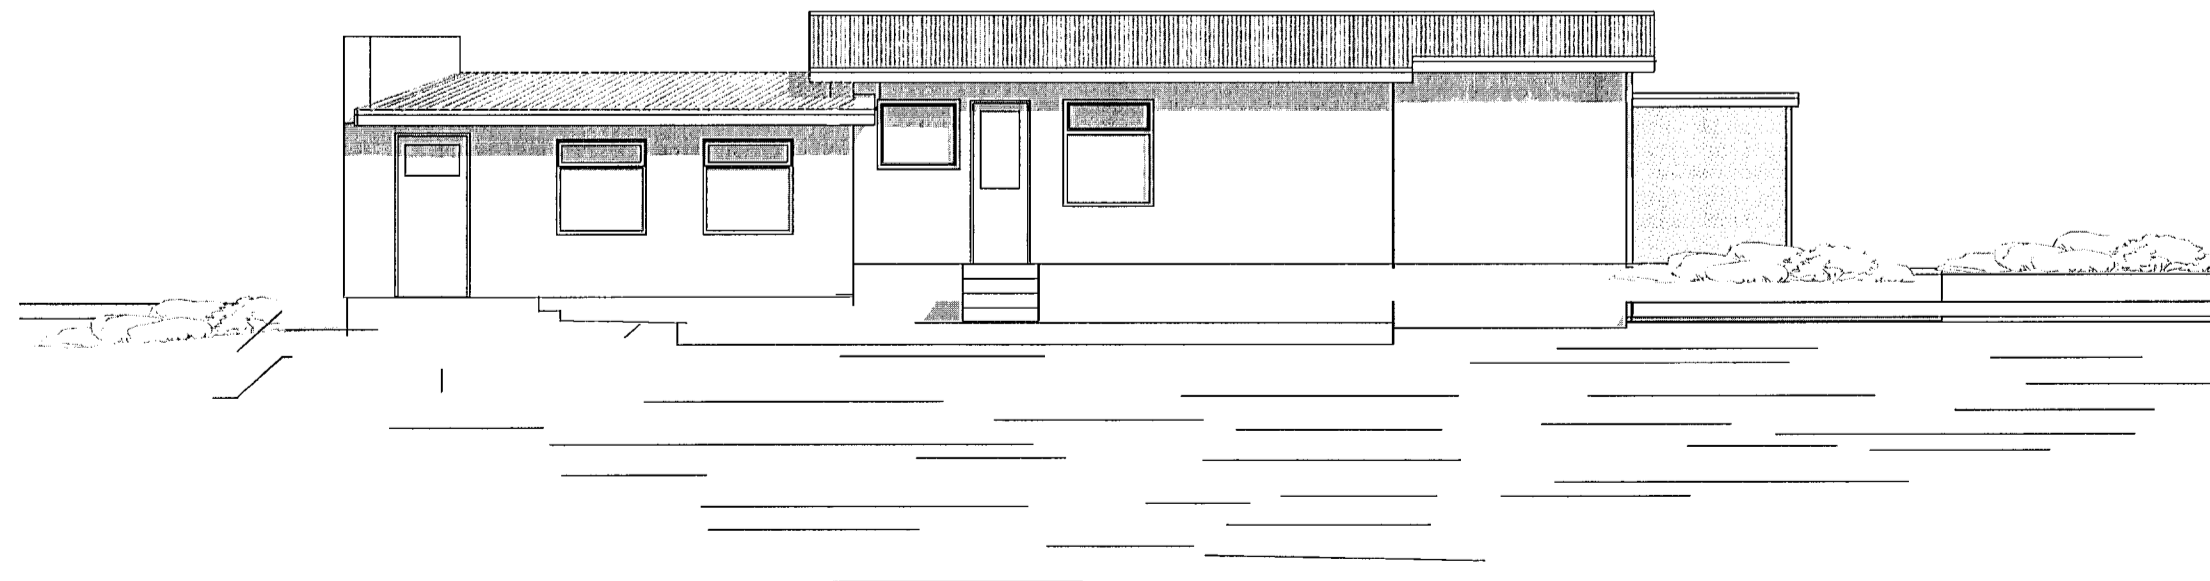

nordur

útlit

1:100

Breytt 7 maí 2014  
Frekari frágangur teikninga

TEIKNISTOFAN



Verkefni  
**ERLUHRAUN 3  
HAFNARFJÖRÐUR  
REYNDARTEIKNING**

Heiti  
**ÚTLIT  
SKRÁNINGARTAFLA**

kvarði 1:100

verk. nr 2014-02

dags. 15. APRÍL. 2014

dags br. 07. MAÍ 2014

hönnun G. G.

teikn. nr

teikn G. G.

**A-3**

Hringbraut 17 220 Hafnarfirdi  
s. 555-2020 FAX 555-2021  
Gísli G. Gunnarsson BFI kt. 020649-2409  
kvardi@kvardi.is