





Samþykkt þann

30 JAN 2008

Byggingafræðingur í Hafnarfirði
F.h. Jón Sigurðsson

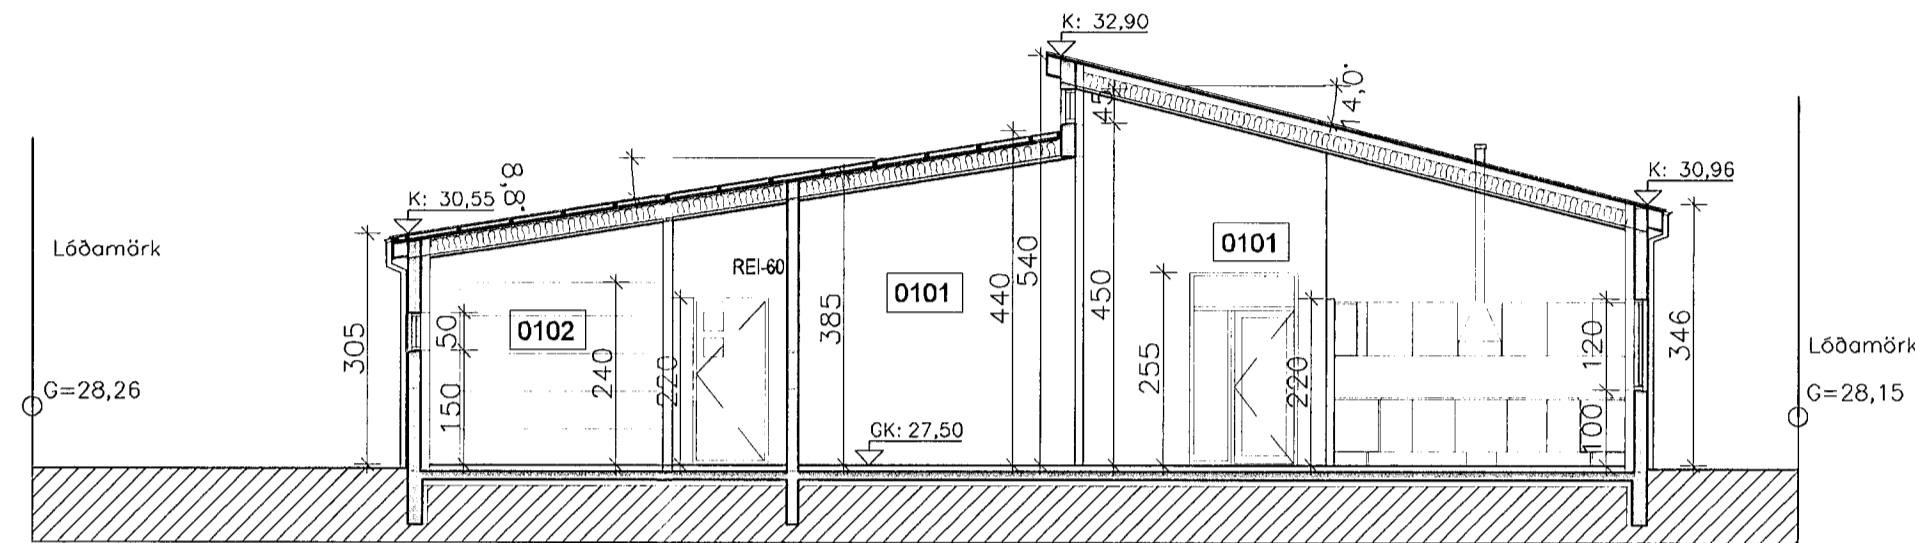

A-A' SNID
01 1:100

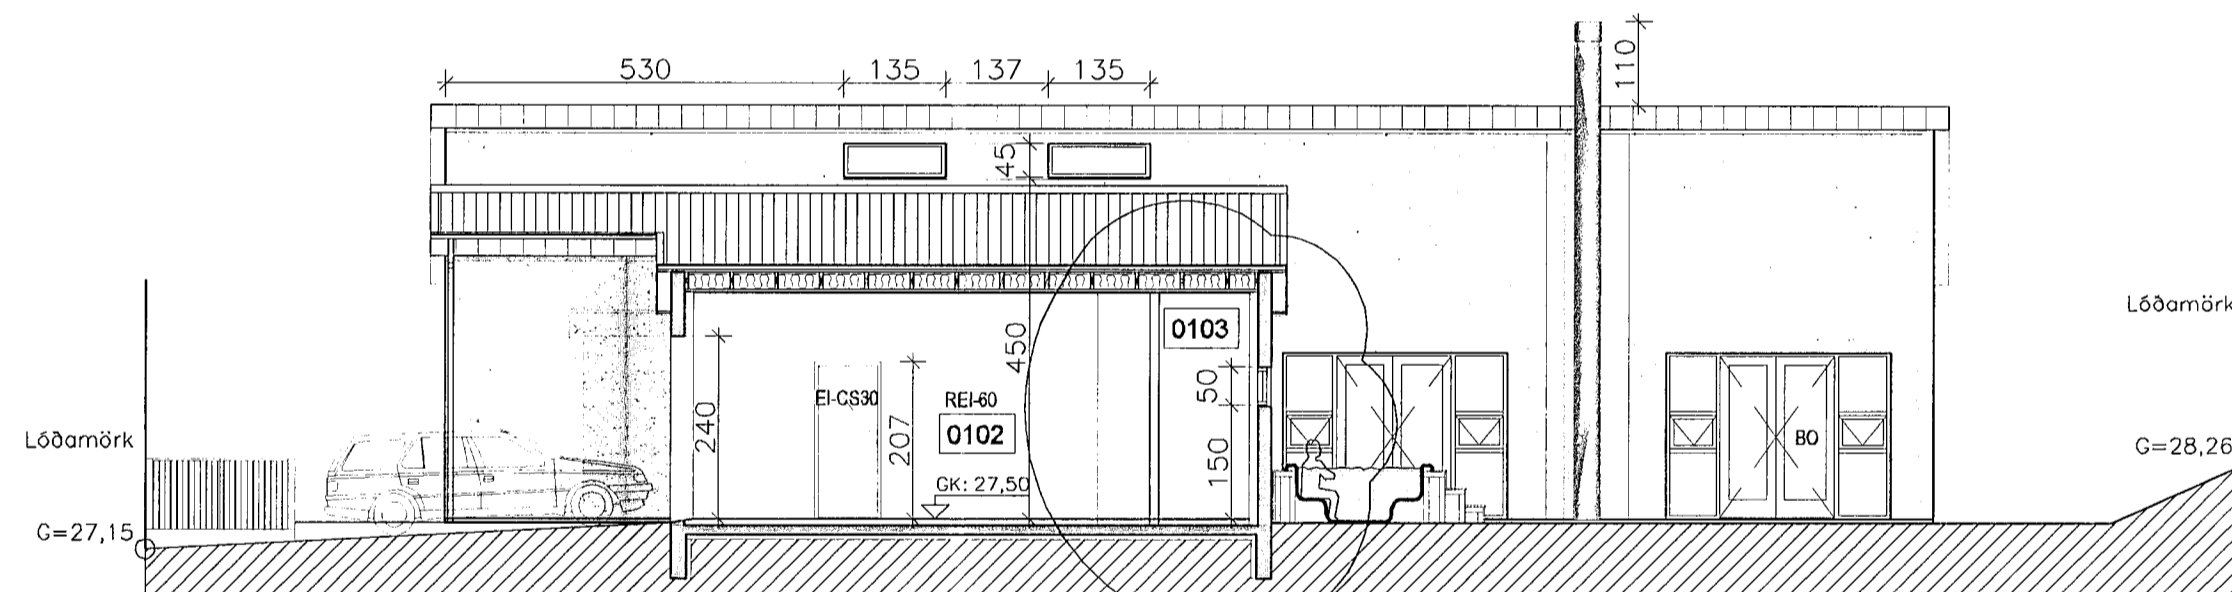

B-B' SNID
01 1:100

BREYTT				
1) 14.01.08 Breyting á innra skipul. og skráningu. DK				
HEITI VERKS:				
Hafravellir 11				
HEITI VERKS:				
221, Hafnarfjörður				
HEITI TEIKNINGAR:				KVAFORÐ:
SNEIDING A-A' OG B-B'				1:100
HANSAD:	TEIKNAD:	VERKNR:	BREYTINGNR:	DAGSL:
DKK	DKK	1.109	01	13.12.2006
SAMÞRÖKT:				TEIKN. NR:
				02
TEIKNISTOFAN H.R. ehf				
Húsbýggingar og ráðgjöf				
Davíð Karl Karlsson				
Byggingafræðingur BFI				
Næfurás 2, 110 Reykjavík				
			SÍMI & FAX: 517 3640	
			GSM: 694 3029	
			E-MAIL: dkk@internet.is	
			KT: 231256-2539	