
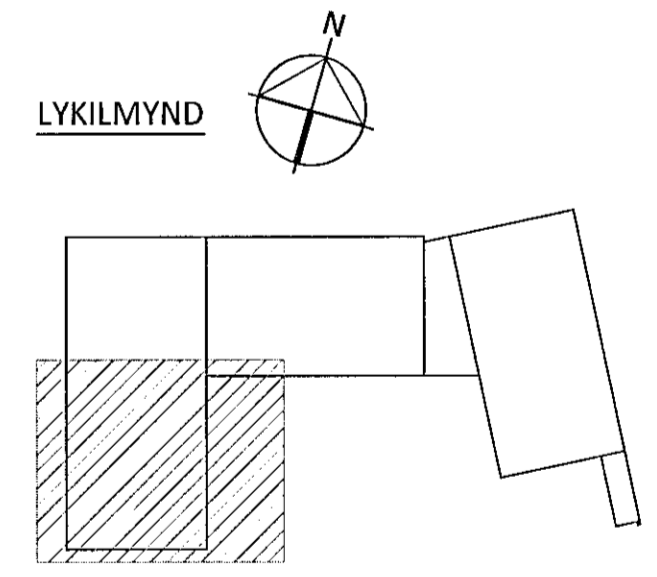


1. HÆÐ - RÚMMYND M1:50

ÁRIFUN BYGGINGARFULLTRÚA

Sambýkt þann  
 01 AUG 2014  
 Byggingafulltrúinn í Hafnarfirði  
 F.h. Sigurður Steinar Jónsson

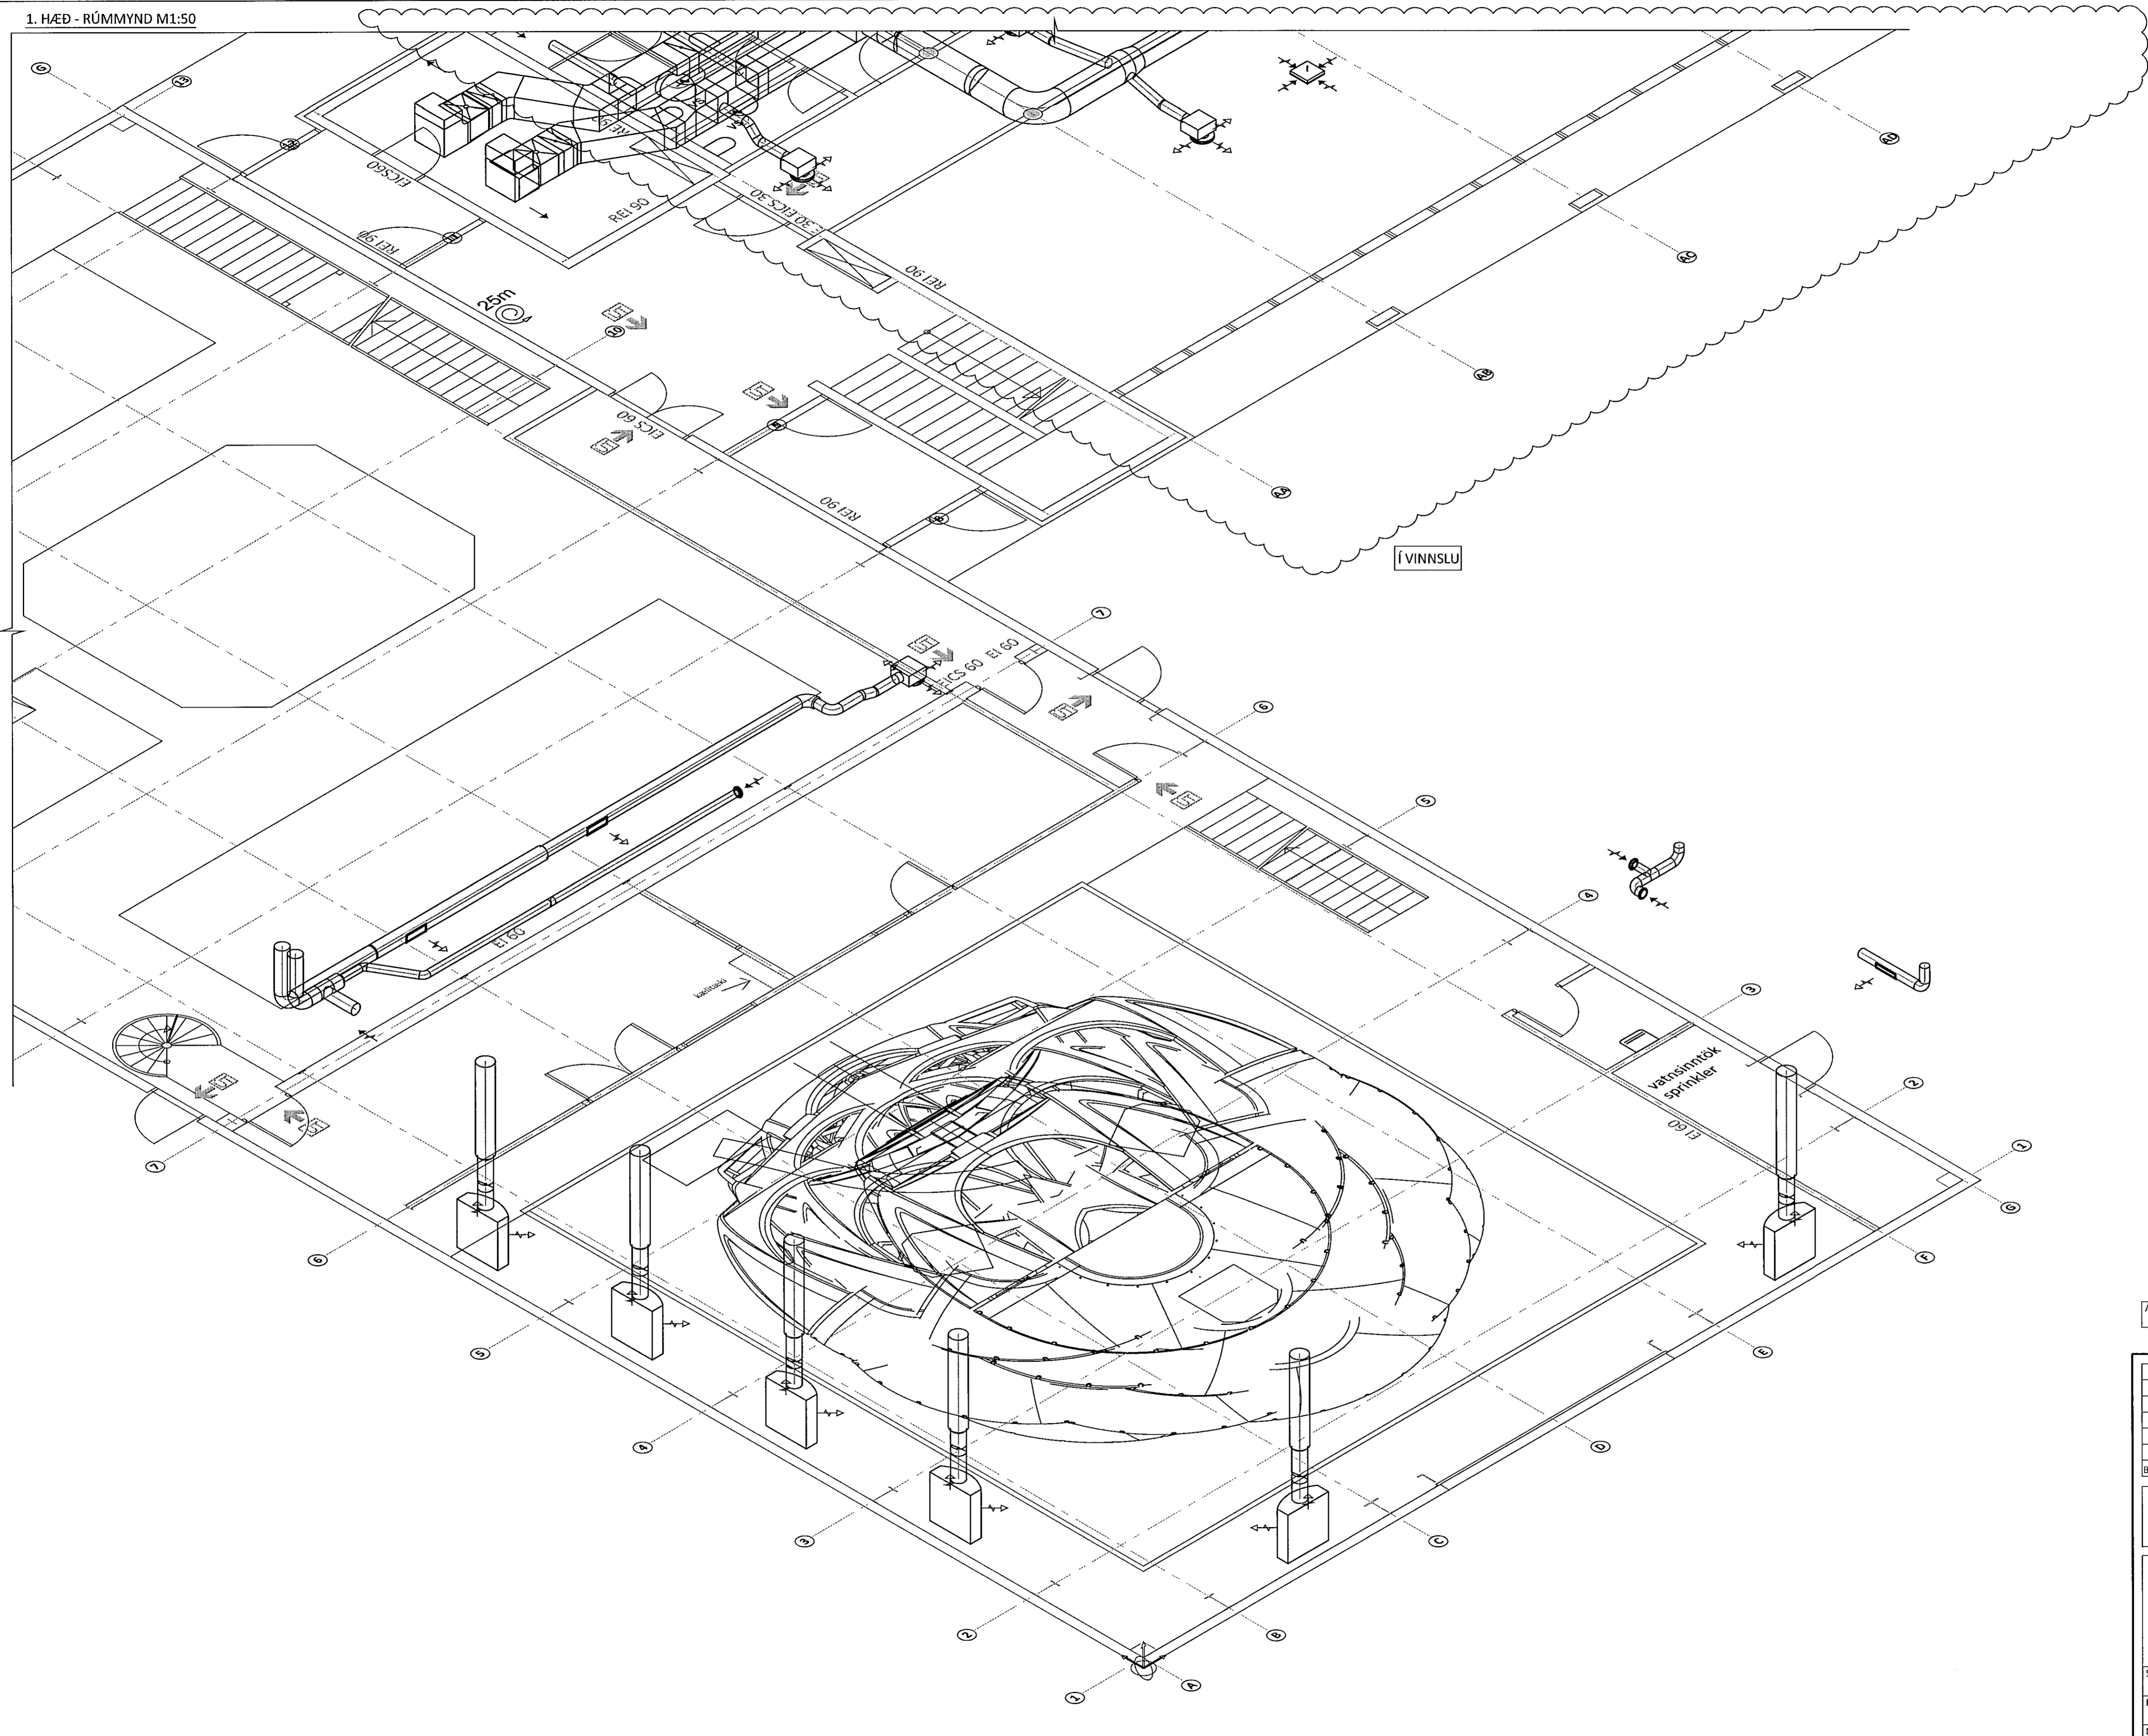

ÁRIFUN ADALHÖNDUÐAR: *[Signature]* KT. 040251-3019

BR.	DAGS.	BREYTING	SAMP.



FLUGVELLIR 1 HAFNARFIRÐI  
 NÝBYGGING  
 LOFTRÆSING  
 1. HÆÐ  
 RÚMMYND

SAMPYKKT: <i>[Signature]</i> KT. 010345-4059	SMB.
HÖNNUÐUR: ERV elnar@ferill.is	YFIRFARIÐ: ÞAG
MKV. 1:50	VERKNR. 14014
	TEKNI. NR. 5 - 1112
	BREYTI.

Ferill ehf. Mörkin 1 108 Reykjavík Sími: 575 1600 Fax: 575 1601 www.ferill.is