
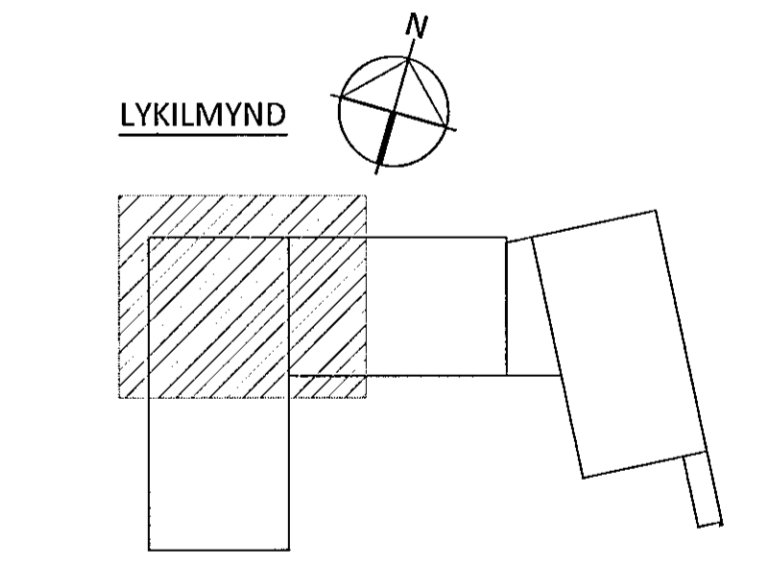


ARITUN BYGGINGARFULLTRÚA

Samþykkt þann
 01 AUG 2014
 Þingf. safulltrúinn í Hafnarfirði
 F.v. Sigurður Steinar Jónsson

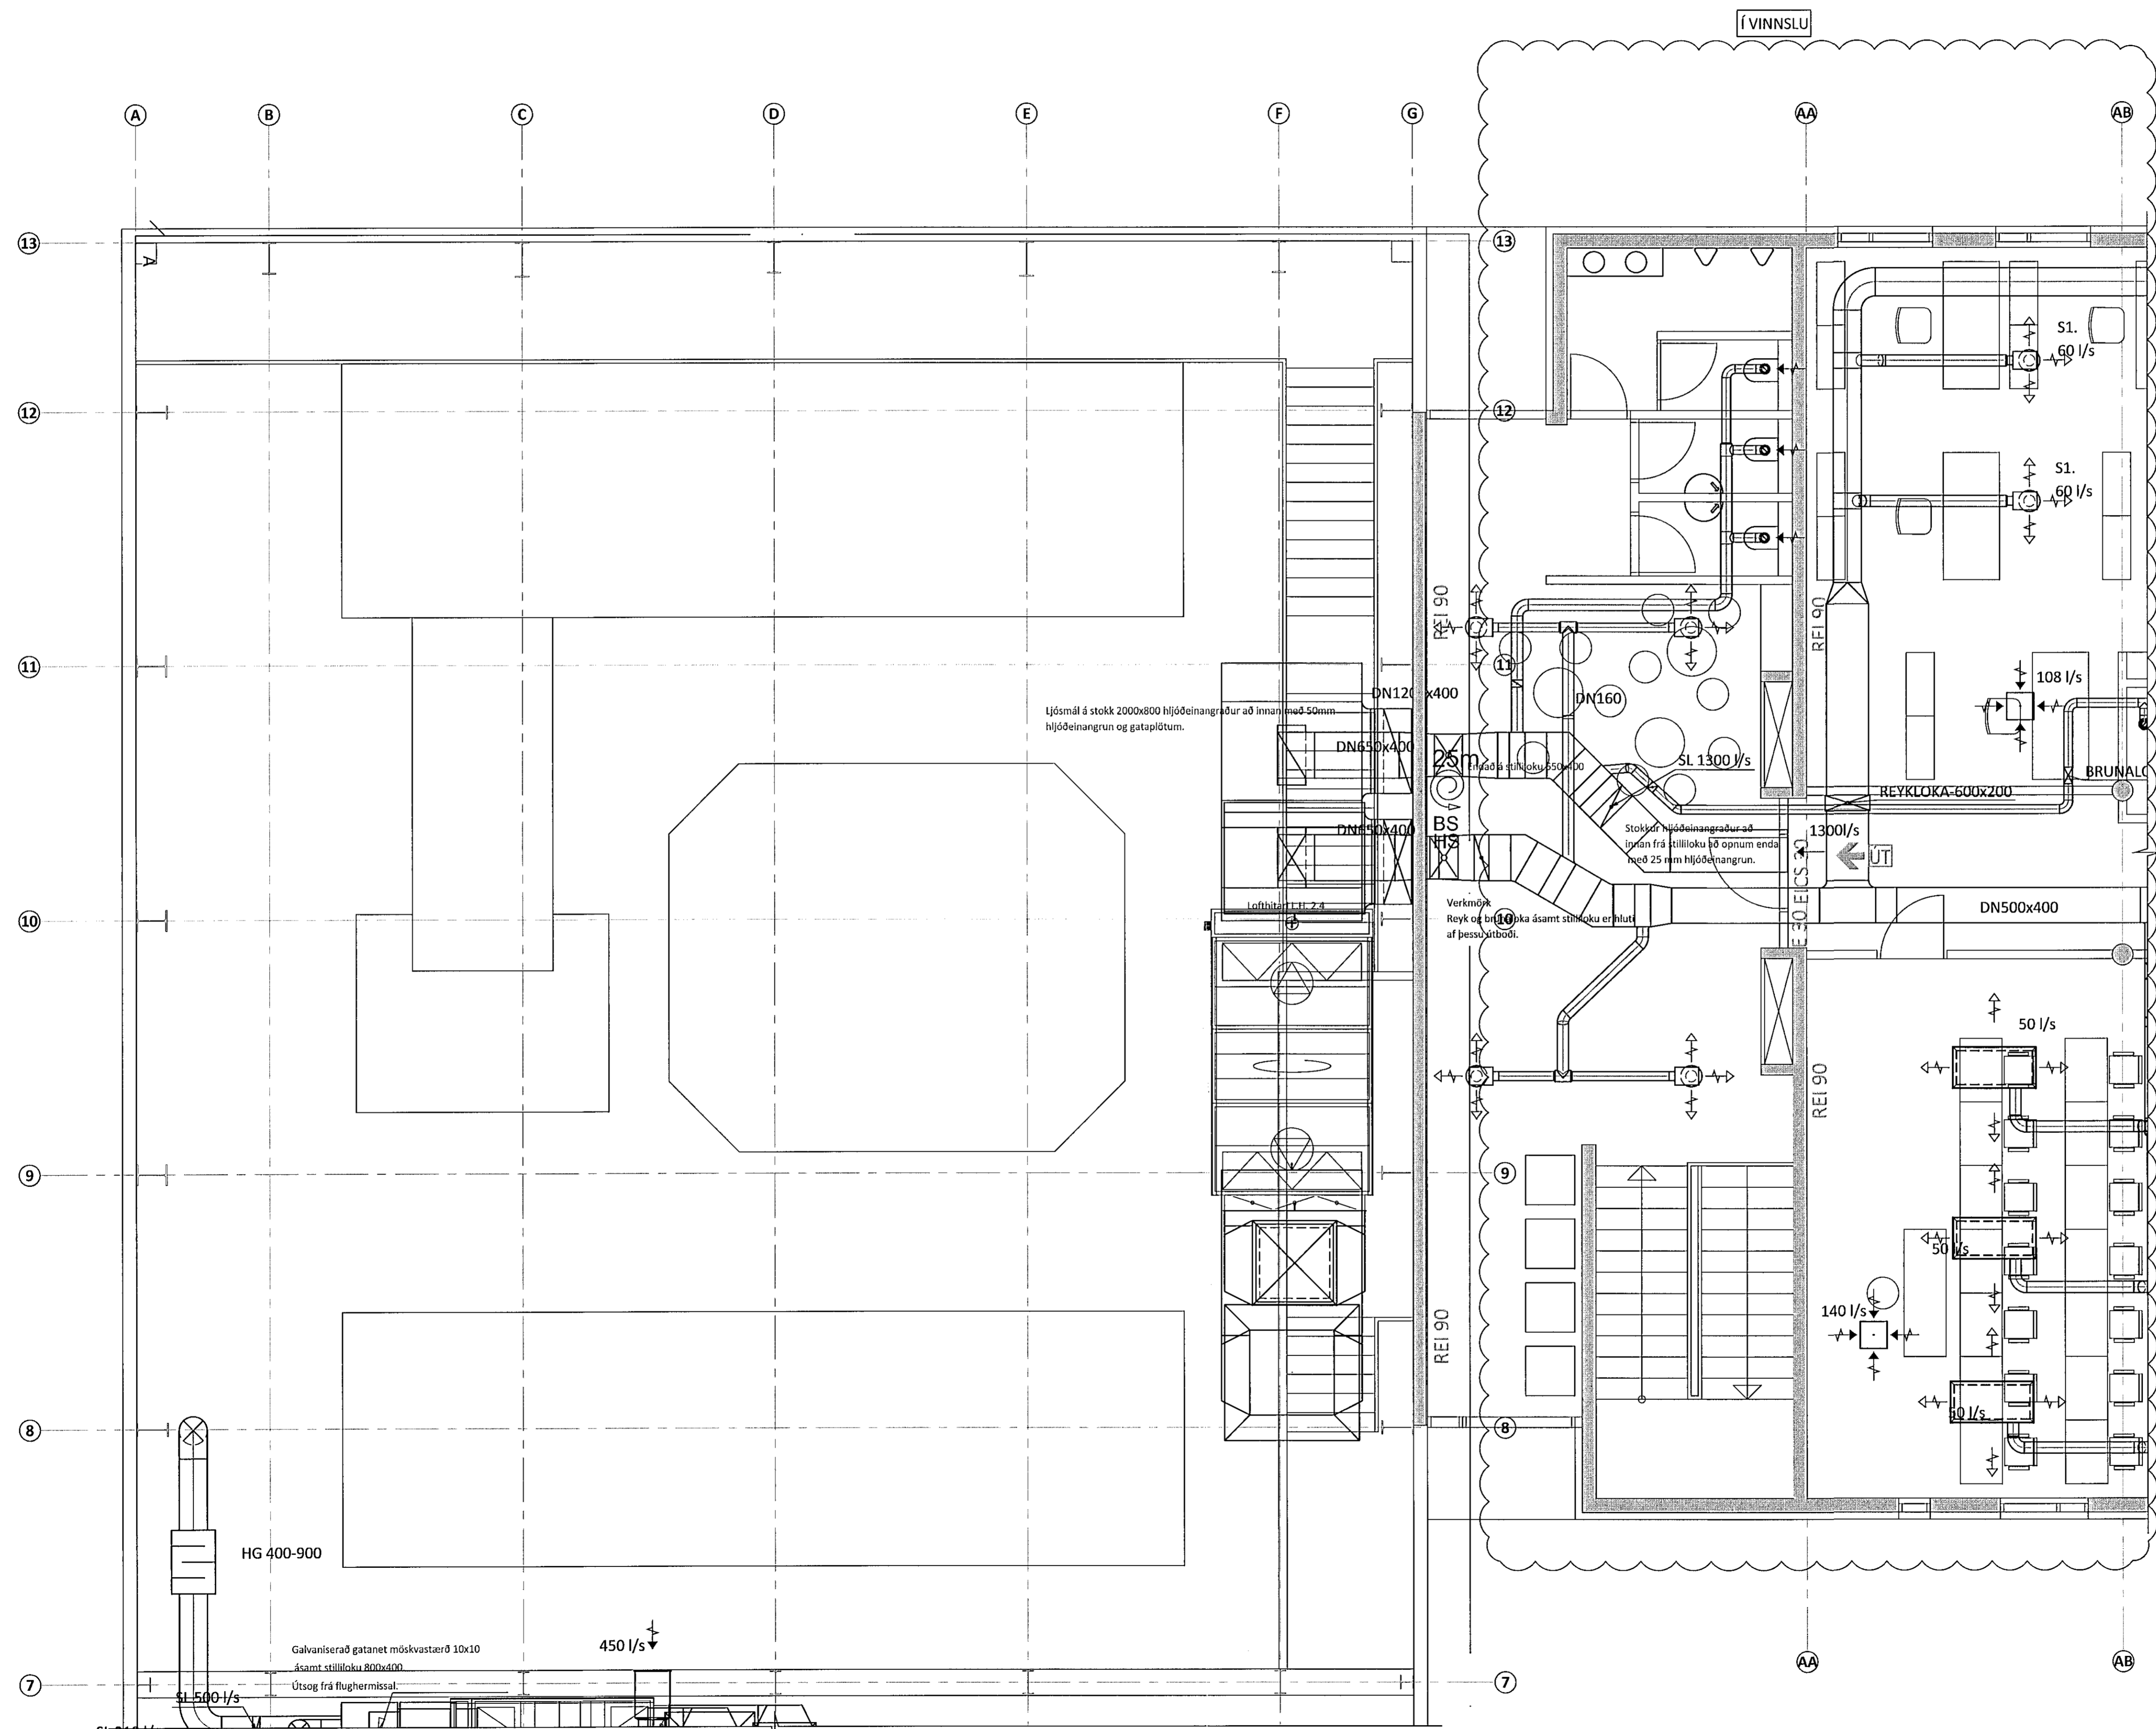

ARITUN ADALHÖNDUÐAR KT. 01231-2019

ferill
 VERKFRÆÐISTOFA

FLUGVELLIR 1		HAFNARFIRÐI	
NÝBYGGING			
LOFTRÆSING			
3. HÆÐ			
GRUNNMYND			
SAMPYKKT		KT. 010345-4059	
HÖNNUÐUR	VERIFARID	DAGS. ÚTG.	DAGS. BREYT.
ERV einar@ferill.is	PAG	21.07.14	
MKV. 1:50	VERKNR. 14014	TEKN. NR. 5-1301	BREYT.