
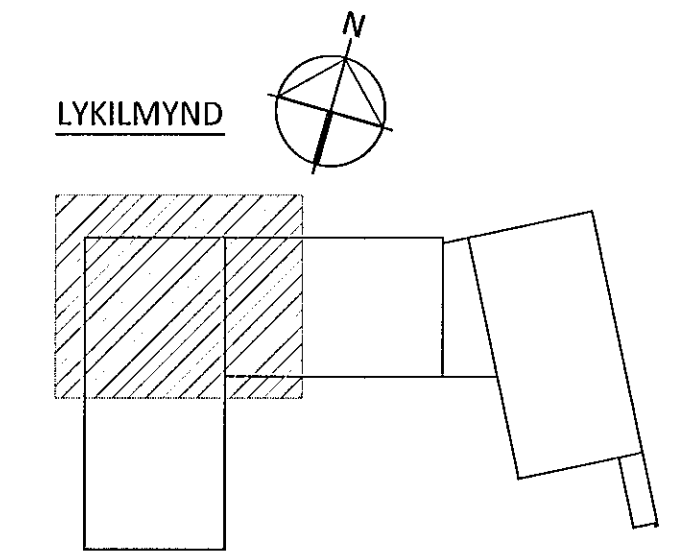


Samþykkt þann
01 AUG 2014
Byggingafultrúinn / Hafnarfirdi
F.h. Sigurður Steinar Jónsson

3. HÆÐ - RÚMMYND M1:50

VIÐVINSLU

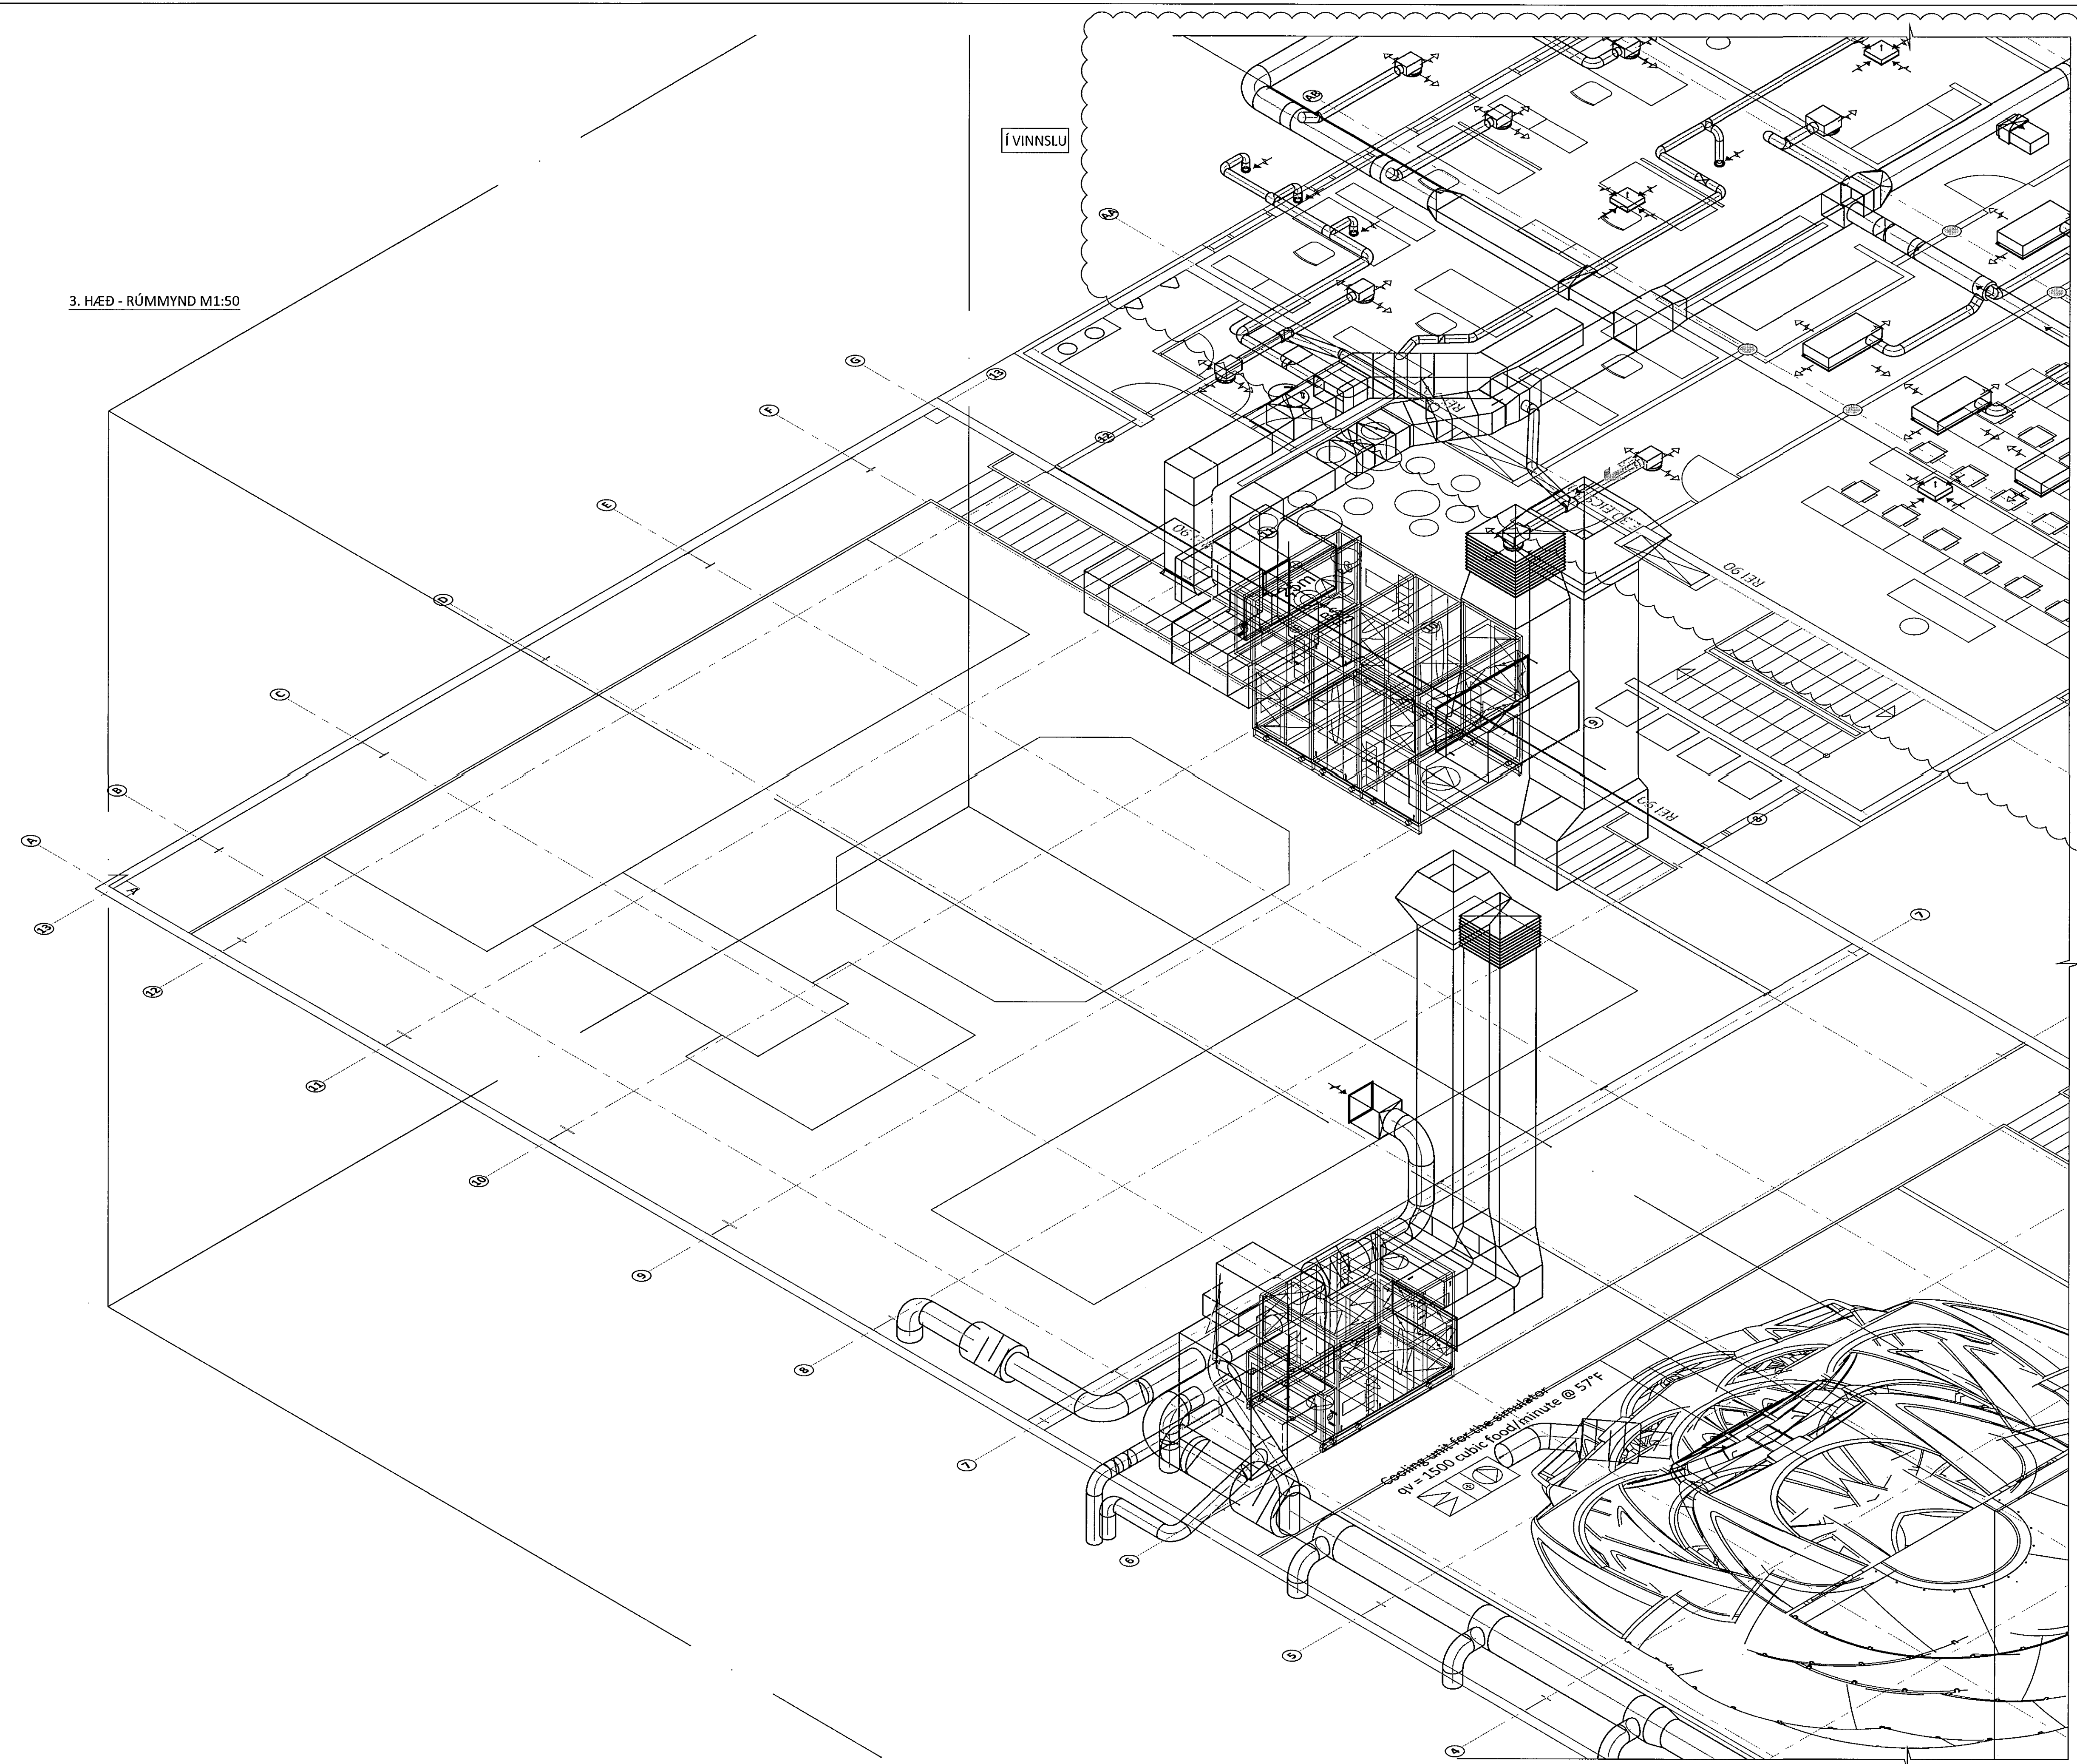

ÁRITUNARÁÐGJAFAR: *[Signature]* KT. 04251-3019

BR.	DAGS.	BREYTING	SAMP.

ferill
VERKFRÆÐISTOFA

FLUGVELLIR 1 HAFNARFIRDI
NÝBYGGING

LOFTRÆSING
3. HÆÐ
RÚMMYND

SAMÞYKKT: *[Signature]* KT. 010345-4059 *[Signature]*

HÖNNUÐUR ERV	YFIRFARID ÞAG	DAGS. ÚTG. 21.07.14	DAGS. BREYT.
MKV. 1:50	VERKNR. 14014	TEIKN. NR. 5 - 1311	BREYT.

Ferill ehf. Mörkin 1 108 Reykjavík Sími: 575 1600 Fax: 575 1601 www.ferill.is