


RVK.VEGUR 78
BYGGING E
Matsalur Mhl 01

RVK.VEGUR 78
BYGGING E
Verksm. Mhl 02

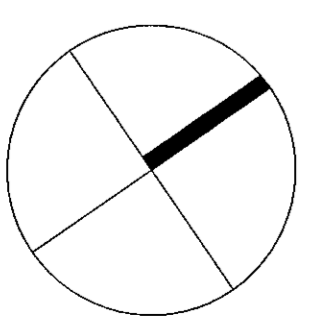

C:
B:
A: Breytt í millilager 05.05.15
BREYTINGAR: DAGS:



REYKJAVÍKURVEGUR 78 og 80 (Bygging R)
Mhl 01 og mhl 06
VERK: ACTA 1318
KVARDI: 1:100
DAGS: 05.05.14
TEIKN: BOS
1.HÆÐ SKRÁ: Grunnur.dwg

ÚTI INNI
ARKITEKTAR

ÞINGHOLTSTRÆTI 27 101 REYKJAVÍK
SÍMAR 552 7660 & 552 7660 FAX 552 7661
NETFANG: u@inni.com.is
VEFFANG: www.inni.com.is
BALDUR Ó. SVAVARSSON ARKITEKTAR FAL
120357-5149
JÓN ÞÓR ÞORVALDSSON ARKITEKTAR FAL
021256-7579

