




Samþykkt þann

15 MAY 2014

Byggingafulltrúinn í Hafnarborg  
F.h. Sigurður Steinar Jónsson

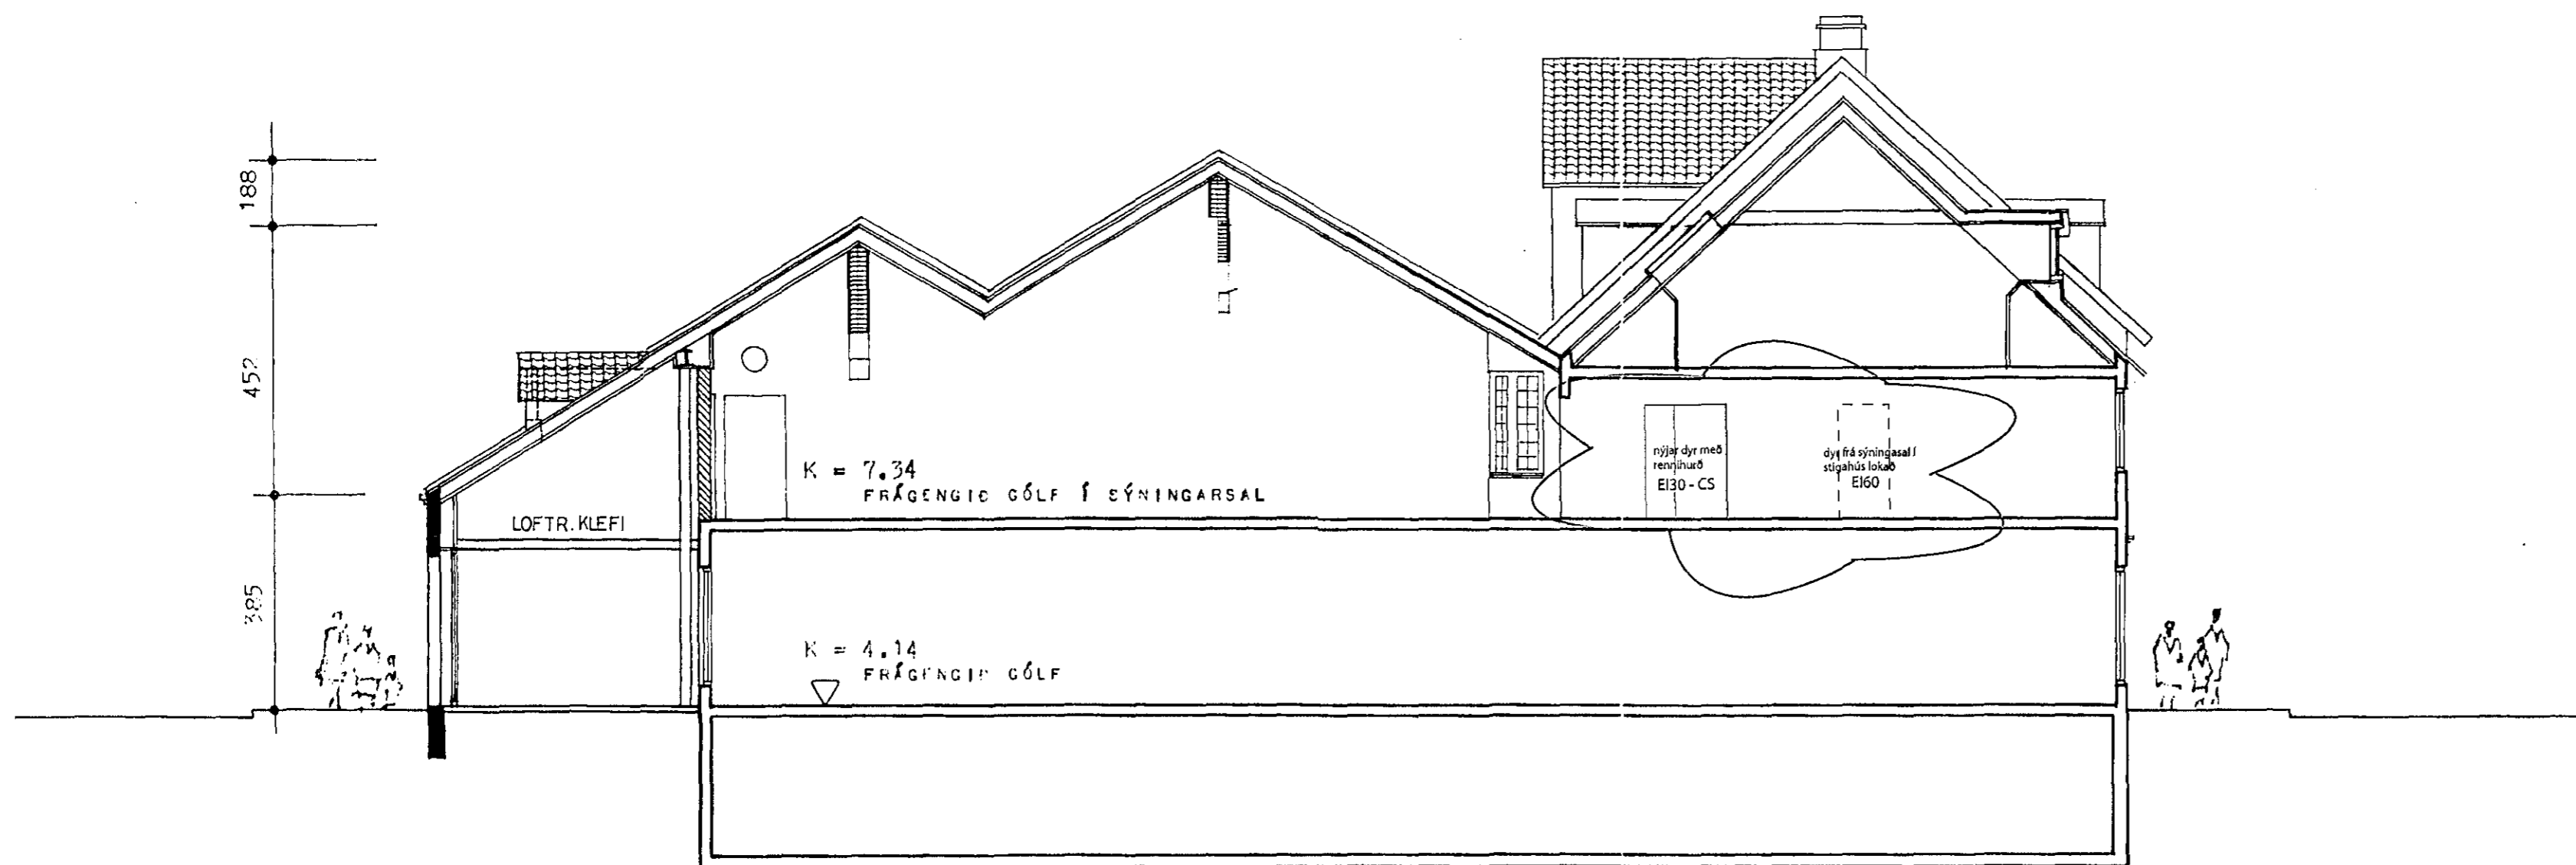

SNEIDING AA

PK

**HAFNARBORG**  
Sneiðing AA

VERKHLUTI:  
Aðaluppdráttur - BNF

**PK - ARKITEKTAR**  
Pálmar Kristmundsson, kennitala: 080455-5269  
Þórunnartúni 2, 105 Reykjavík, Ísland.  
Sími: 5518050 Fax: 551 8077 Netfang: pk@pk.is www.pk.is

VERK NR.:	1088
DAGS.:	05.05.2014
MKV.:	1/100

TEIKNING NR.: 03