
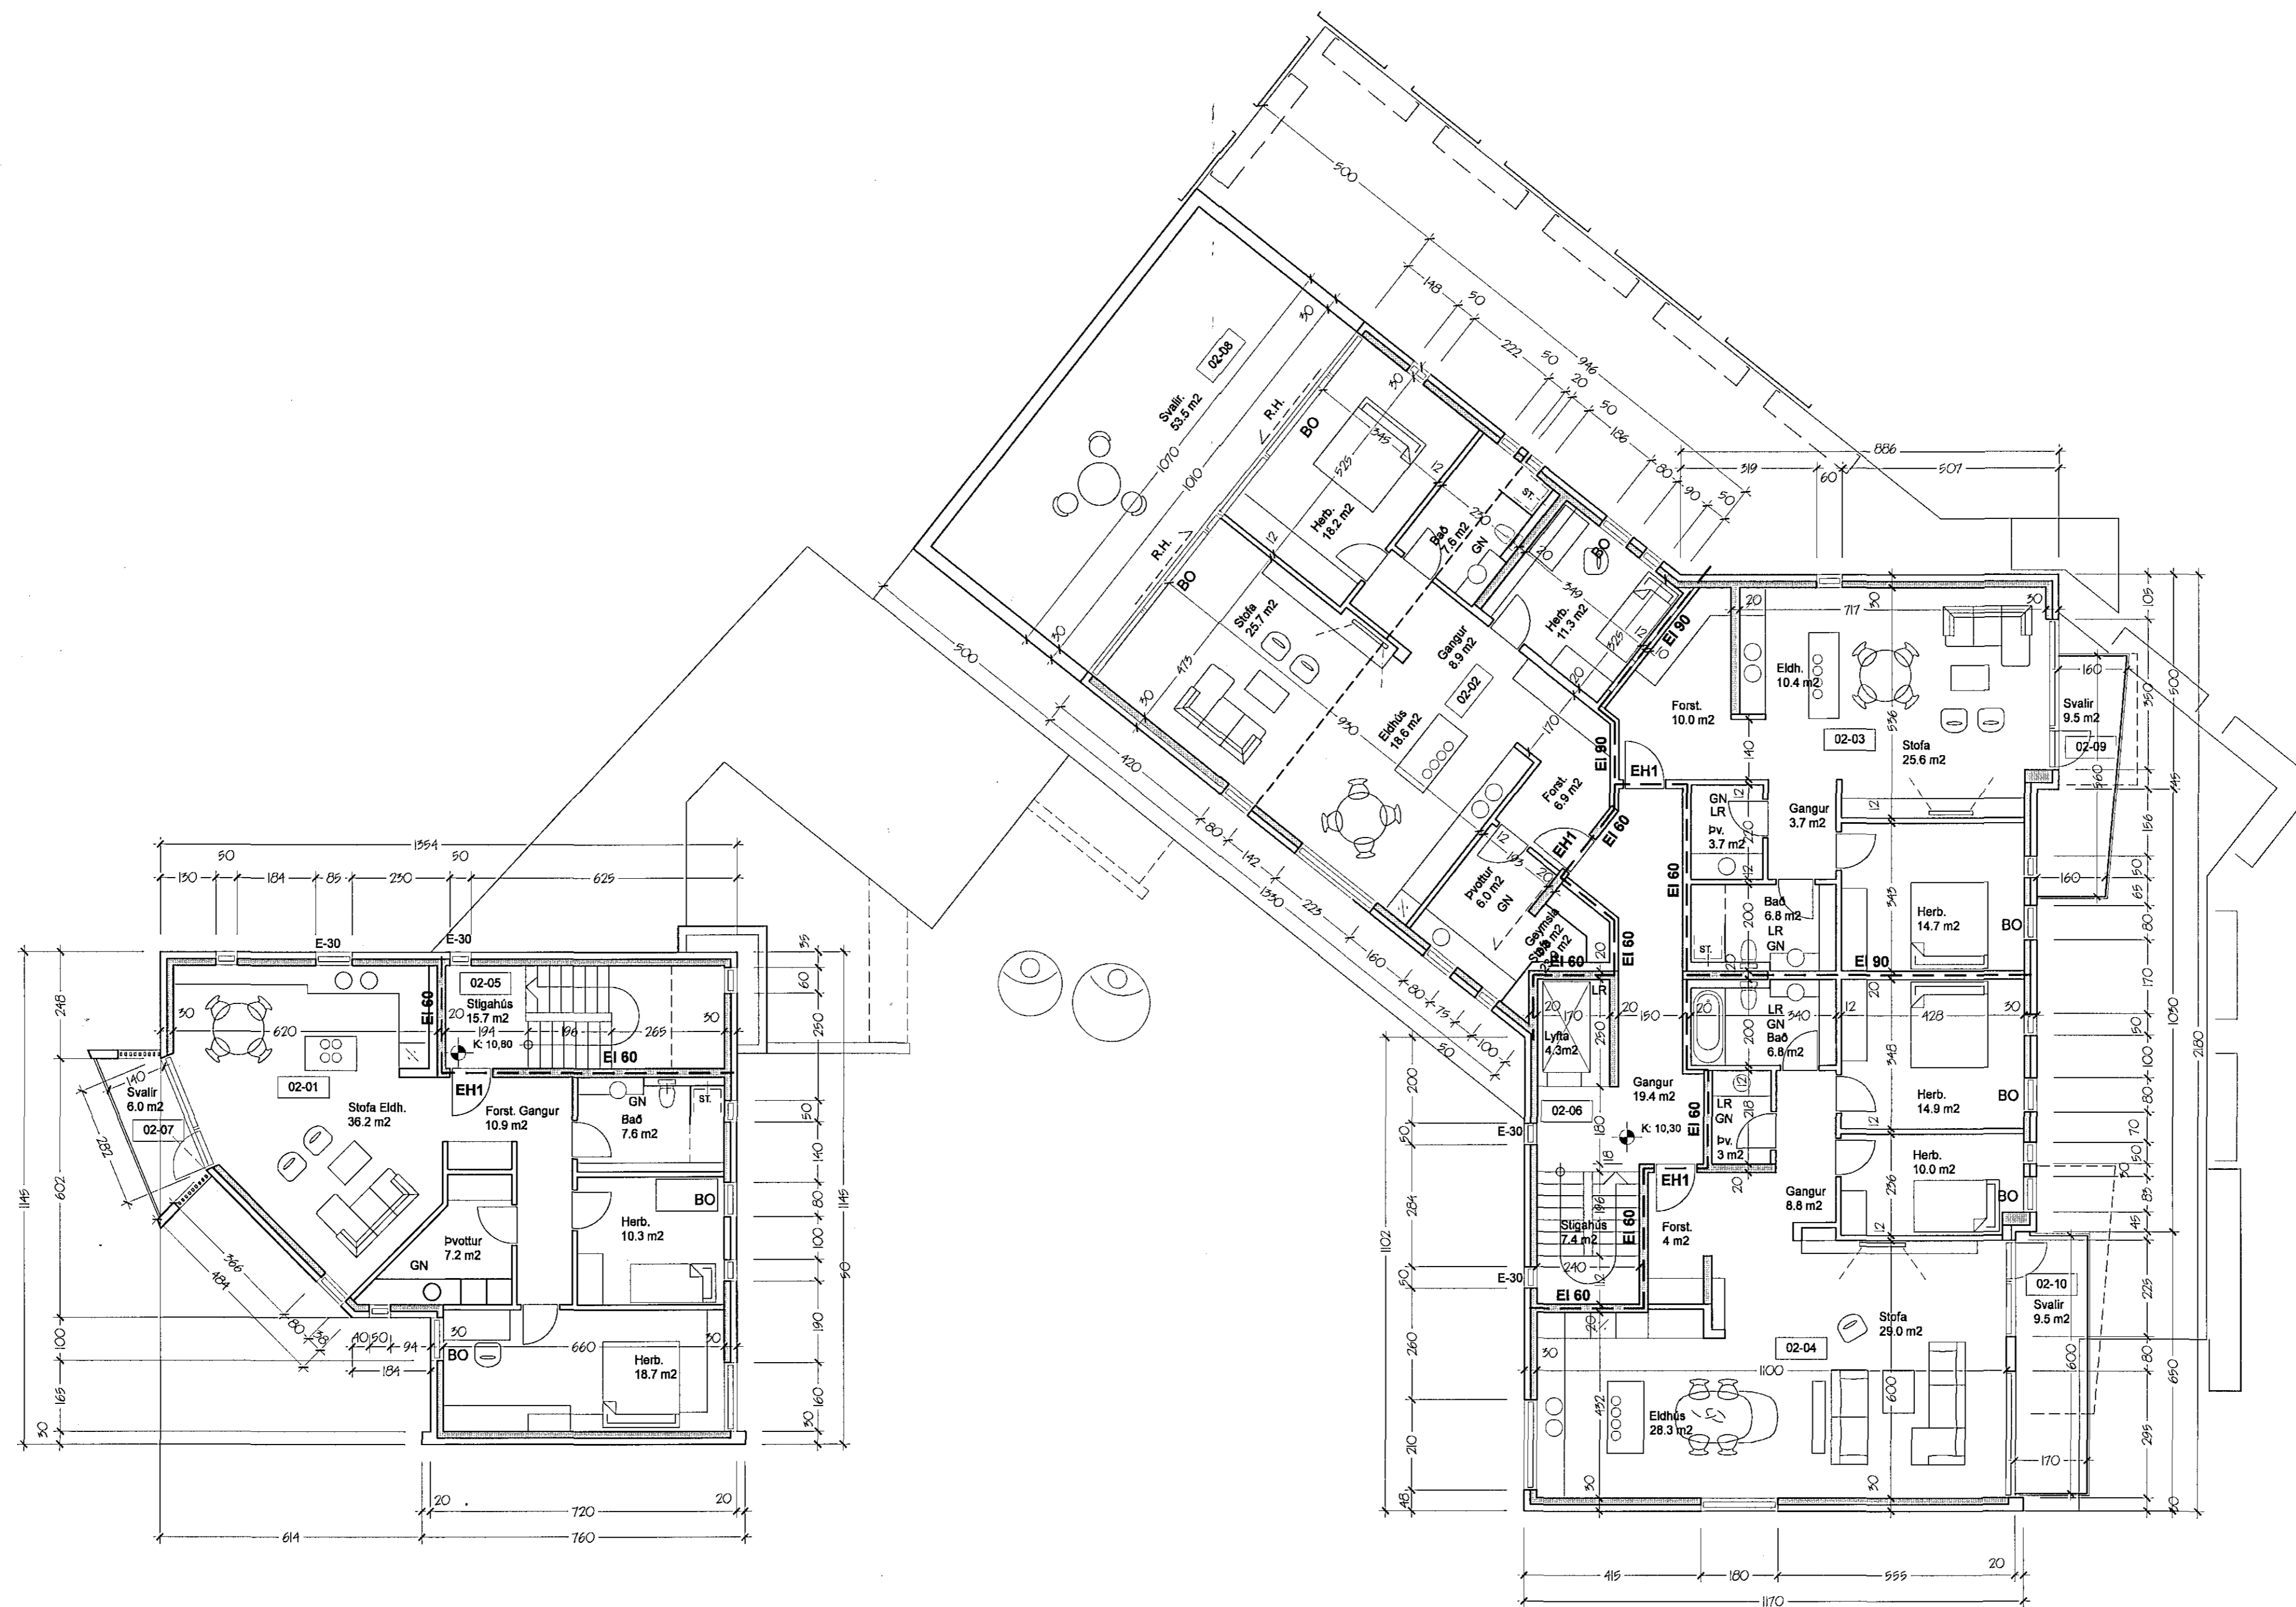


Br. A Bæði stíghús / tröppur leiðréttar dags. 13.03.'13
 Br. B Íbúðir 02-02 og 02-03 hús nr. 18, stækkun/mínkun. dags. 25.03.'14
 Br. C Sturtur f. baðkór dags. 02.02.'15

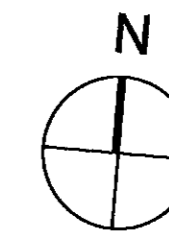

Grunnmynd 2.hæðar mkv.1:100

10 M

VESTURGATA 18 - 20

Fjölbýli í Hfj. mkv.: 1:100 **1.04**

AÐALUPPDRÁTTUR
 Grunnmynd
 2. Hæð

dags. 22.02.'07

Att Arkitektar

Suðurlandsbraut 30 108 Rvk. kt: 590406 0580
 tryggvi.tr@gmail.com GSM: 897 2380

Tryggvi Tryggvason FAI kt: 261266 5769



ott arkitektar_ (samstarfi við _ einrúm arkitektar

einrúm arkitektar
 gíslaháttum 20 104 reykjavík
 sími 553 8989 fex 568 8989
 ELLI TRÞ
 kræfni bryggja gæmsaldóttir, arkitektar fof
 kt.: 040766 5889 k@einrum.com

