


C:  
 B:  
 A:  
 BREYTINGAR: \_\_\_\_\_ DAGS: \_\_\_\_\_

VERKAUÐ: LAGGI ehf.

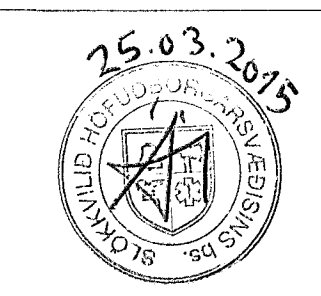

SÚÐURHELLA 10, 221 HAFNARFIRÐI.  
 ABALUPPRÁTTUR - REYNDARTEIKNING  
 ÚTLIT

VERK: SÚÐH 0715  
 KVAFRÐI: 1:100 TEIKNAD: PHM  
 DAGS: 04.02.2015 SKRÁ: 0715.DWG

**ÚTI INNI**

**ARKITEKTAR**  
 HINGHOLTSSTRÆTI 27 101 REYKJAVÍK  
 Símar 5527660 & 5627660 FAX 5527661  
 NETFANG ul@ul.is ul@ul.is  
 VEFANG http://www.ul.is  
 BALDUR Ó. SVAVARSSON ARKITEKTAR FAI  
 120857-5149  
 JÓN ÞÓR ÞORVALDSSON ARKITEKTAR FAI  
 021258-7579  
 TEIKNINGANR: **A-103** BREYTING: \_\_\_\_\_