

Samþykkt þann
22 JUN 2015
 Byggingeðlitrúnn í Hafnarfirði
 F.h. Sigurður Steinar Jónsson

NR. DAGS. BREYTING
 A JÚNÍ 2015 LEIÐRÉTT STÆRD GEYMSLULOFTS

SKÝRINGAR

11/6 '15
 SEMUNDUR EIRIKSSON 261249-2949


FLÉTTUVELLIR 9
 220 HAFNARFJÖRÐUR




KLÖPP ARKITEKTAR-VERKFRÆÐINGAR EHF
 NETHYL 2, PÓSTHÓLF 10050, 110 REYKJAVÍK
 SÍMI 577 2277, 699 7747 FAX 577 2280

HEITI TEIKN. GRM GEYMSLULOFT OG SNID


MÆLIKVARDI 1:100 DAGS. JÚLÍ 2005
 TEIKNING A 004 VERK V 05-310
 BREYTING A YFIRFARID S.E.

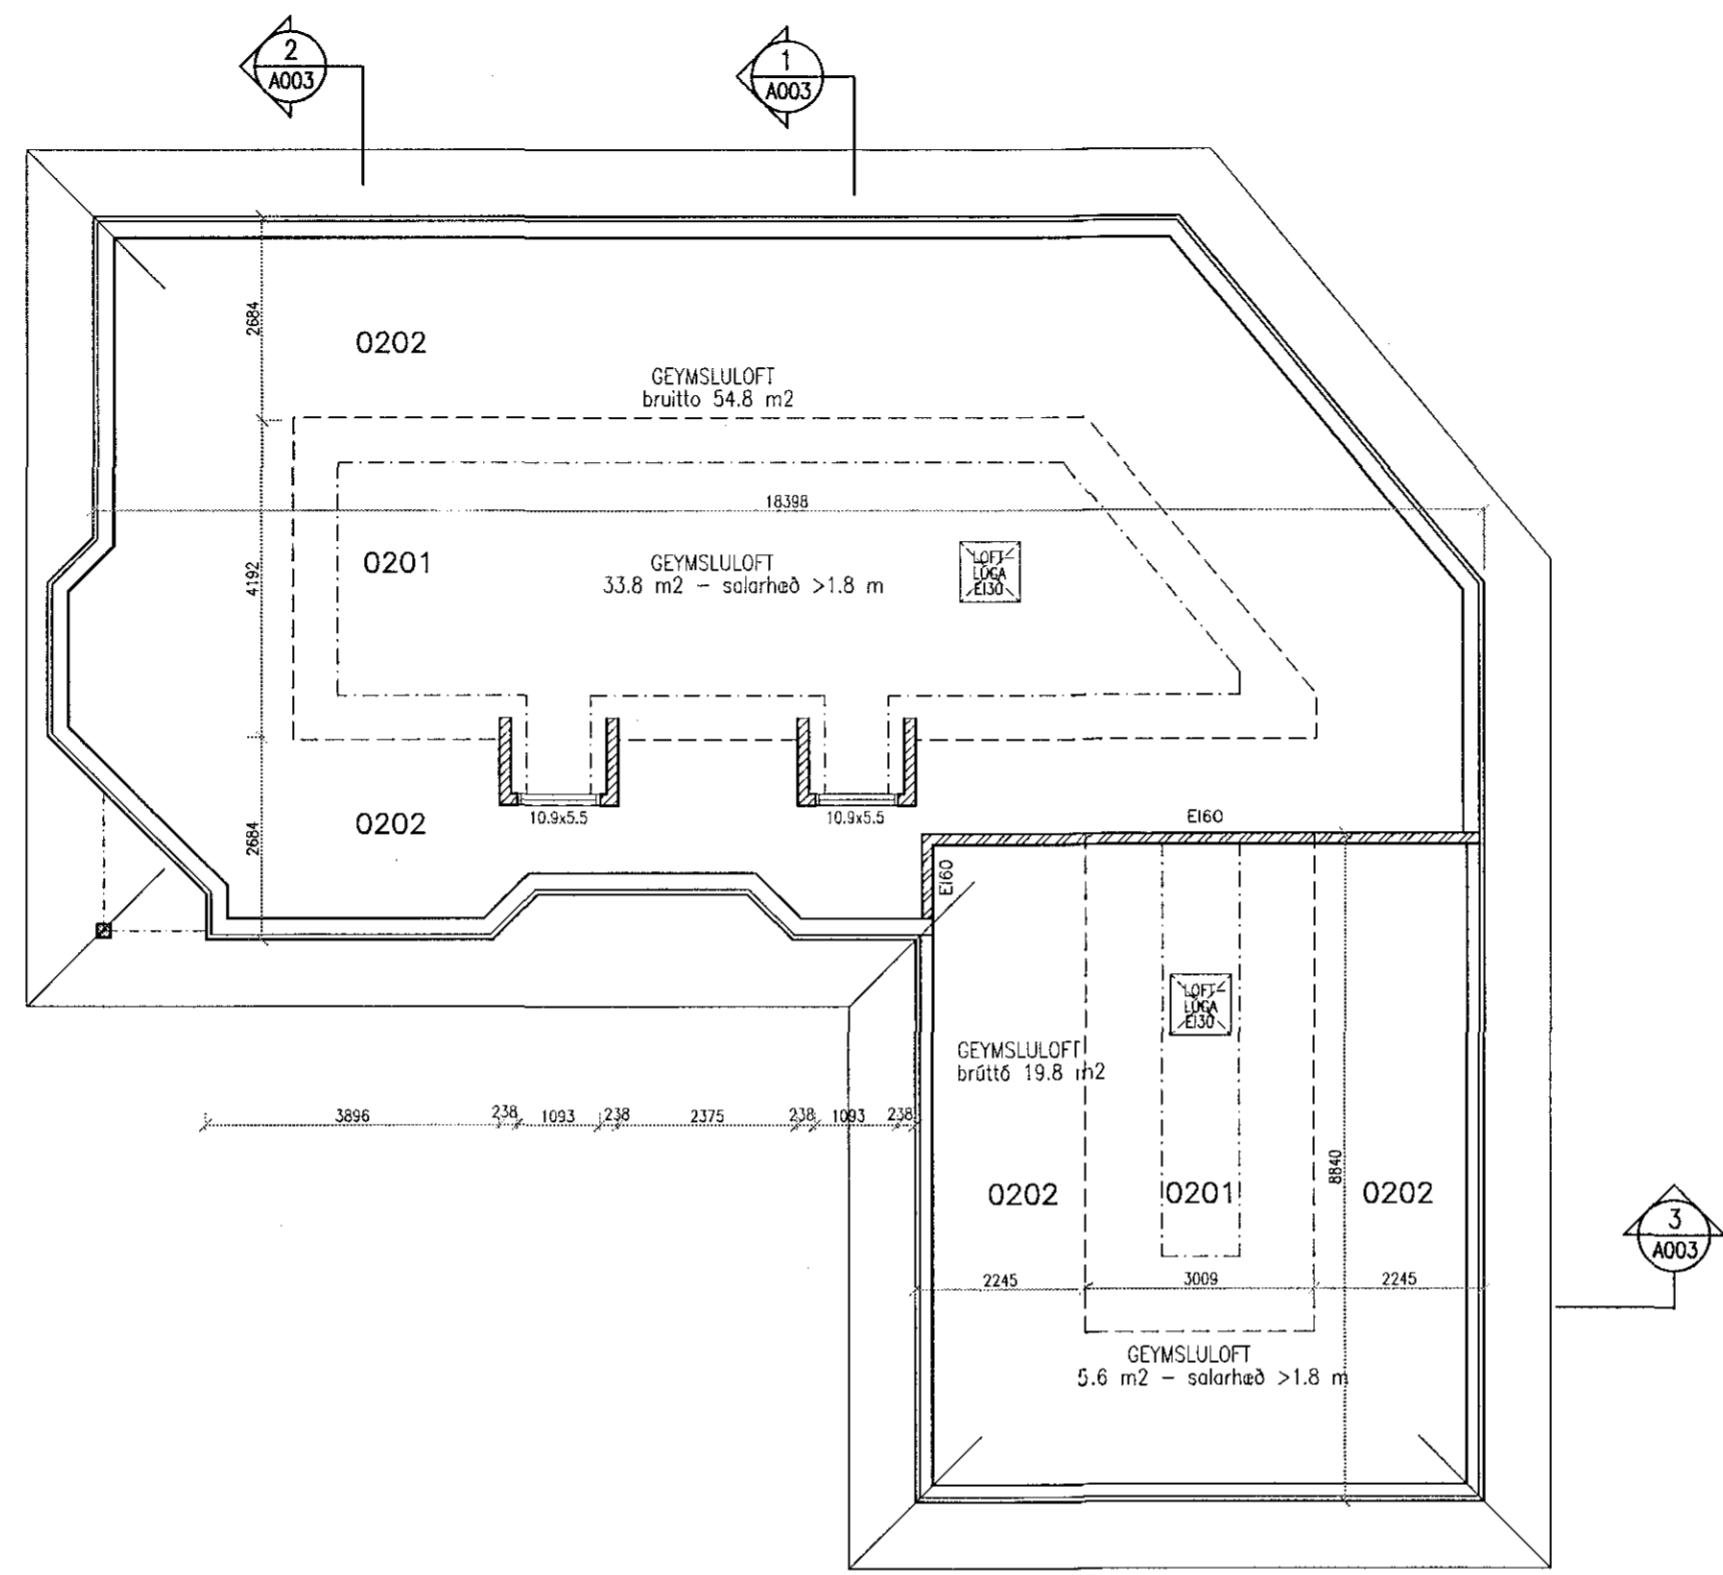


GRUNNMYND GEYMSLULOFT 1:100

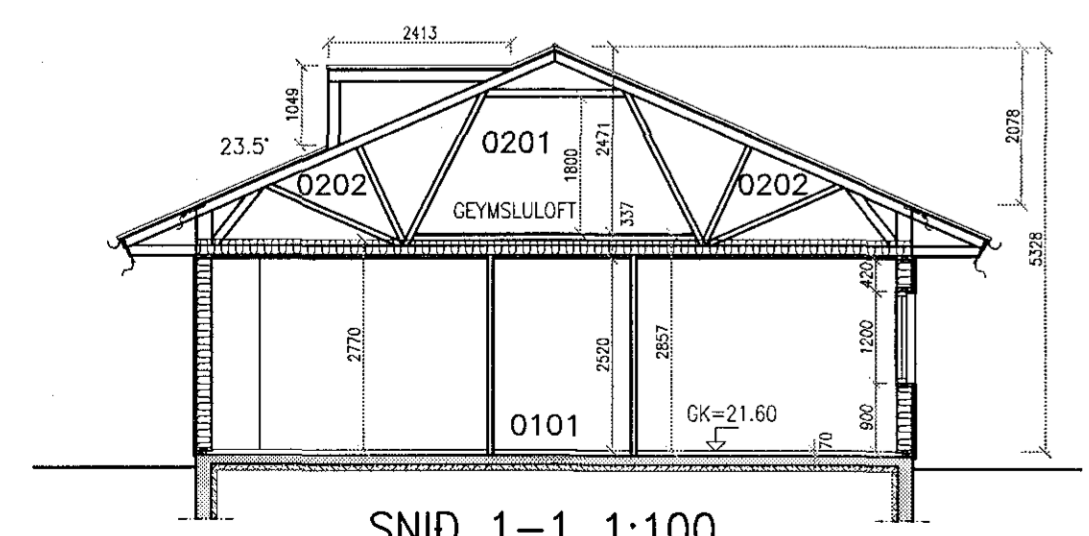

SNID 1-1 1:100

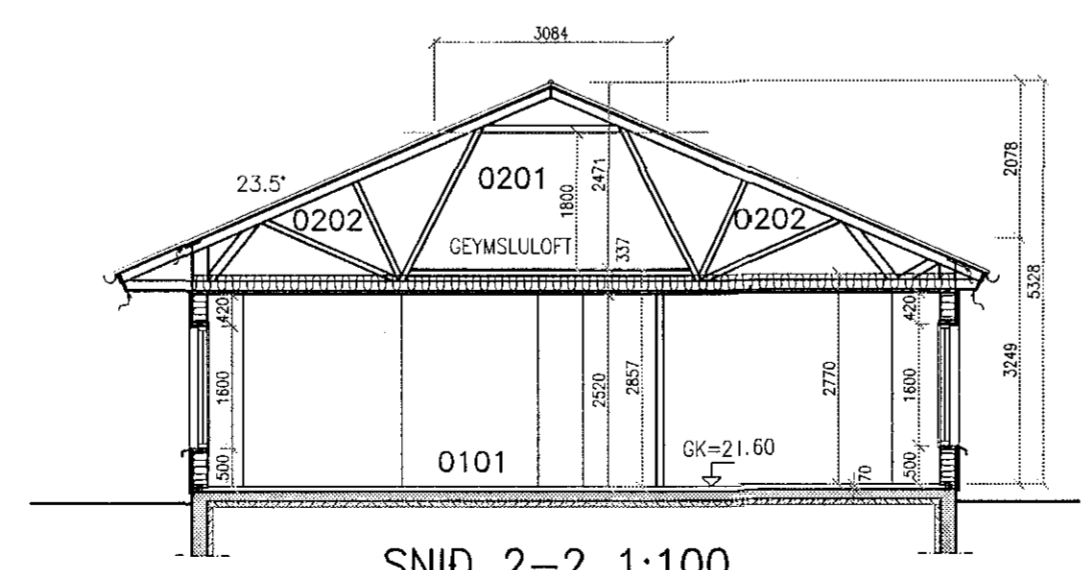

SNID 2-2 1:100

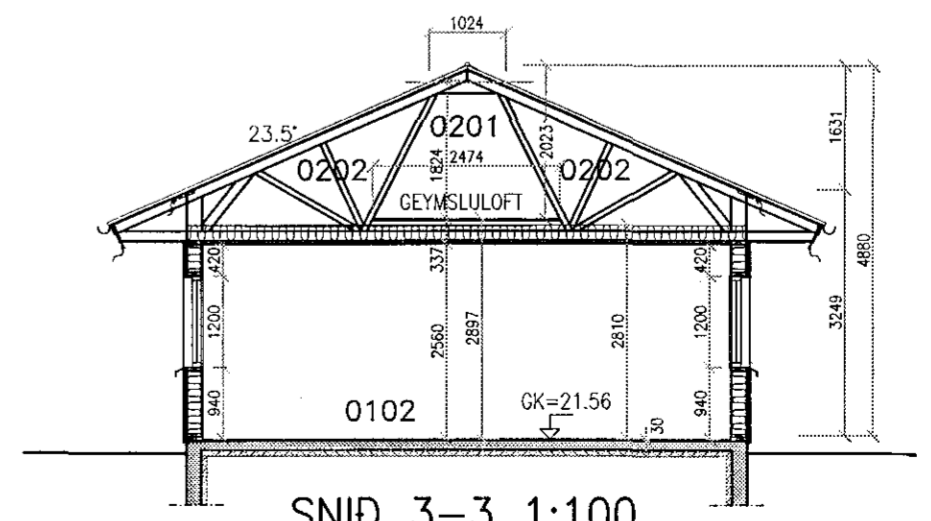

SNID 3-3 1:100

