AXIS 4
1:50

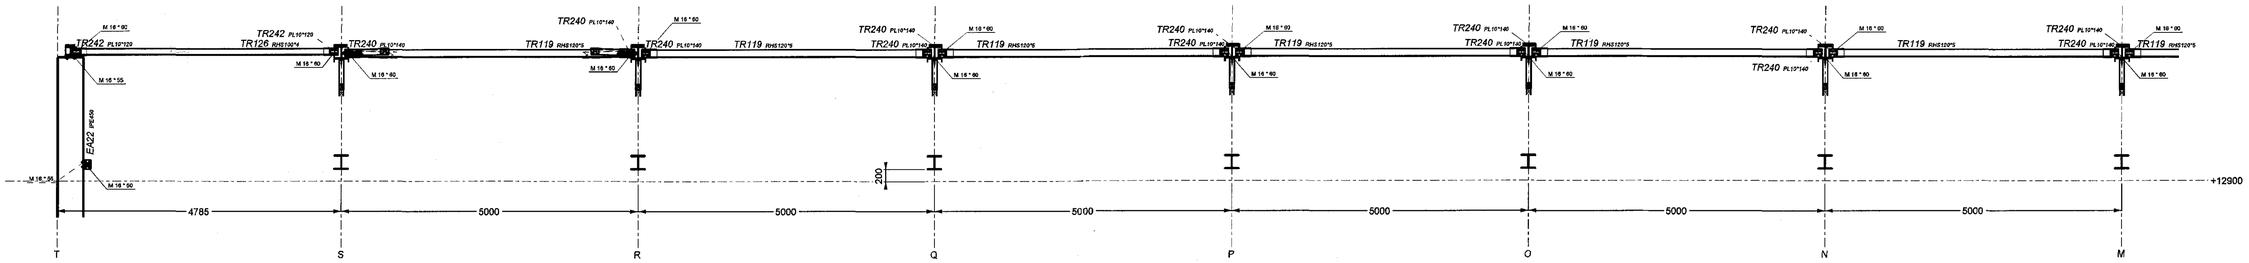

AXIS 4
1:50

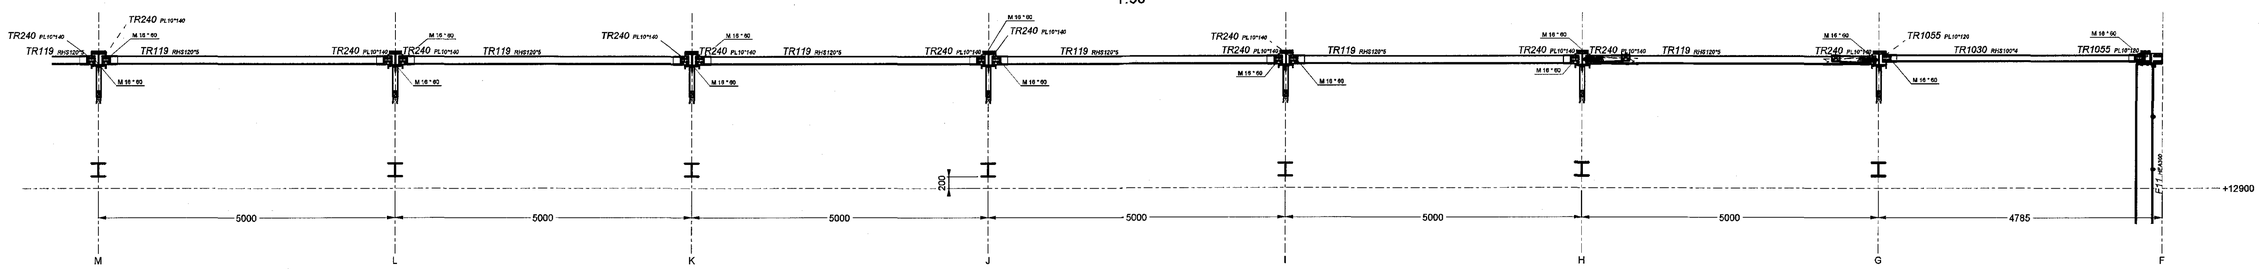

AXIS 5
1:50

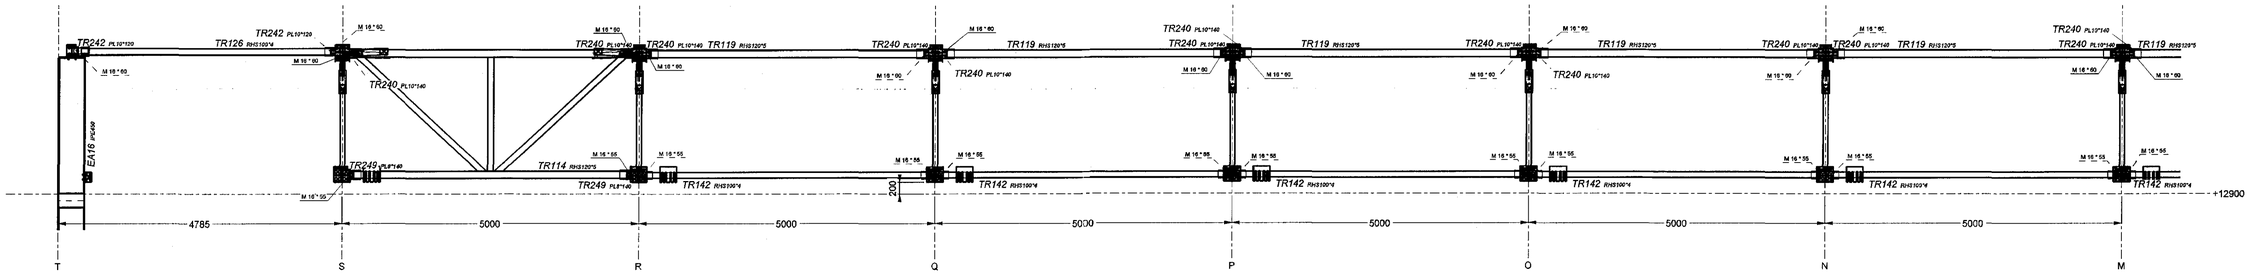

AXIS 5
1:50

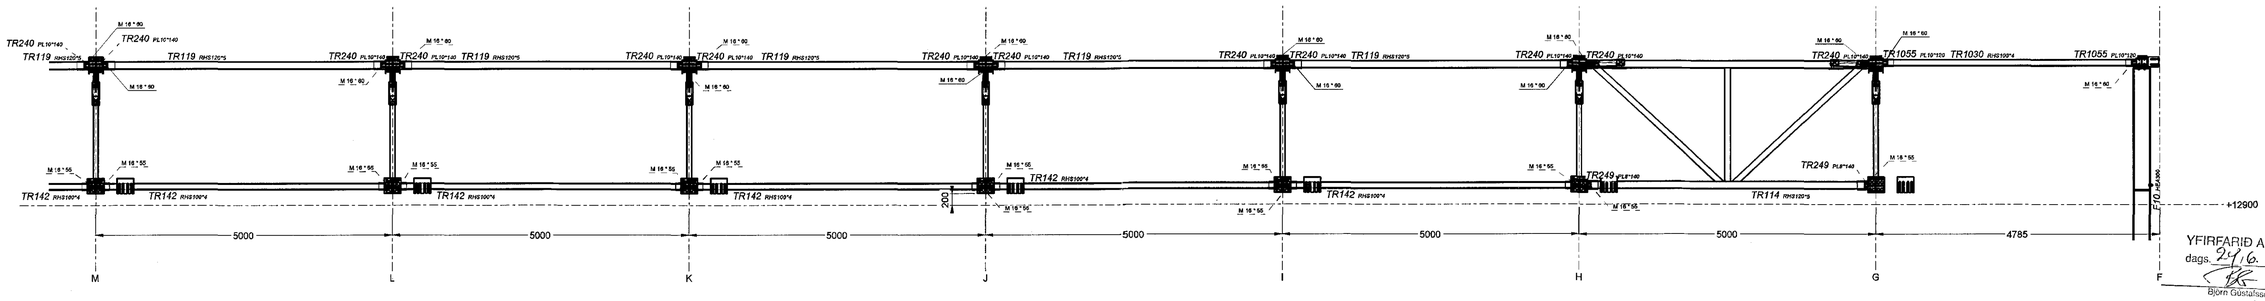

YFIRFARIÐ AF VSB
dags. 24/6. 2015
Björn Gustafsson

FOR MORE DETAILS SEE DRAWING: 2015-126-01-01-03

Bolts: M - class 8.8, DIN 931 or DIN 933 - fire galvanized. Bolts: HVM - class 10.9, DIN 6914 - fire galvanized
For all bolts predict two washers, one below bolt head, second below nut / For bolts fixed to C-profiles set up wedge washer (DIN 434)
Execution acc. to EN 1090-2. Execution class EXC3, Tolerances class 2

Rev.:	Revision description:	Date:	Drawn by:	Designed by:	Checked by:
00	First issue	02.06.2015	A. Chanos	P. Kozlowski	G.R. Gylfason

Supplier: CEDRUS EHF., Mistunni 28, 800 Selfoss, Iceland

Designer: ENGINEERING OFFICE KOZLOWSKI-PROJEKT, Zawiszy Czarnego Square 4A/7, 70-212 Szczecin, Poland, tel. +48 91 892 21 32, e-mail: biuro@kozlowskiprojekt.com

Project: Oseyrarbraut 22 | Object: Main Building | Phase: Main Structures

Drawing title: General Arrangement - Axes: 4 & 5 | Drawing No.: 2015-126-01-01-18 | Rev.: 00 | Scale: — | Format: A1