


3D VIEW
1:150

Stapphólmur
11 AUG 2015
Björnir Guðjónsson
Eh. Sigurður Steinar Jónsson

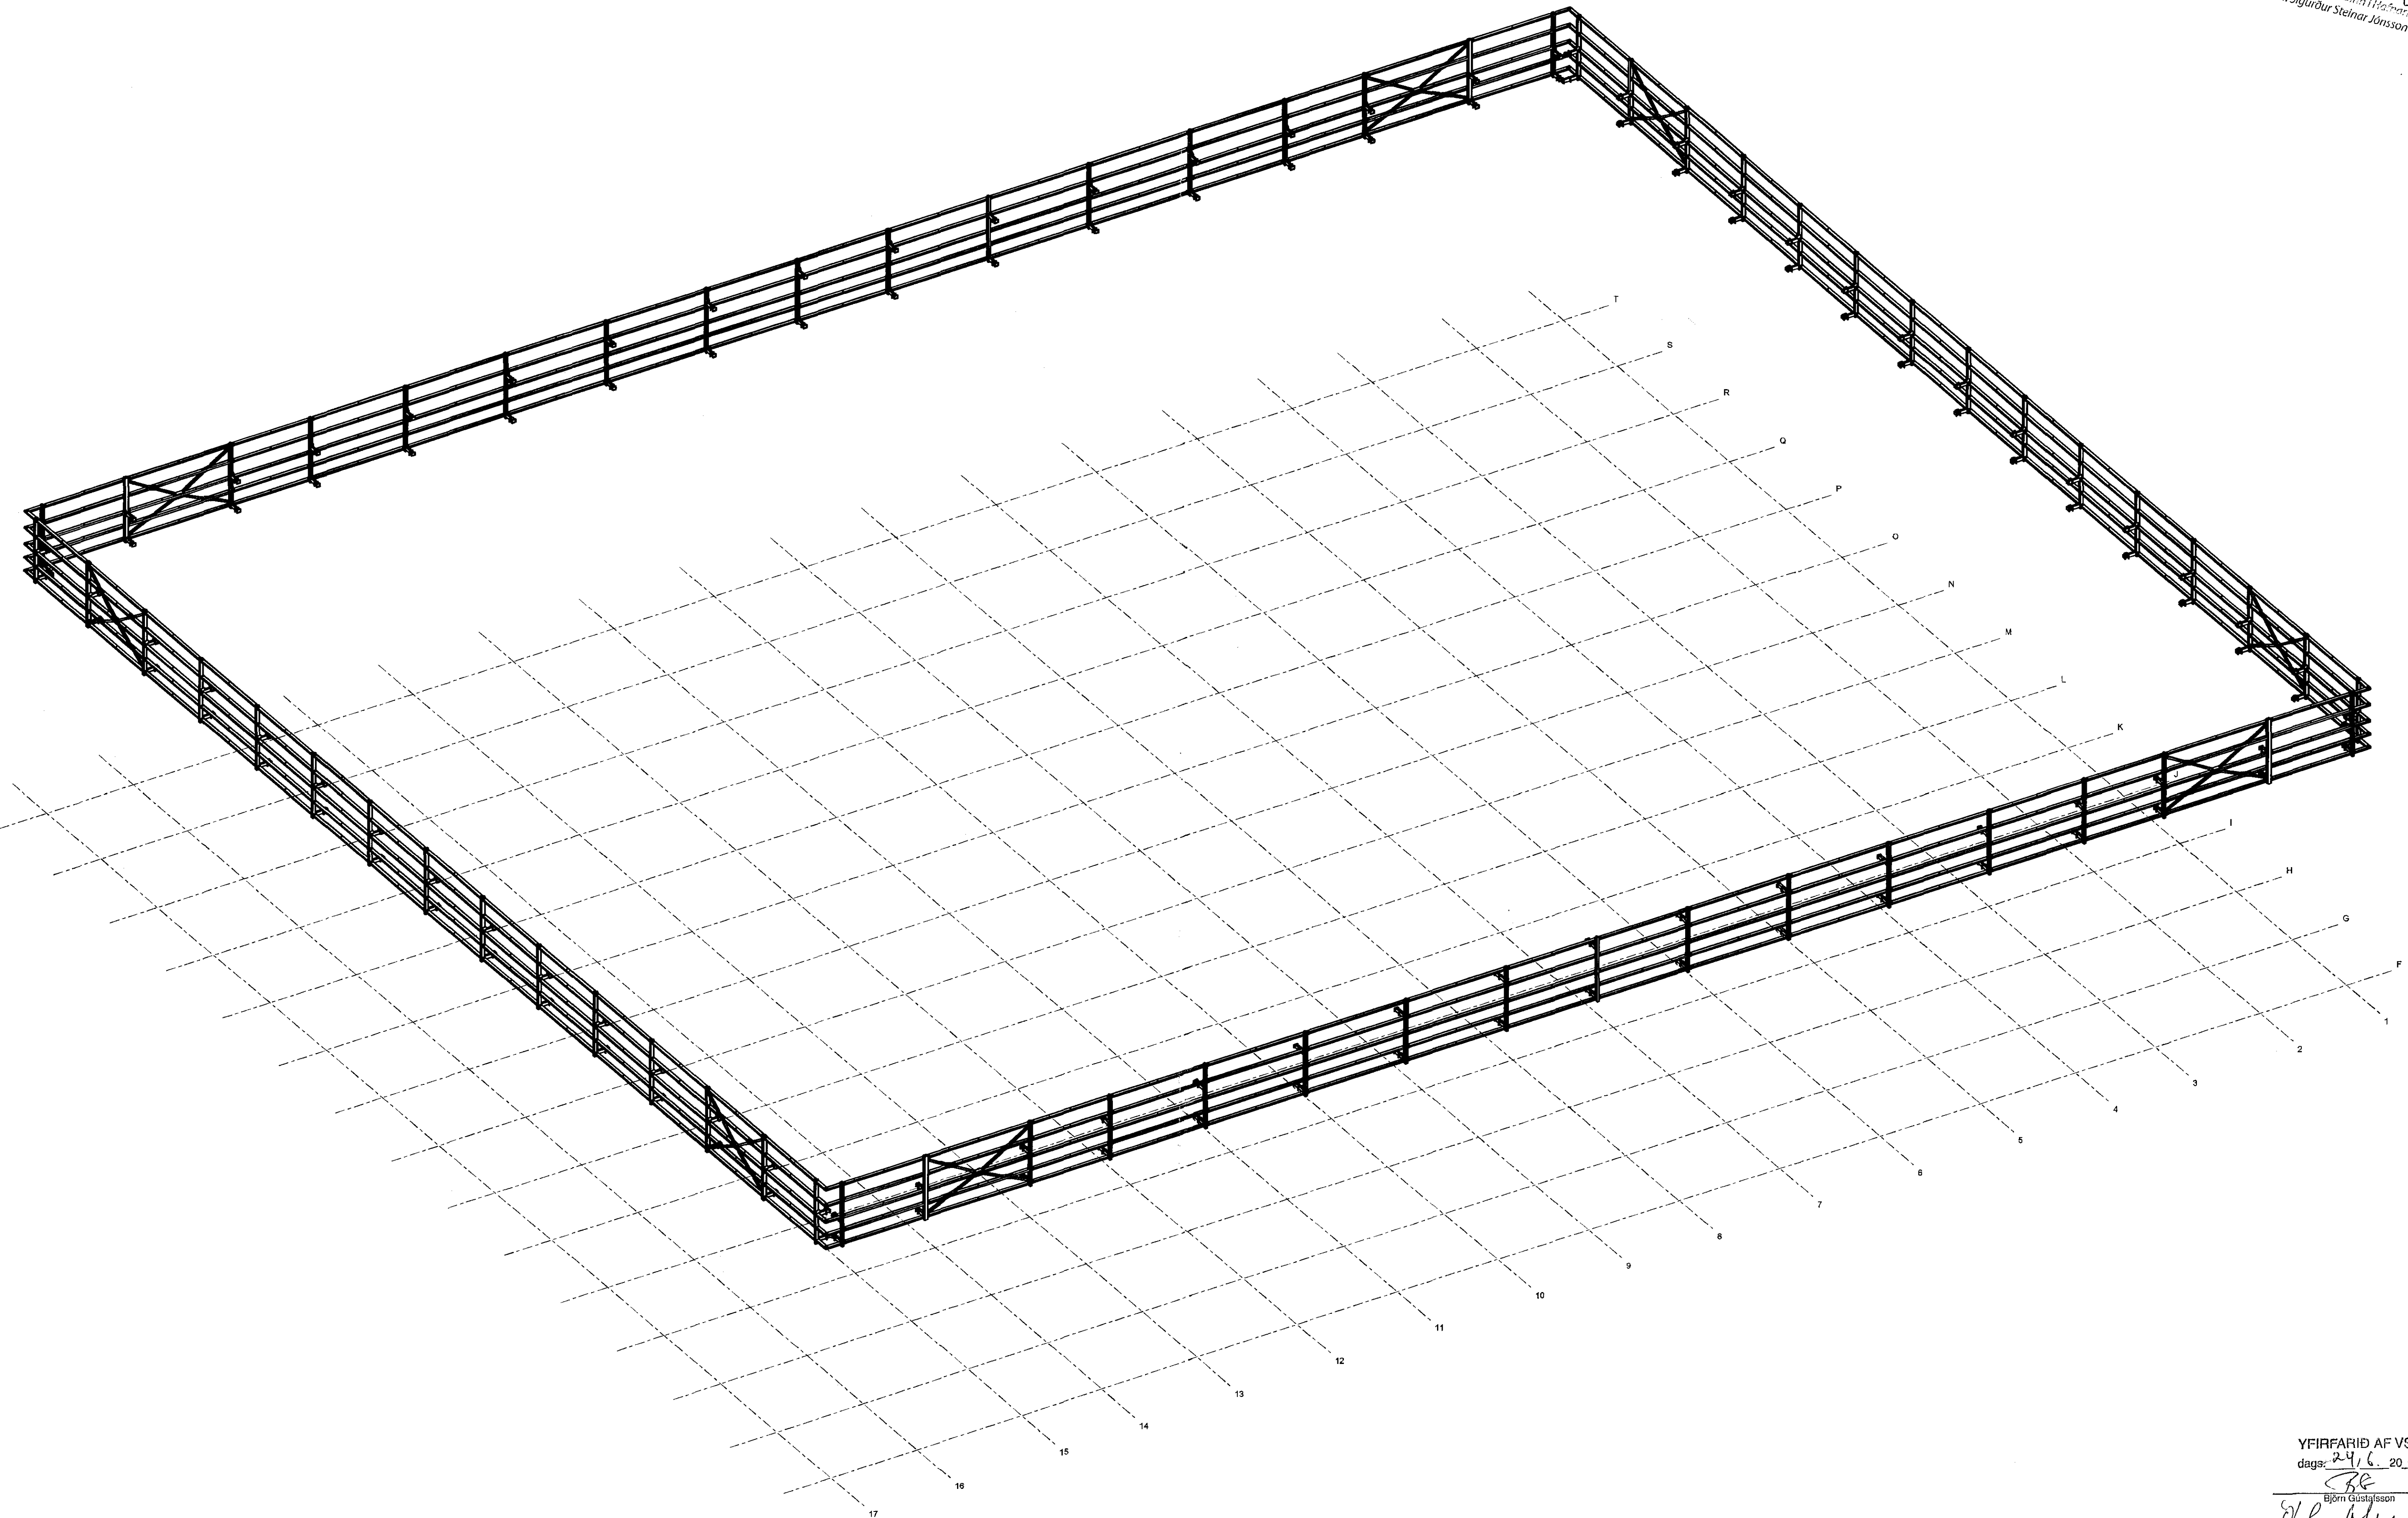

YFIRFARID AF VSB
dags: 24.6. 2015


<small>Scale: 1:100 - dimensions: 1000x1000 - see plan view Scale: 1:150 - dimensions: 1250x1250 - see perspective</small>		<small>For all jobs, provide two weeks' notice for drawings and second drawings. For jobs fixed in a contract, see contract conditions.</small>		<small>Execution according to EN 1090-2 Construction according to EN 1090-2. Tolerances class 2.</small>	
00	First issue	08.06.2015	A. Chrus	P. Kozłowski	G.R. Olszewski
Rev:	Revision description:	Date:	Drawn by:	Designed by:	Checked by:
Scale:	CEDRUS EHF.		Minimal 20, 800 Pałkusa, Łódź		
Designer:	ENGINEERING OFFICE KOZŁOWSKI-PROJEKT		Zawasy Czarnego Square 4A/7, 76-212 Szaradzi, Poland tel. +48 91 862 21 92 e-mail: biuro@kozowskiprojekt.com		
Project:	Ouseyrafraut 22	Object:	Main Building	Phase:	Parapets
Drawing title:	General Arrangement - 3D View		Drawing No.:	2015-126-01-01-32	Rev: 00 Scale: A1