


1:100
 Grunnmynd, 1.hæð

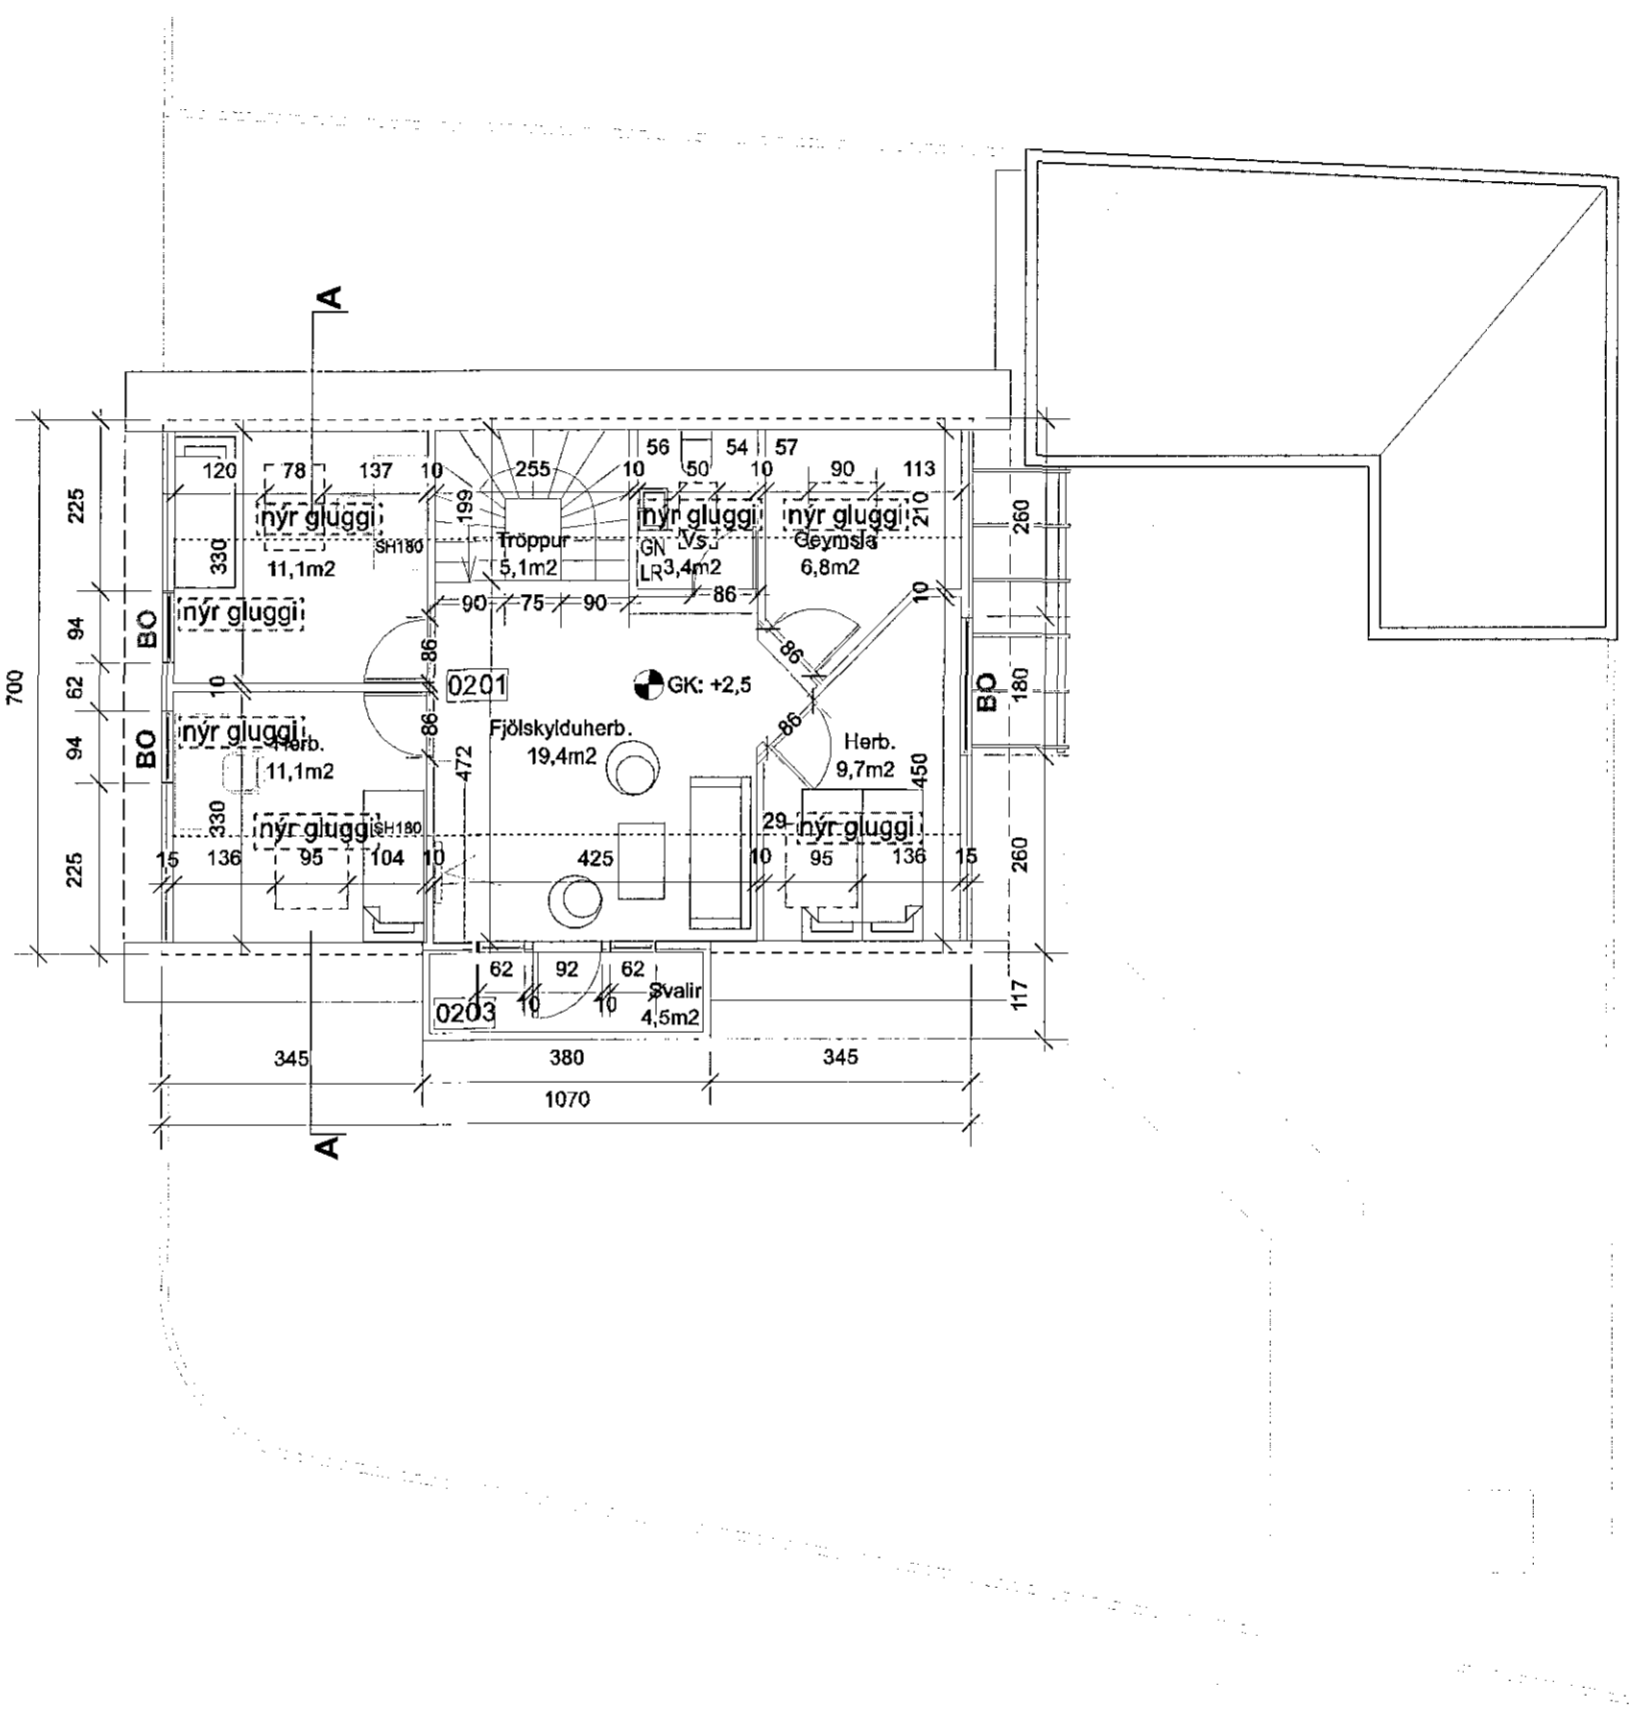

1:100
 Grunnmynd, 2.hæð

HELLUBRAUT 1

BREYTING

VERKHLUTI: BREYTTIR AÐALUPPDRAETTIR	VERK NR.: 1303
TEIKNING AFSTÖÐUMYND GRUNNMYND	DAGS.: 21.11.2014
TEIK.NR.: A-1303-201-B	MKV.: 1:100

Baark

KT: 550411-0750
 VESTURGATA 12B, 220 HAFNARFJORDUR
 SIMI: 645 5722 MAIL: INFO@BAARK.INFO

Borghildur Sturludóttir
 BÖRGHILDUR STURLUDÓTTIR
 ARKITEKT FAI
 KT 0909754479

Anders Møller Nielsen
 ANDERS MÖLLER NIELSEN
 ARKITEKT FAI
 KT 0702742649