




VESTUR

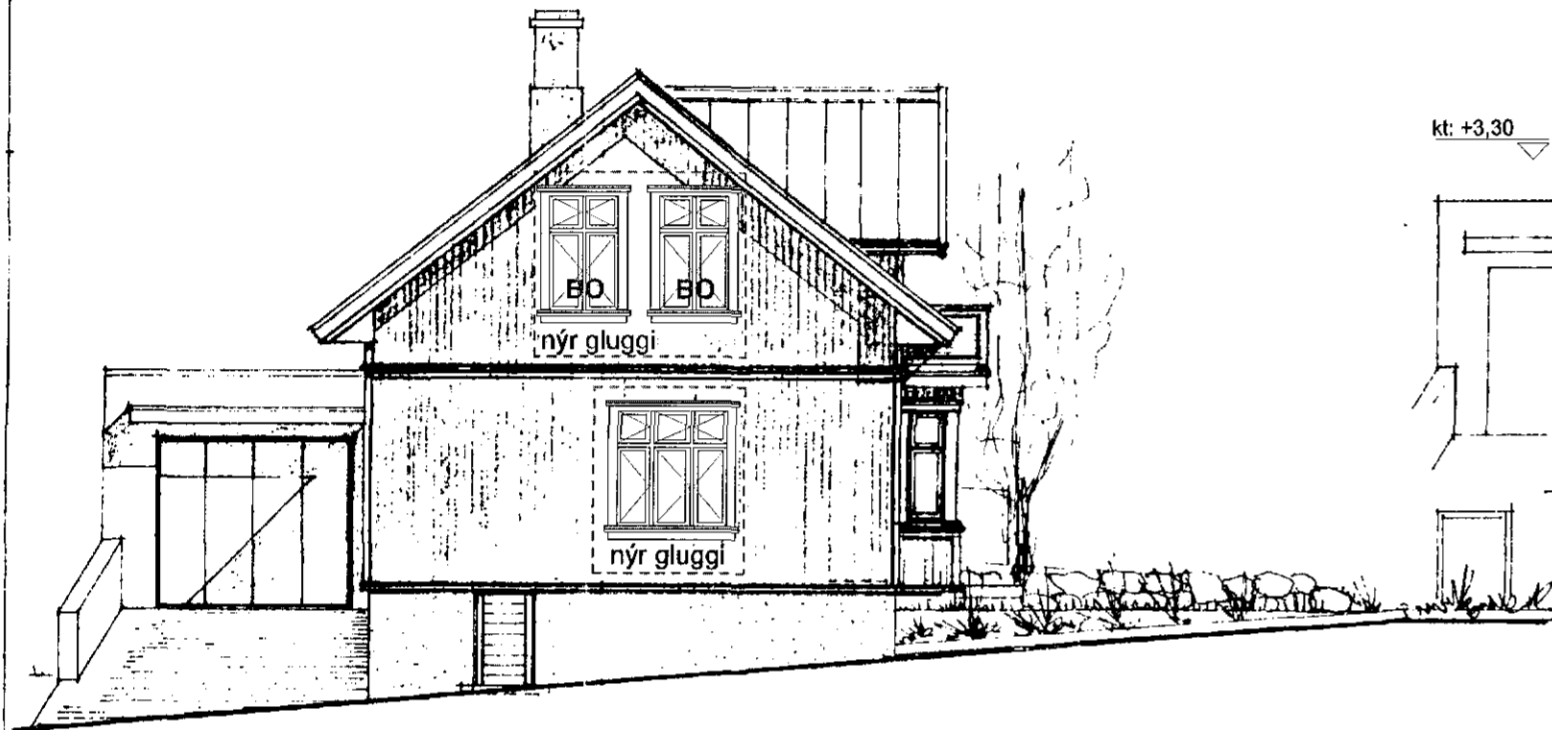


NORÐUR

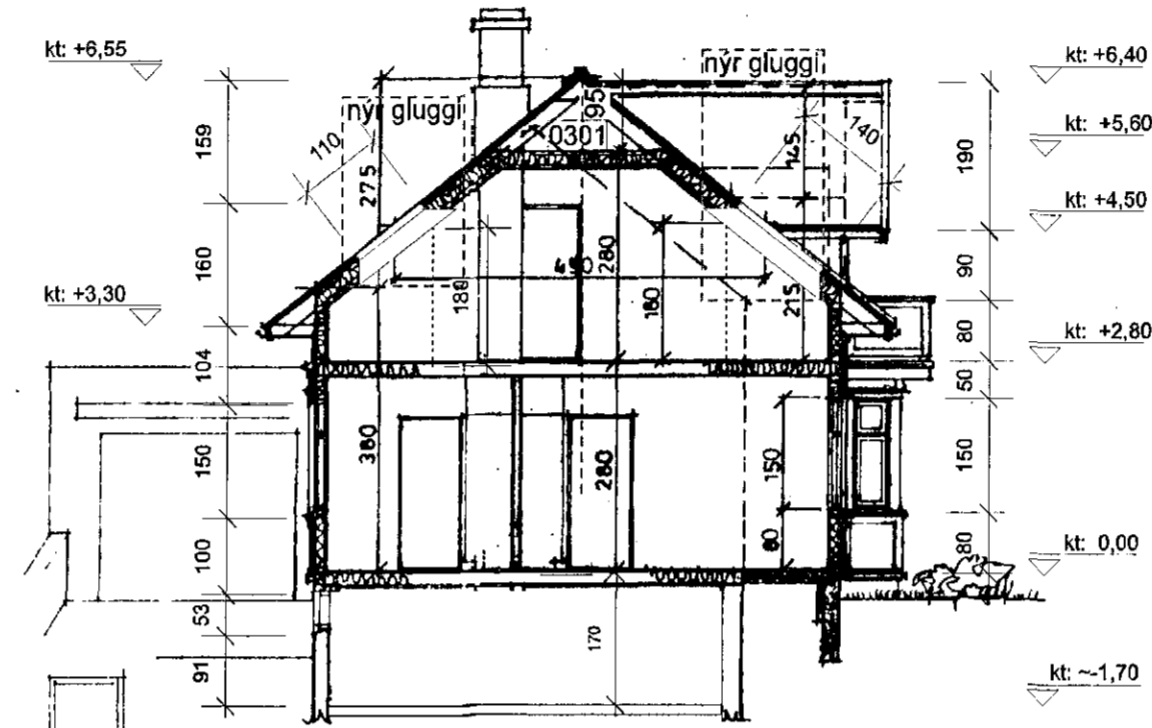

SNID A-A

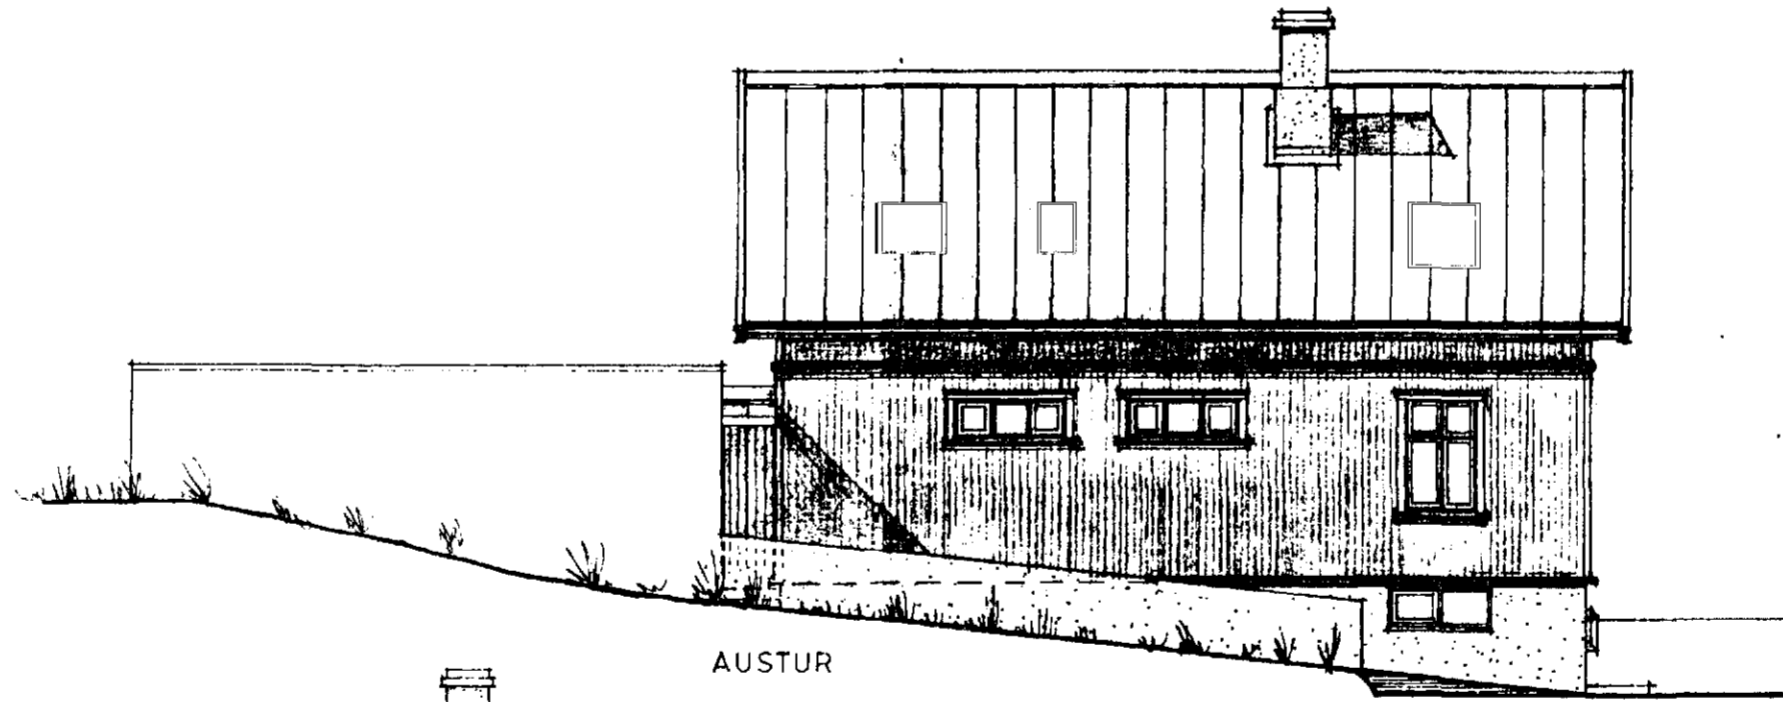

AUSTUR

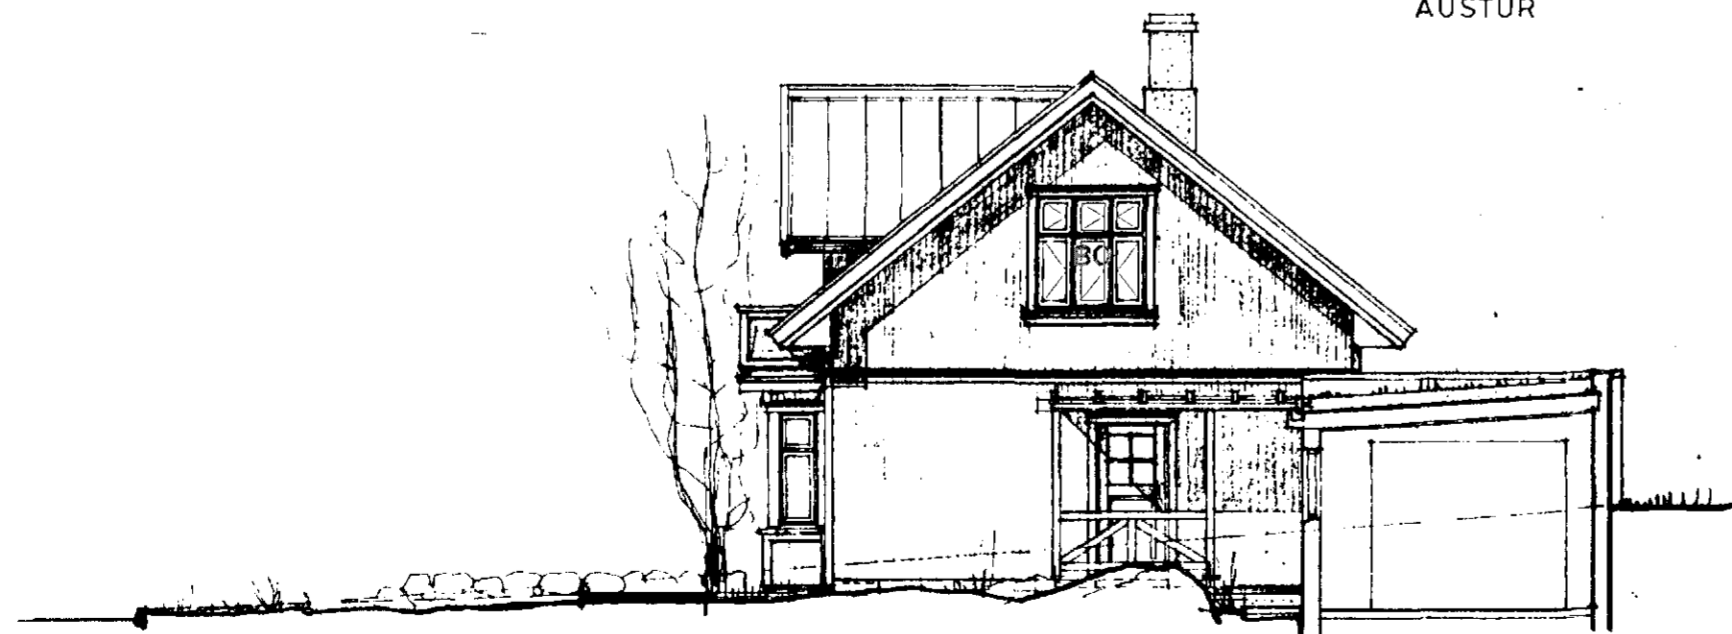

SUÐUR

Samþykkt þann

07 JAN 2015

Byggingafulltrúinn í Hafnarhóli  
F.h. Sigurður Steinar Jónsson

## HELLUBRAUT 1 BREYTING

VERKHLUTI:  
BREYTTIR AÐALUPPDRAETTIR

VERK NR.: 1303

TEIKNING  
UTLIT-SNID-A

DAGS.: 21.11.2014

MKV.: 1:100

TEIK.NR.:  
A-1303-202-A

# Baark

KT: 550411-0750  
VESTURGATA 12B, 220 HAFNARFJORDUR  
SIMI: 845 5722 MAIL: INFO@BAARK.INFO

BORGHILDUR STURLUDOTTIR  
ARKITEKT FAI  
KT 0909754479

ANDERS MØLLER NIELSEN  
ARKITEKT FAI  
KT 0702742649