




6  
5  
4  
3  
2  
1

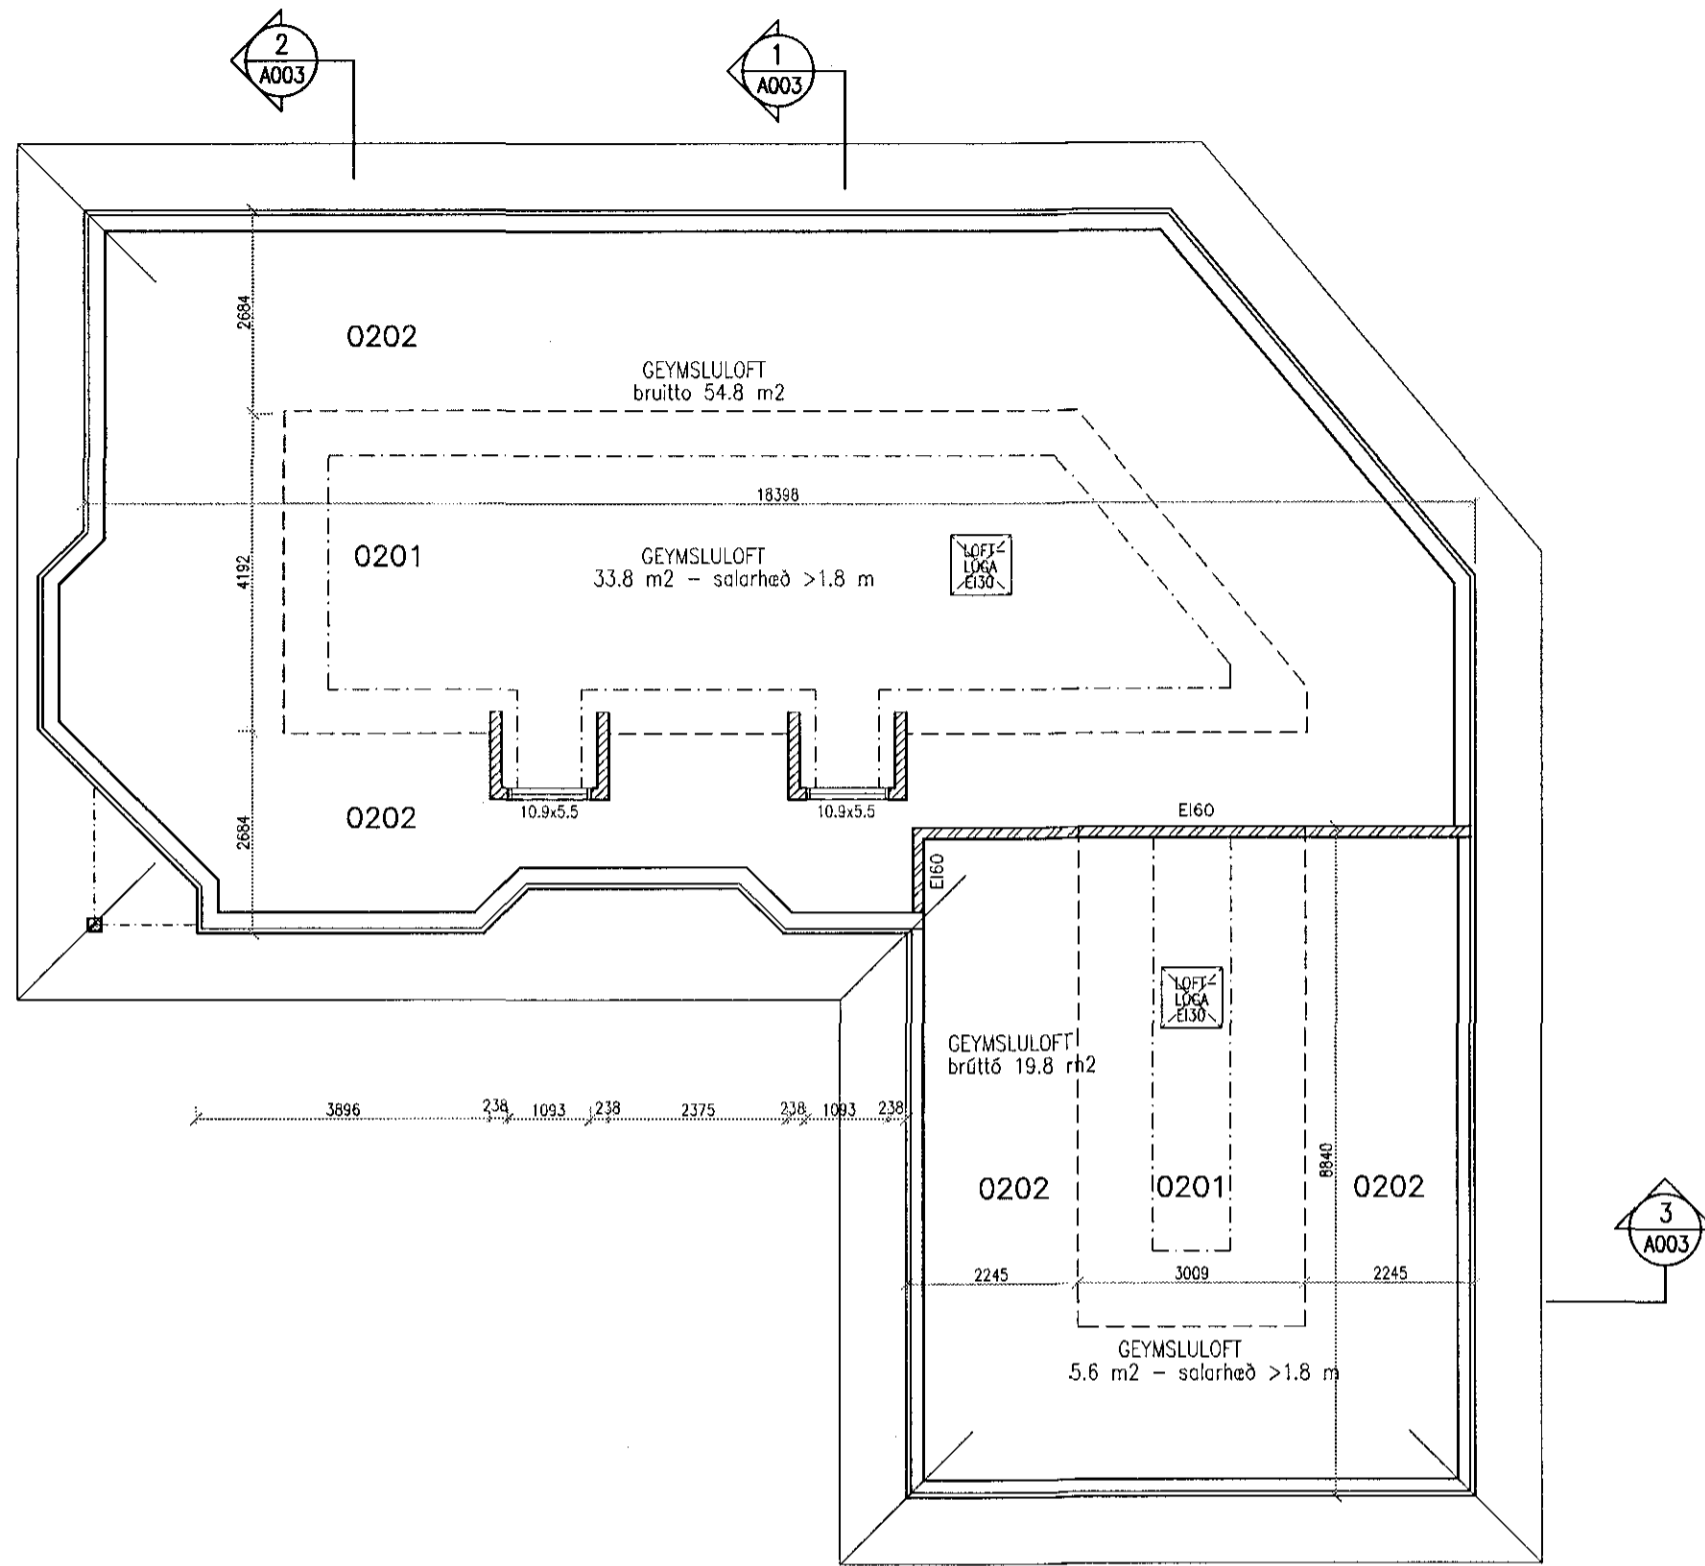


GRUNNMYND GEYMSLULOFT 1:100

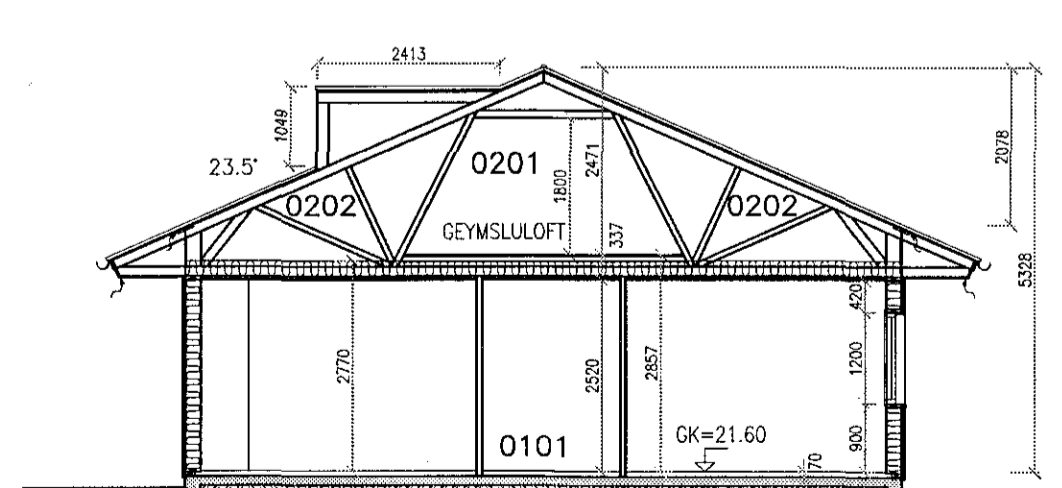

SNID 1-1 1:100

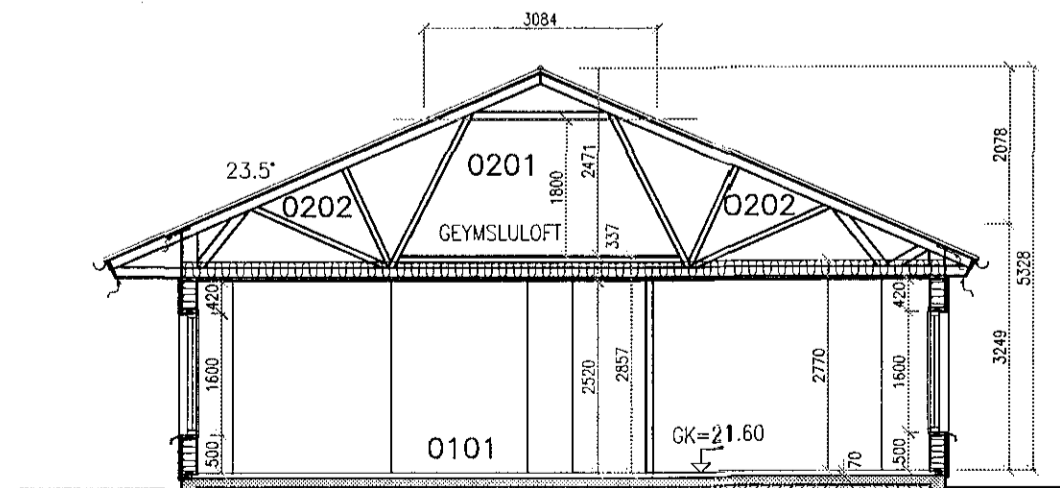

SNID 2-2 1:100

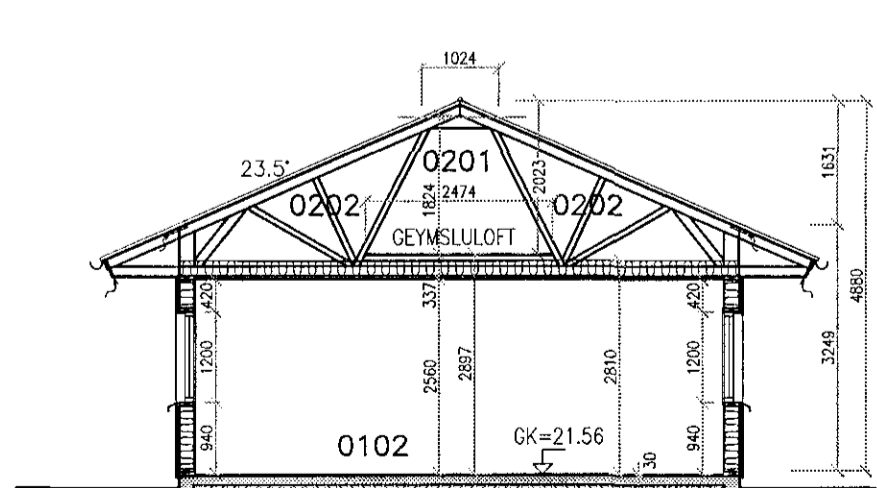

SNID 3-3 1:100

Samþykkt þann  
22 JUN 2015  
Lögfræðingur Steinar Jónsson

NR. DAGS. BREYTING  
A JÚNÍ 2015 LEIÐRÉTT STÆRD GEYMSLULOFTS

SKÝRINGAR

11/6'15  
SÆMUNDUR EIRIKSSON 261249-2949

FLÉTTUVELLIR 9  
220 HAFNARFJÖRÐUR



KLÖPP ARKITEKTAR-VERKFRÉÐINGAR EHF  
NETHYL 2, PÓSTHÓLF 10050, 110 REYKJAVÍK  
SÍMI 577 2277, 699 7747 FAX 577 2280

HEITI TEIKN. GRM GEYMSLULOFT OG SNID

MÆLIKVARDI 1:100 DAGS. JÚLÍ 2005

TEIKNING A 004 VERK V 05-310

BREYTING A YFIRFARID S.E.

8 7 6 5 4 3 2 1