
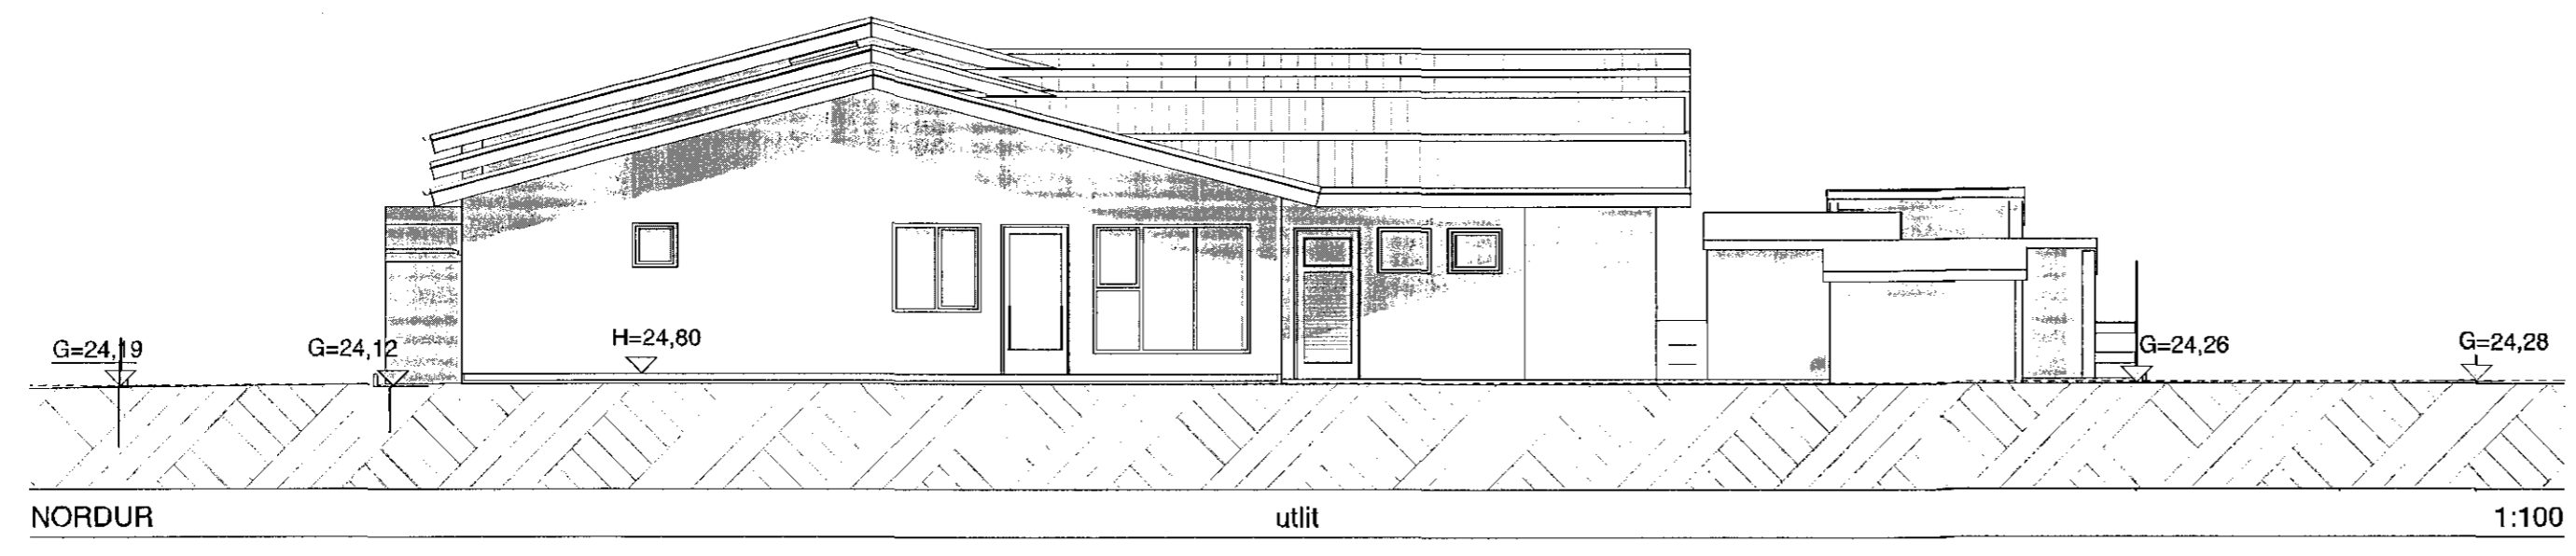
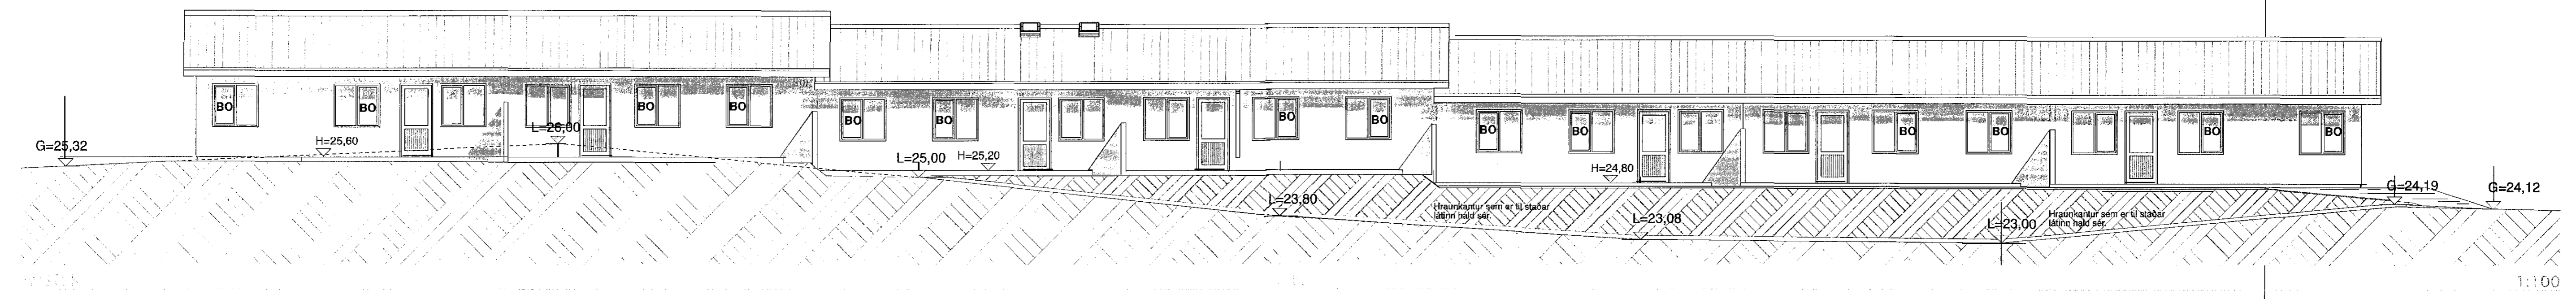
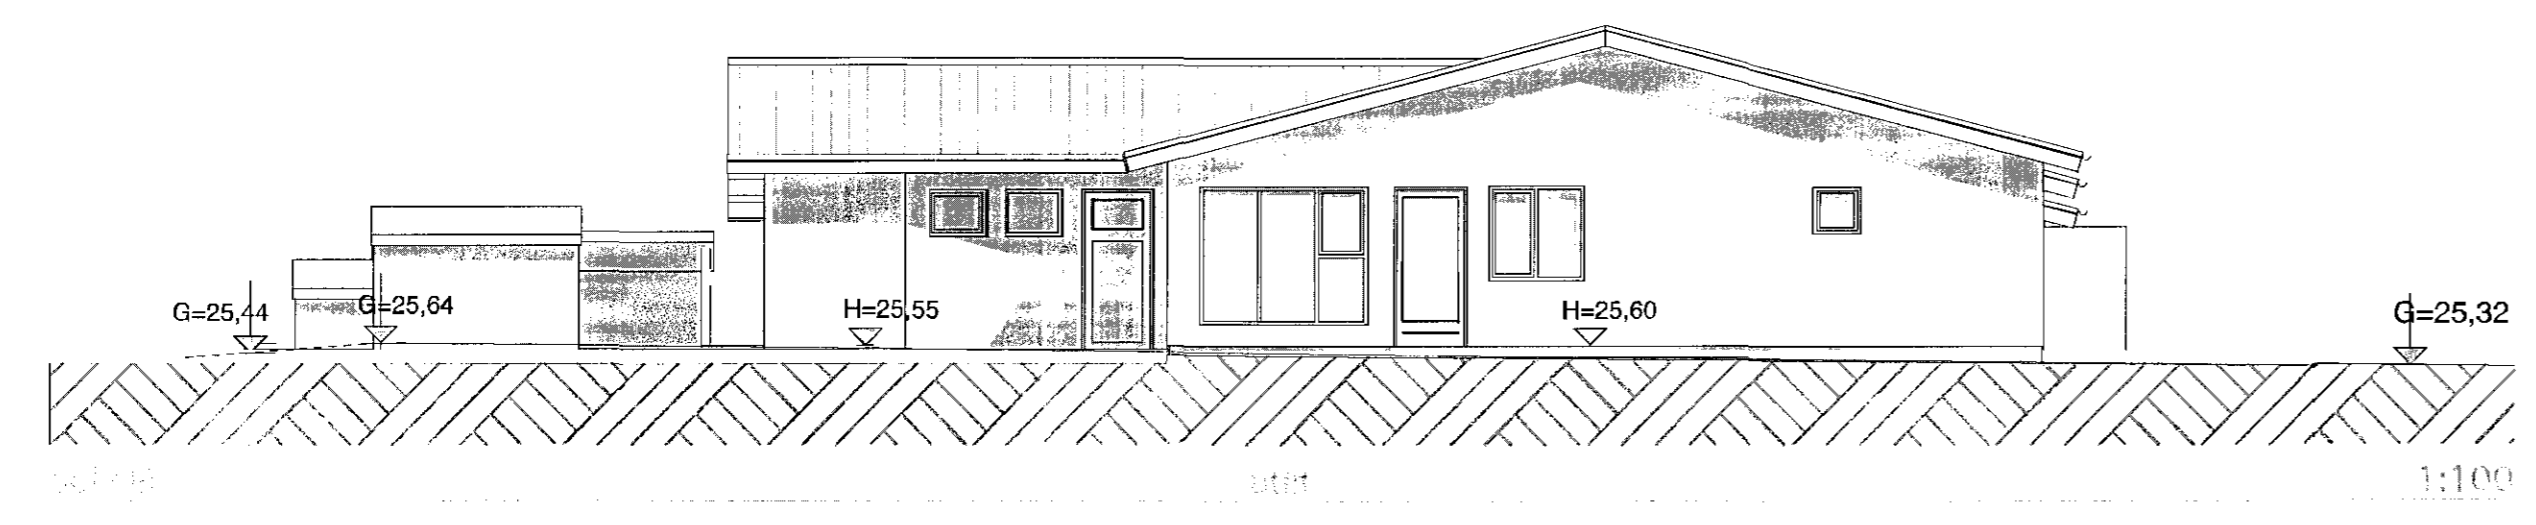


Samþykkt bann  
 n 7 OCT 2015  
 Byggingaáskilningur / Hafnarfirði  
 E.h. Sigurður Steinar Jónsson

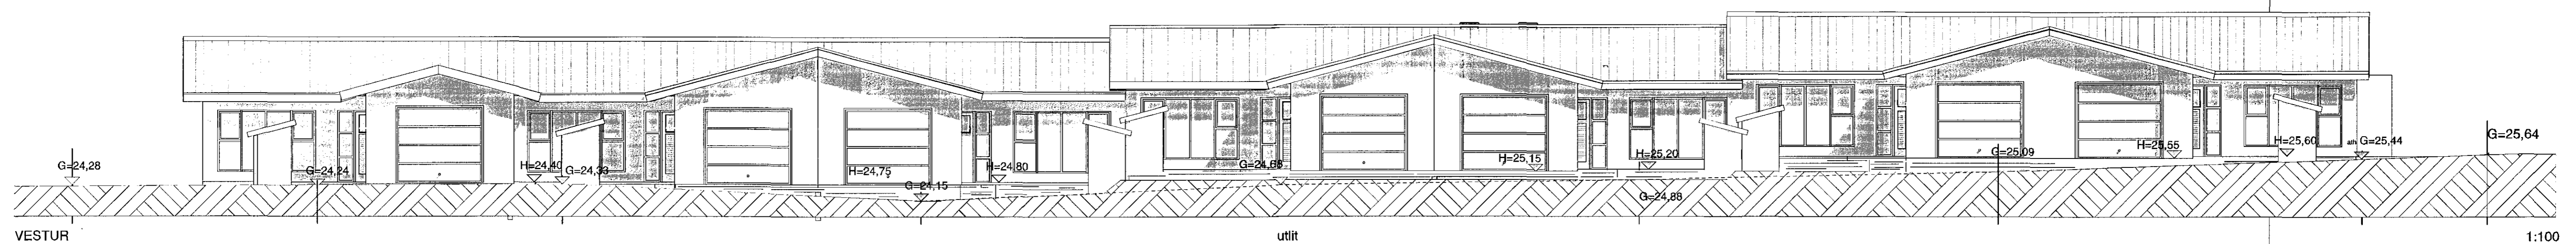

Breytt 23. sept. 2015.  
 Frekari frágangur, m.a. br. merking, hurð og veggur á milli  
 bílg. og íbúðar.

TEIKNISTOFAN Verkefni  
**KLUKKUVELLIR 28-38B**  
**HAFNARFIRÐI**  
 Helti ÚTLITSMYNDIR

kvardi	1:100	verk. nr. 2015-01
dags.	12 MARS. 2015	dags br. 23. sept. 2015
hönnun	G. G.	teikn. nr.
teikn	G. G.	<b>A-3</b>

Hringbraut 17 220 Hafnarfirði  
 s. 555-2020 FAX 555-2024  
 Gísli G. Gunnarsson BFL kt. 020649-2409  
 kvardi@kvardi.is

*G. Gunnarsson*