


LYRILMYND

ÓSEYRARBRAUT 22 - FRYSTIGEYMSLA EIMSKIPS


GRUNNMYND DAKHÆÐ MKV.1:100
 A-108
 ARKITEKTUR-VERKFAEGI-HÖNNUN
 Keppangí - Myranngí 600 Akureyri Sími 480 4400 - Fax 480 4401 - ark@ark.is www.ark.is
 Þingholtsstræti 27 - 101 Reykjavík Sími 561 4400 - Fax 561 4411

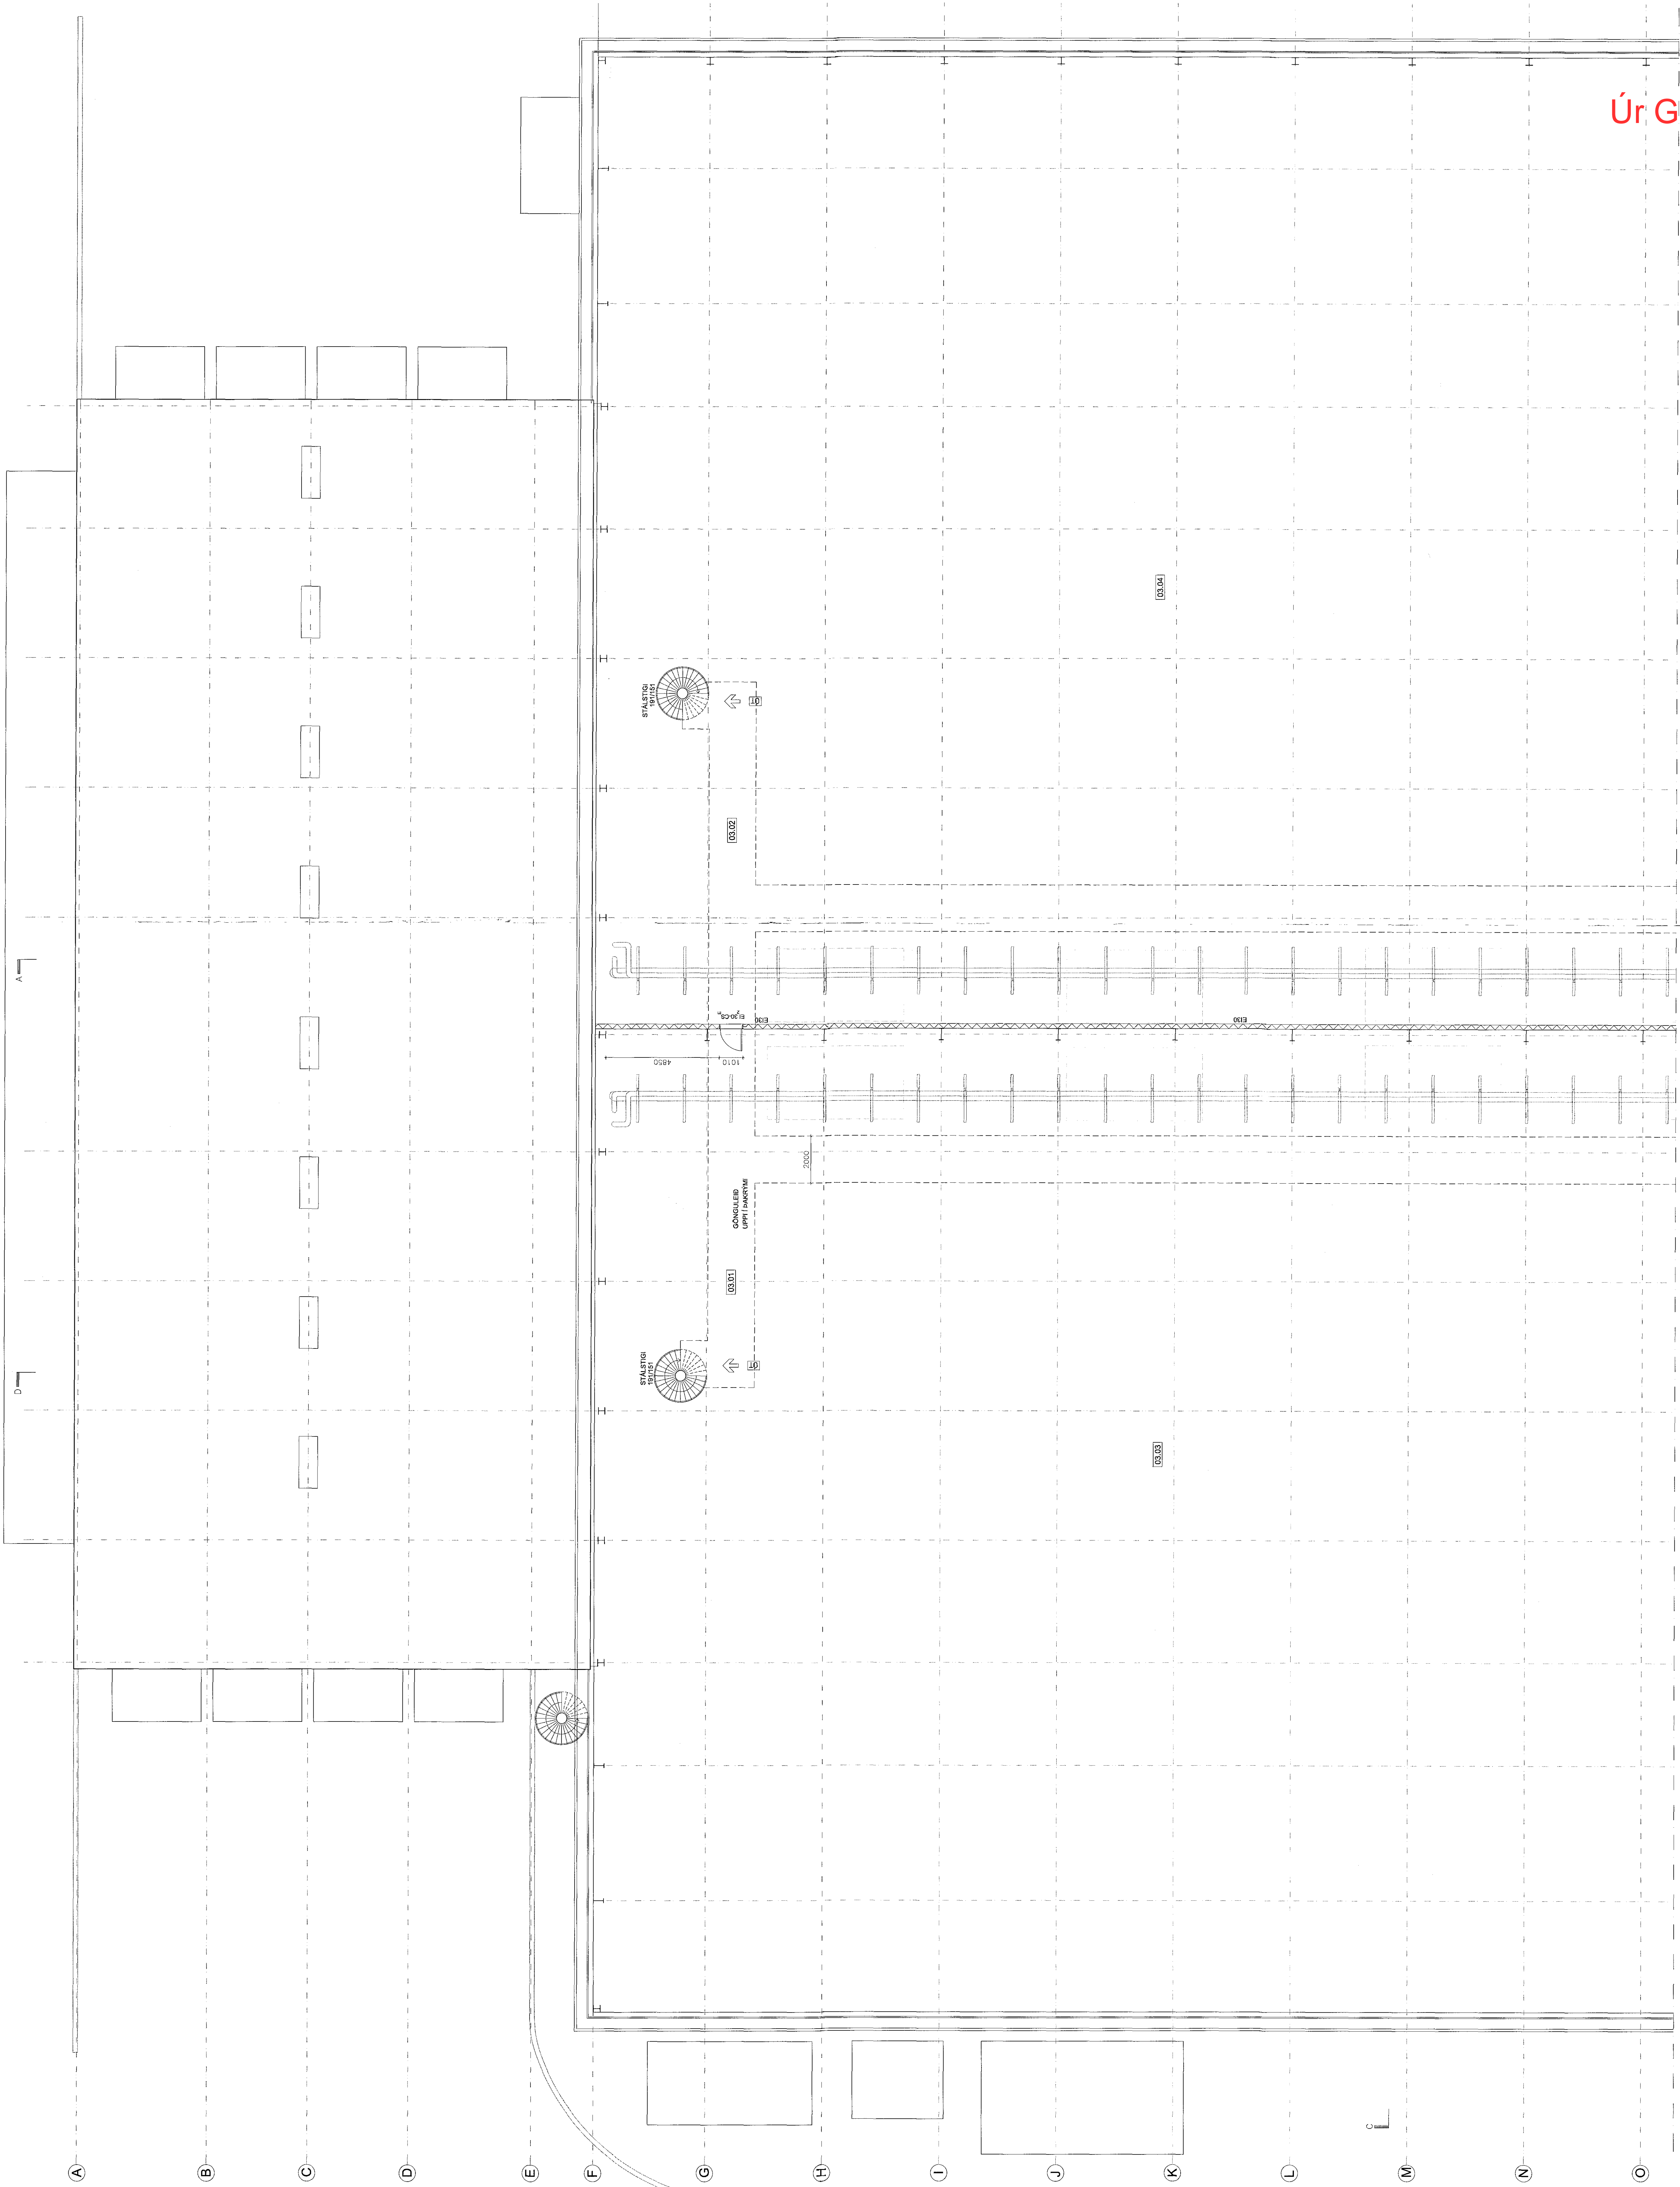

Úr Gildi



ARKITEKTUR-VERKFAEGI-HÖNNUN
