


MHL 01
1:100

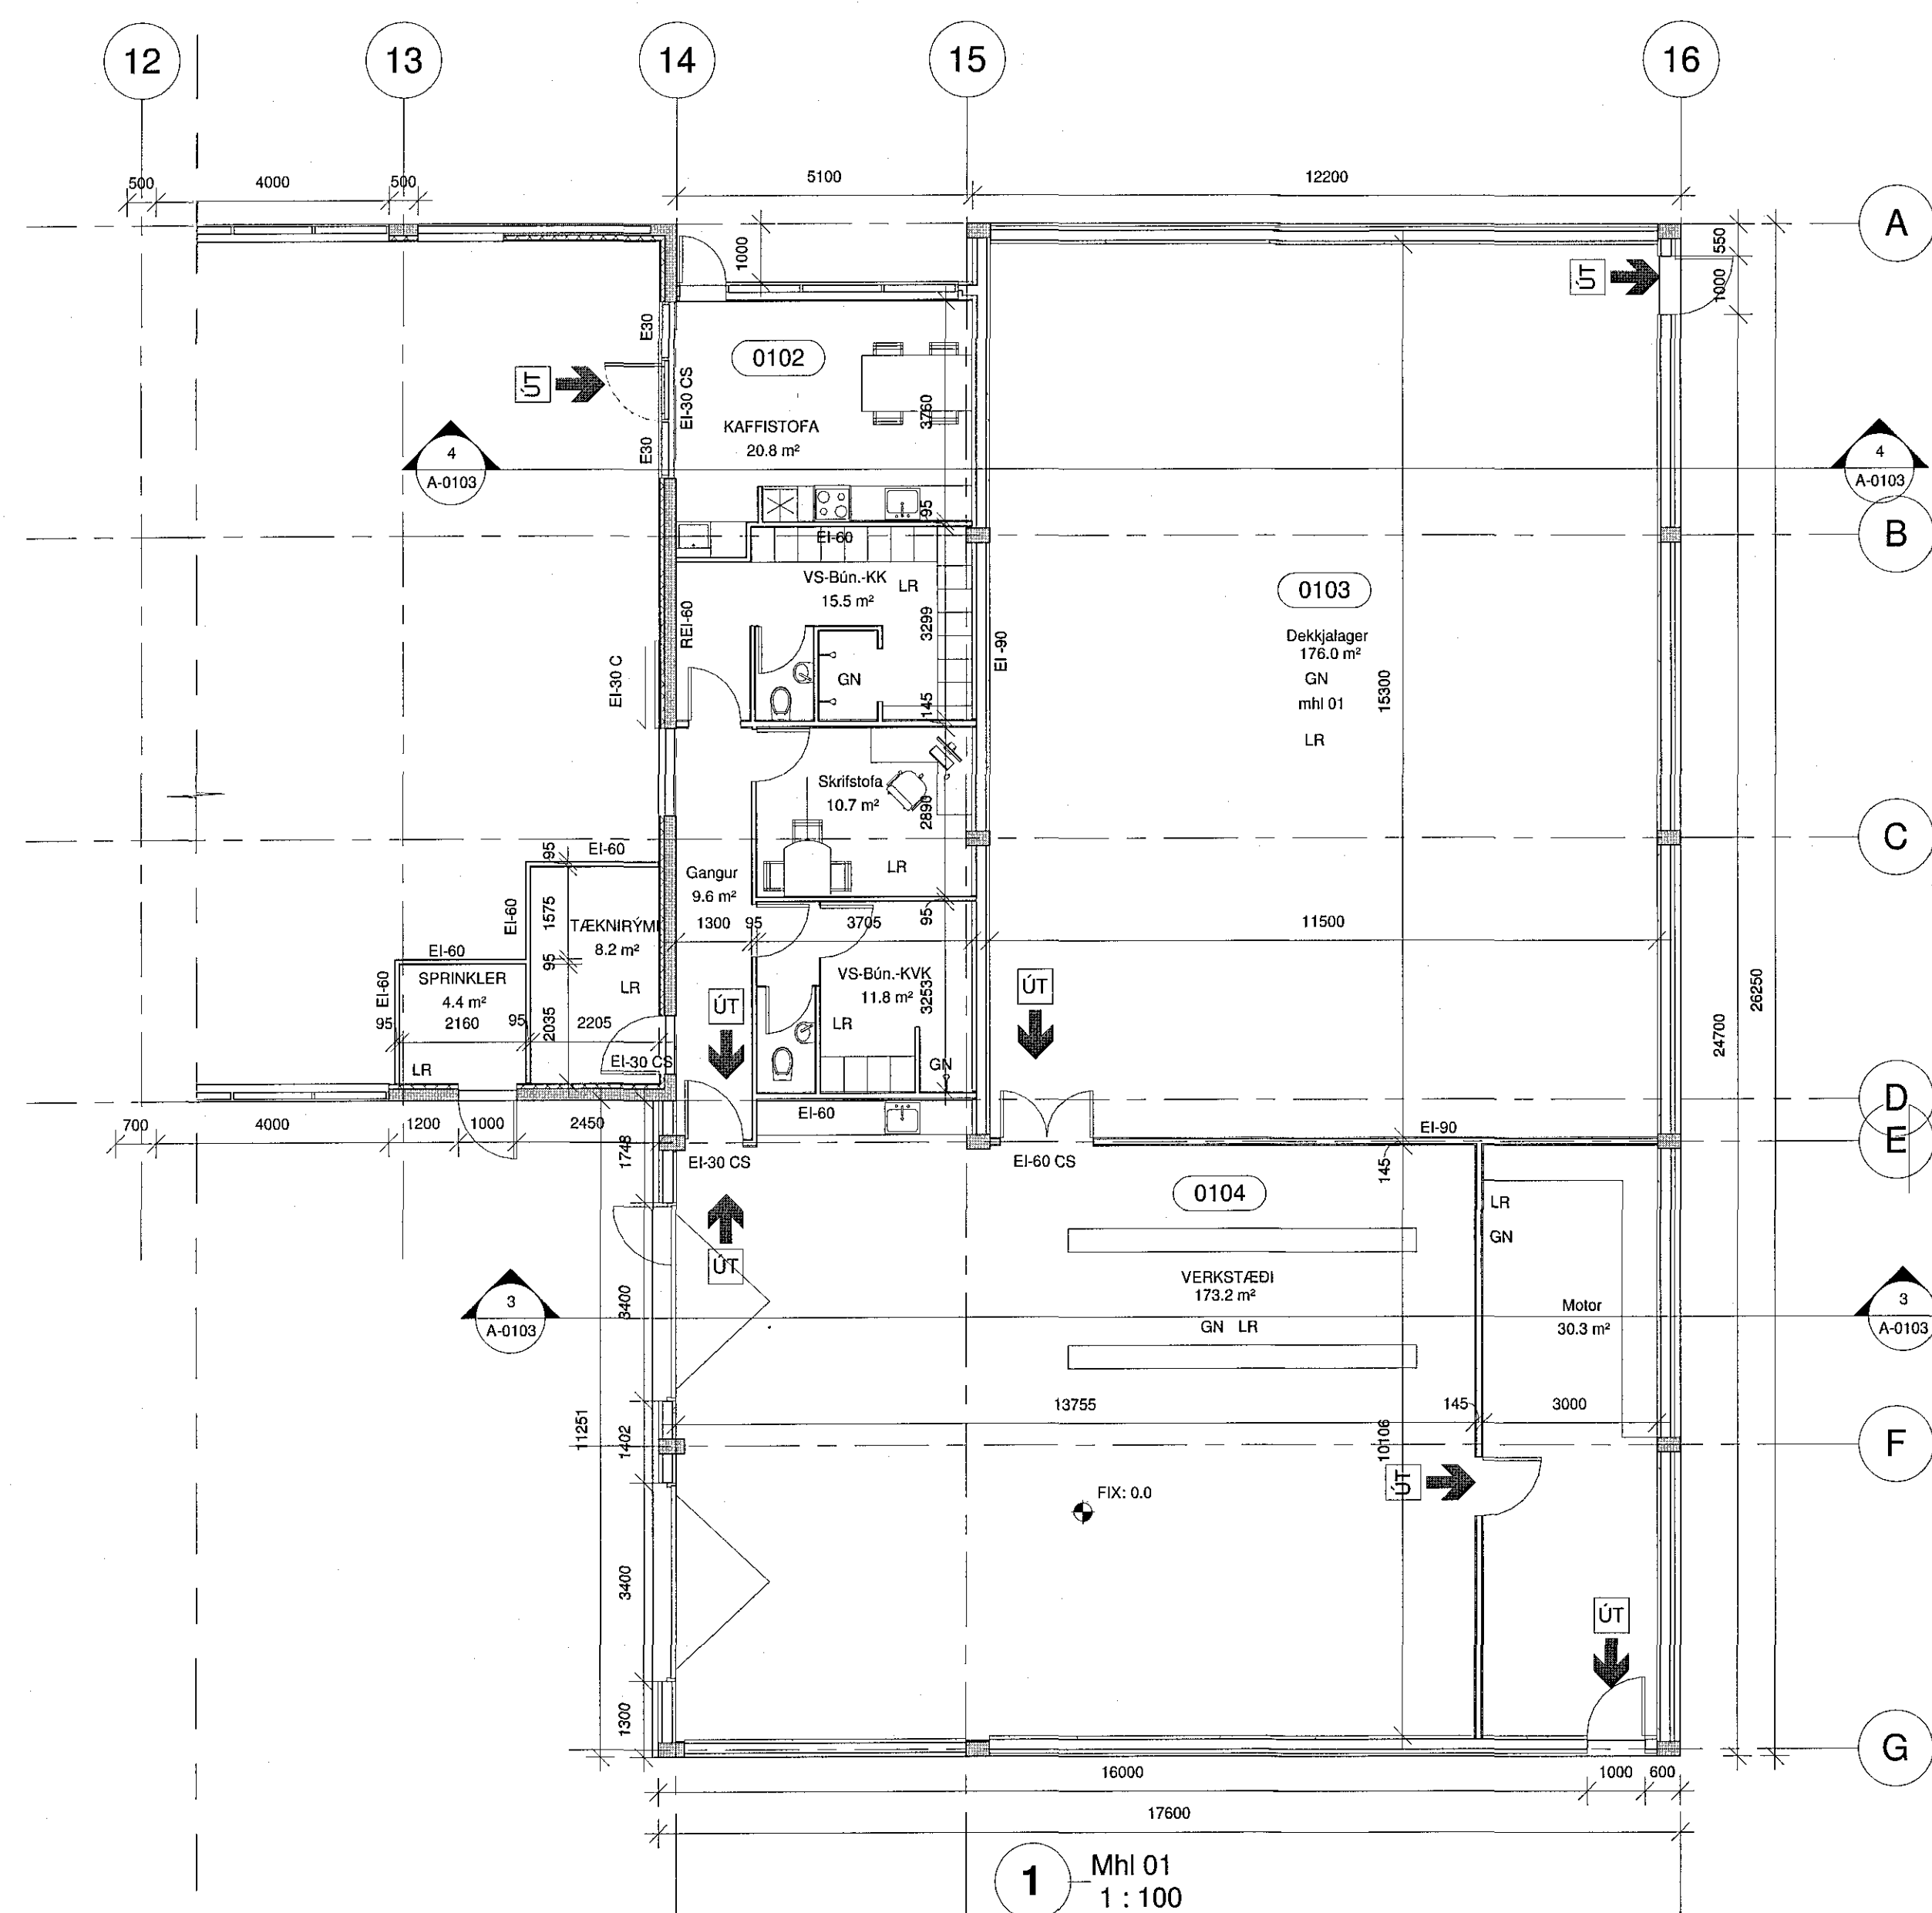

Mhl 01
1:100

Breytingar 24.02.2016:

mhl 01: Milliloft fjærlegt og innra skipulagi breytt
Staðsetningu salernis í móttöku breytt.

mansard

teiknistofa ehf

Bólholt 8 - 105 Reykjavík
www.mansard.is / jonhraf@mansard.is
Kt.: 570394-2079 - s:862-7102

Verkefni: Dalshraun 5

Efni: Aðaluppdrættir mhl 01
Grunnmyndir

Verkdúmer: A-16-02-01 Mkv.: 1:100 A1

Teikn. nr.: A-0101 Dags: 24.2.2016

Hannað: JHH Teiknað: JHH

Jón Hrafn Hildóversonn byggingafræðingur BFI

Kt.: 260662-6519

Samþykkt:

14.4.2016 09:49:38