

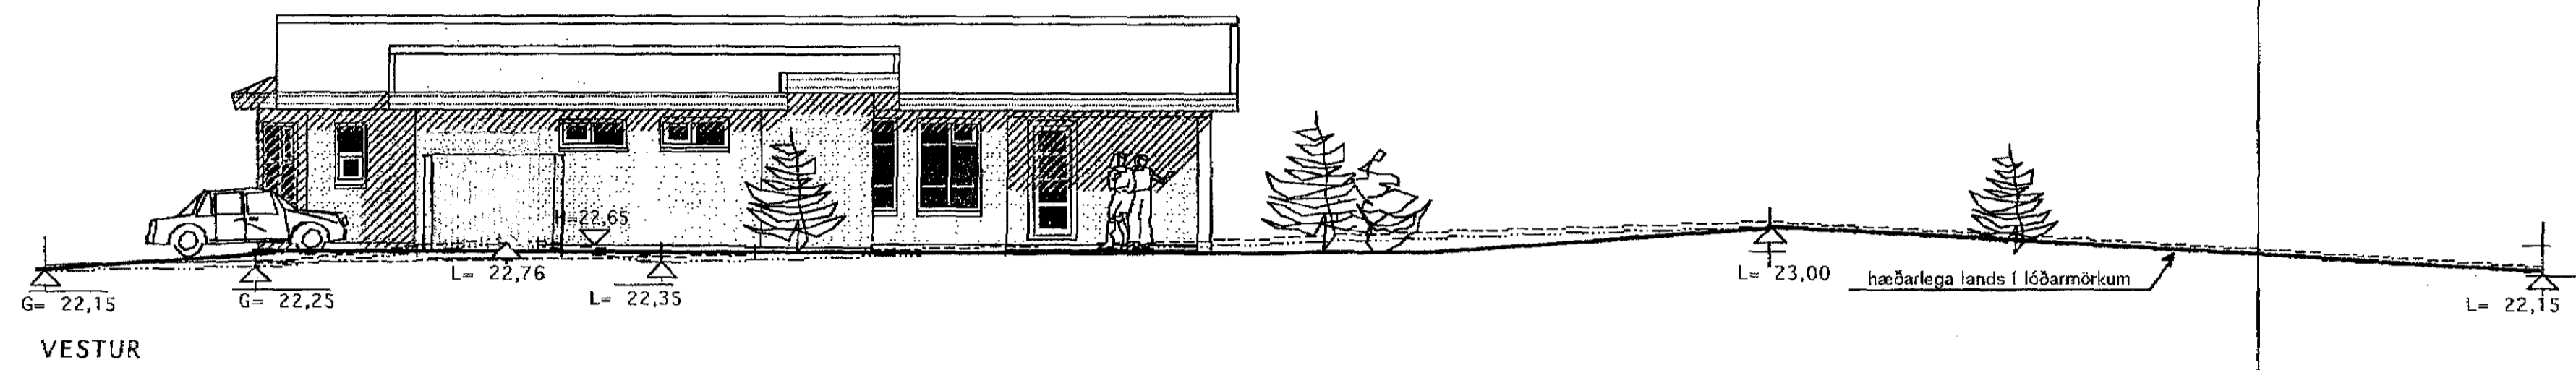
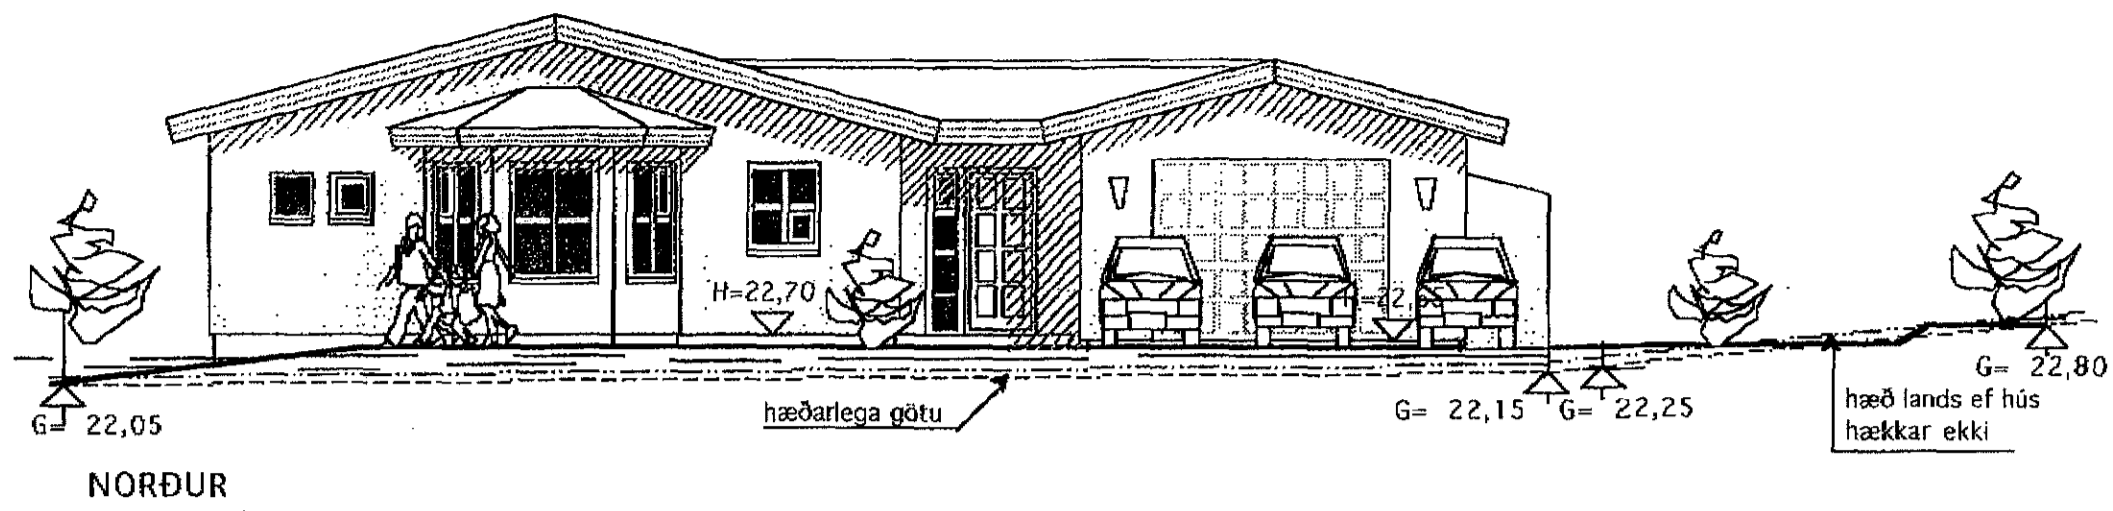



Samþykkt þann  
 08. júní 2016  

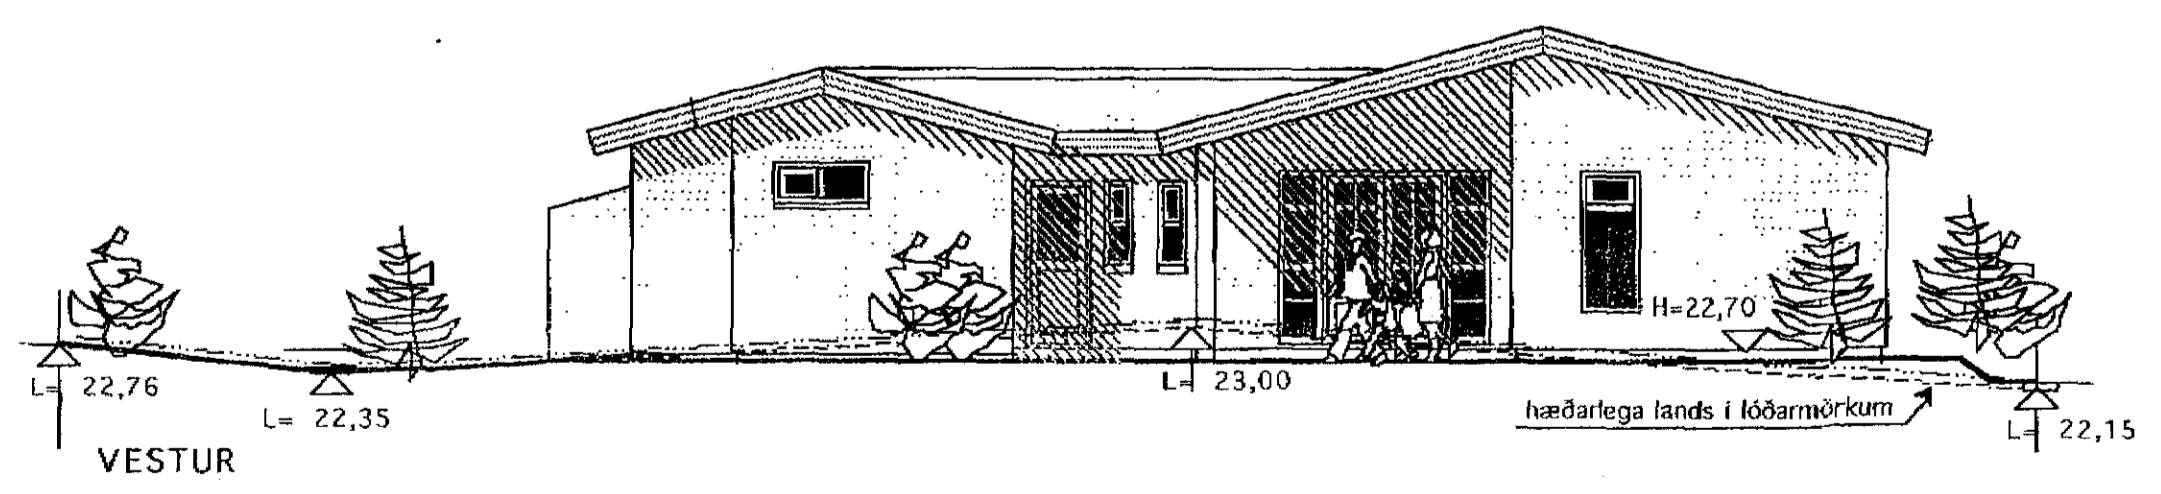

tifftopdf - www.rubissoftware.com - Demo Version

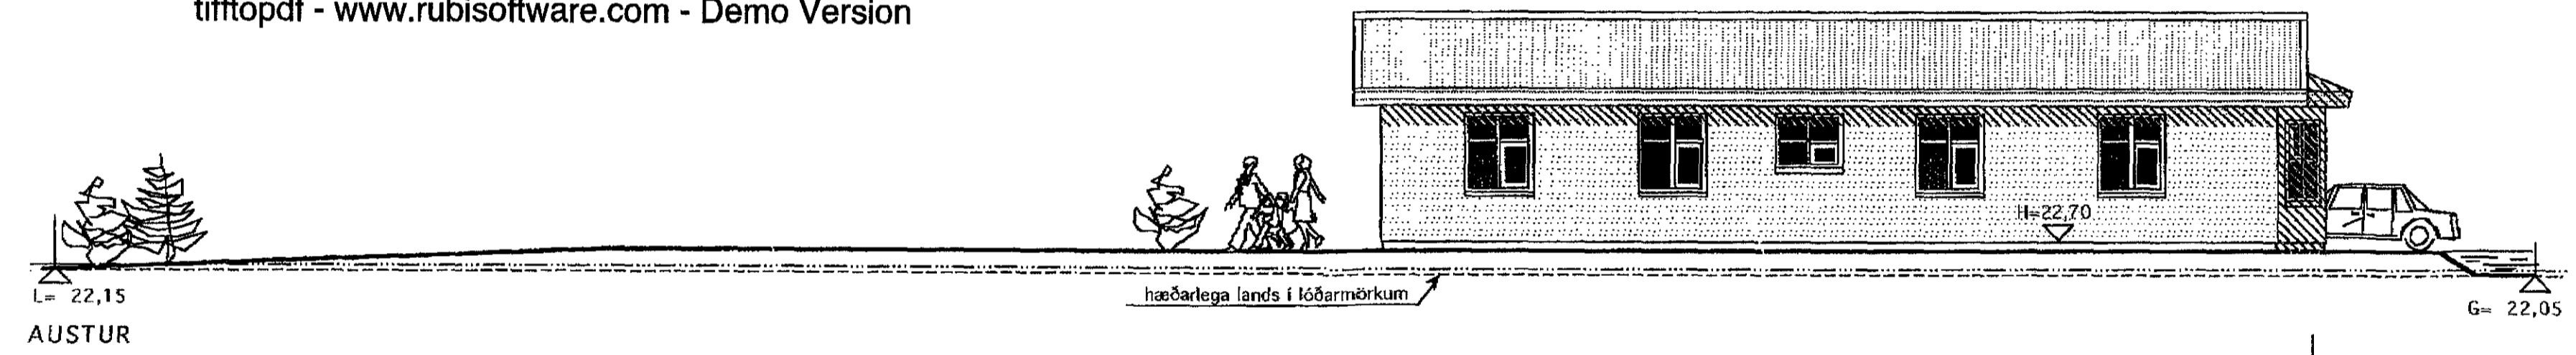

**Breytt 30. maí 2016.**  
 Minniháttar breytingar á innr. og stækkun sorpgeymslu

 <b>KVARÐI</b>	Verkefni	FURUVELLIR 35 HAFNARFIRÐI
	Heiti	ÚTLITSMYNDIR
kvarði	1:100	verk.nr.
dags.	5. NOV. 2003	dags br
hönnun	G. G.	teikn nr
teikn	G.G.	<b>A-3</b>

Hringbraut 17 220 Hafnarfirði  
 s. 555-2020 fax 555-2021  
 Gísli G. Gunnarsson BFI kt, 0206492409  
 www.kvardi.is www.kvardi.is vortex.is

*Gísli Gunnarsson*