


GP ARKITEKTAR

Verkefni: Hvaleyrarbraut 24

Grunnmýnd

Talning nr. 001A
 Mál 1:100
 Dags. 06.09.2016
 Tekniad GP

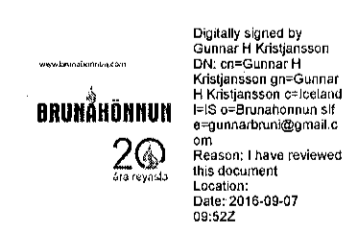

 20
 2016-09-07

Sturlandsbraut 20 108 Reykjavík
 Sími: 5511200
 5621790 gpar@gpark.is
 Gunnar P. Pálsson
 Kl. 291246-4519 Arkitekt FAL