

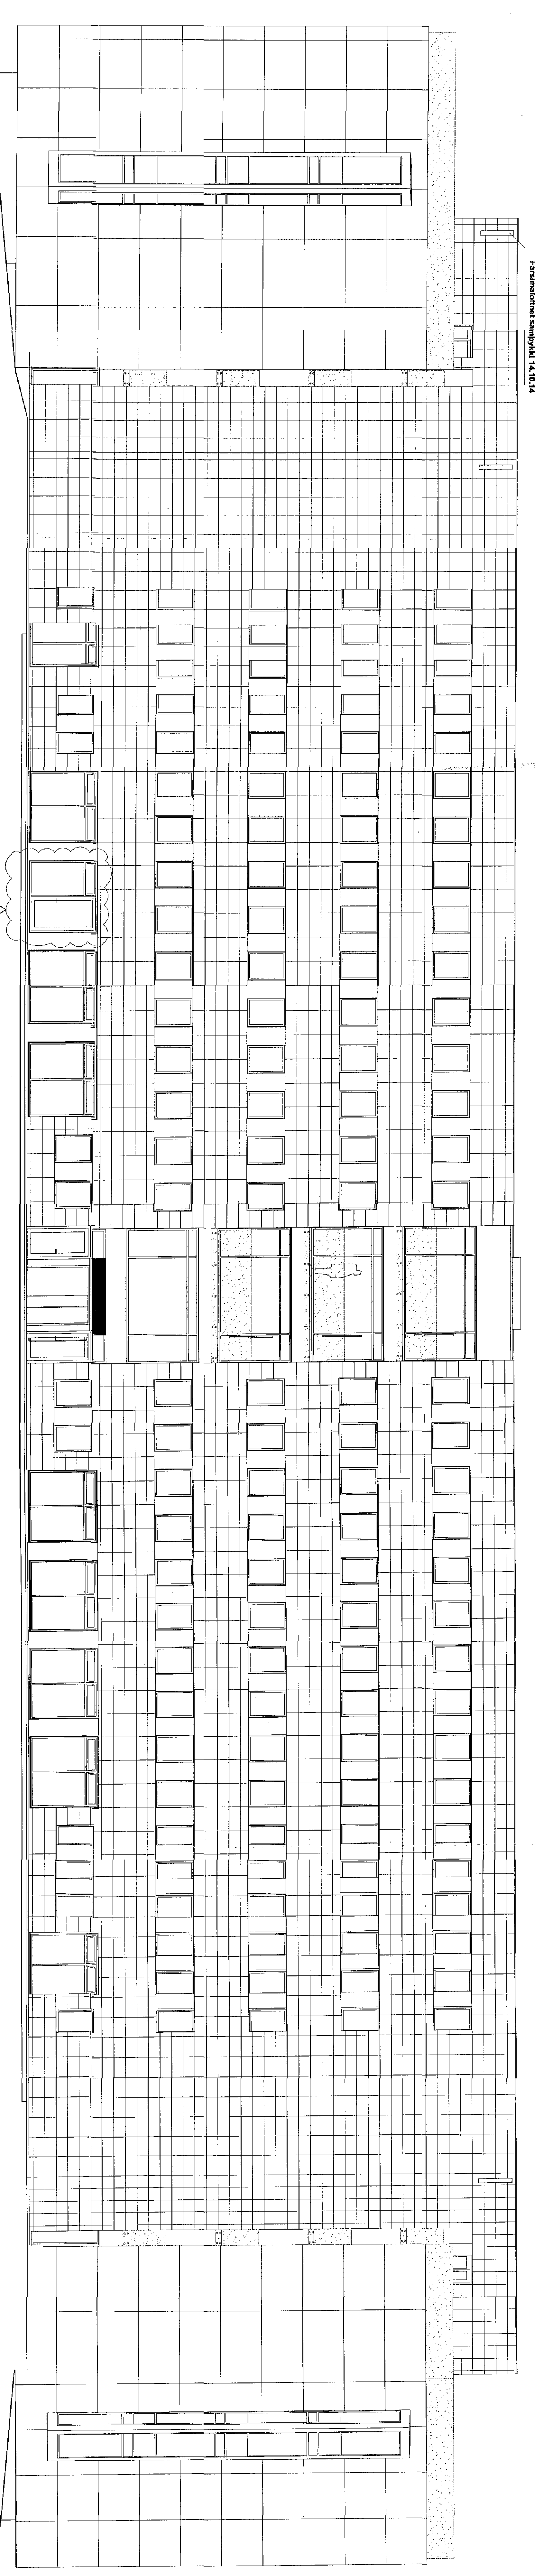


ÚTLIT NORÐ-AUSTUR

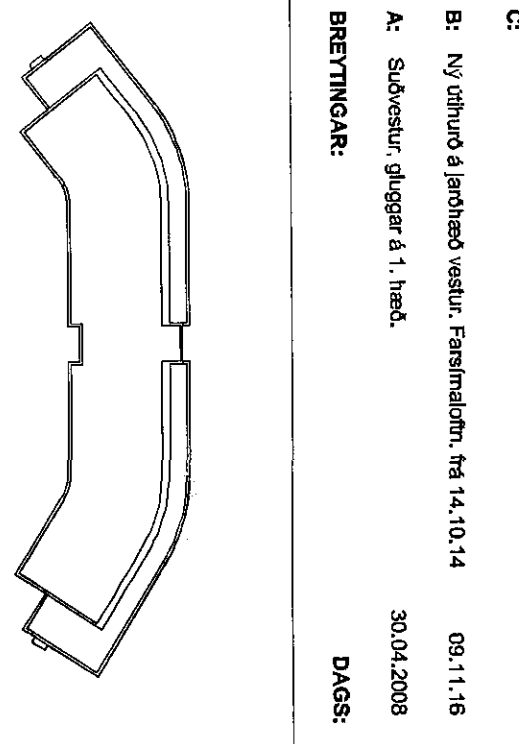

ÚTLIT SUÐ-VESTUR

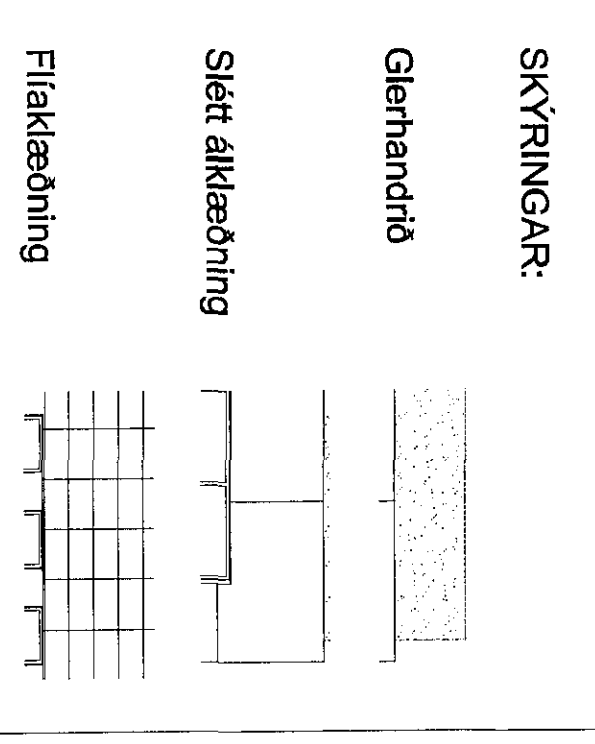

ABALUPPRÁTTUR

Dalshnan 3, Hafnarfóli  
 RIS ehf  
 VERC: DALSGÖR  
 NVAÐAR: 1100  
 DÁÐS: 31.10.2007  
 TERNK: GÖB  
 SKOÐ: 06/09/2008

ÚTI  
 ARKITEKTAR

SKOÐLITSTAKETI 27 081 REITVANG  
 HERNANDI 081001  
 BALDUR O. SVAVARSSON  
 73332244  
 LÖNUNARHENTVINGAR  
 07184-073