




Skútahraun 9a

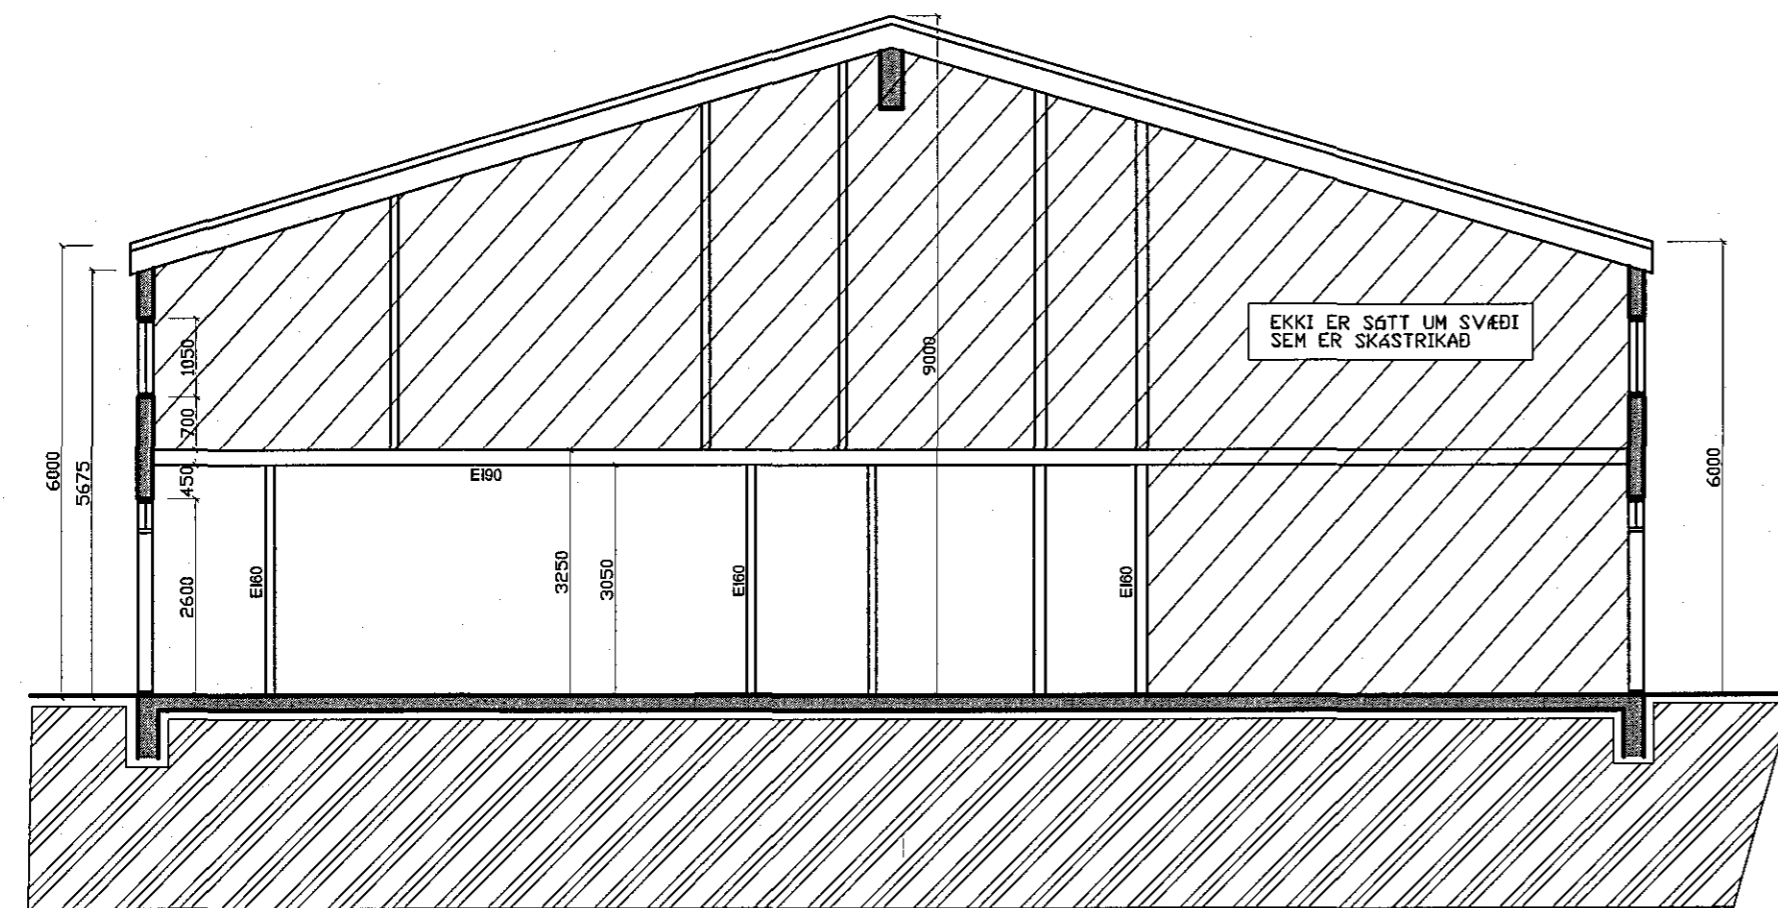

SNID A-A

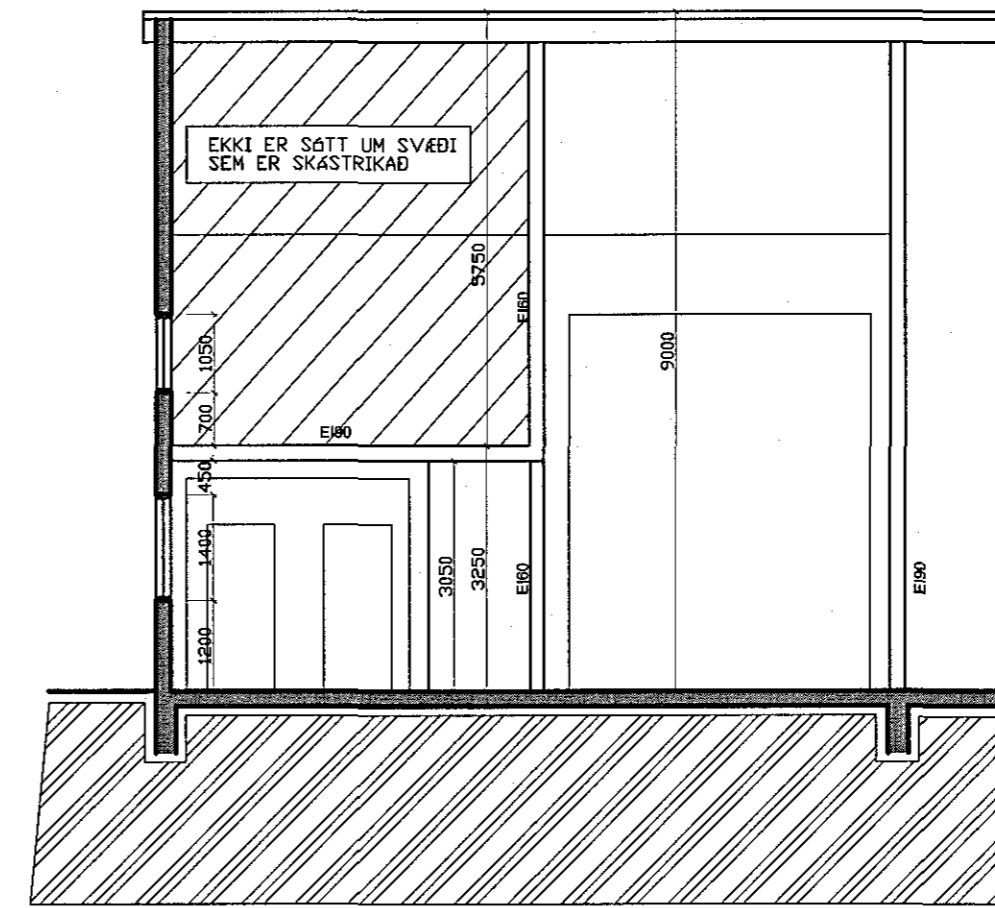

SNID B-B

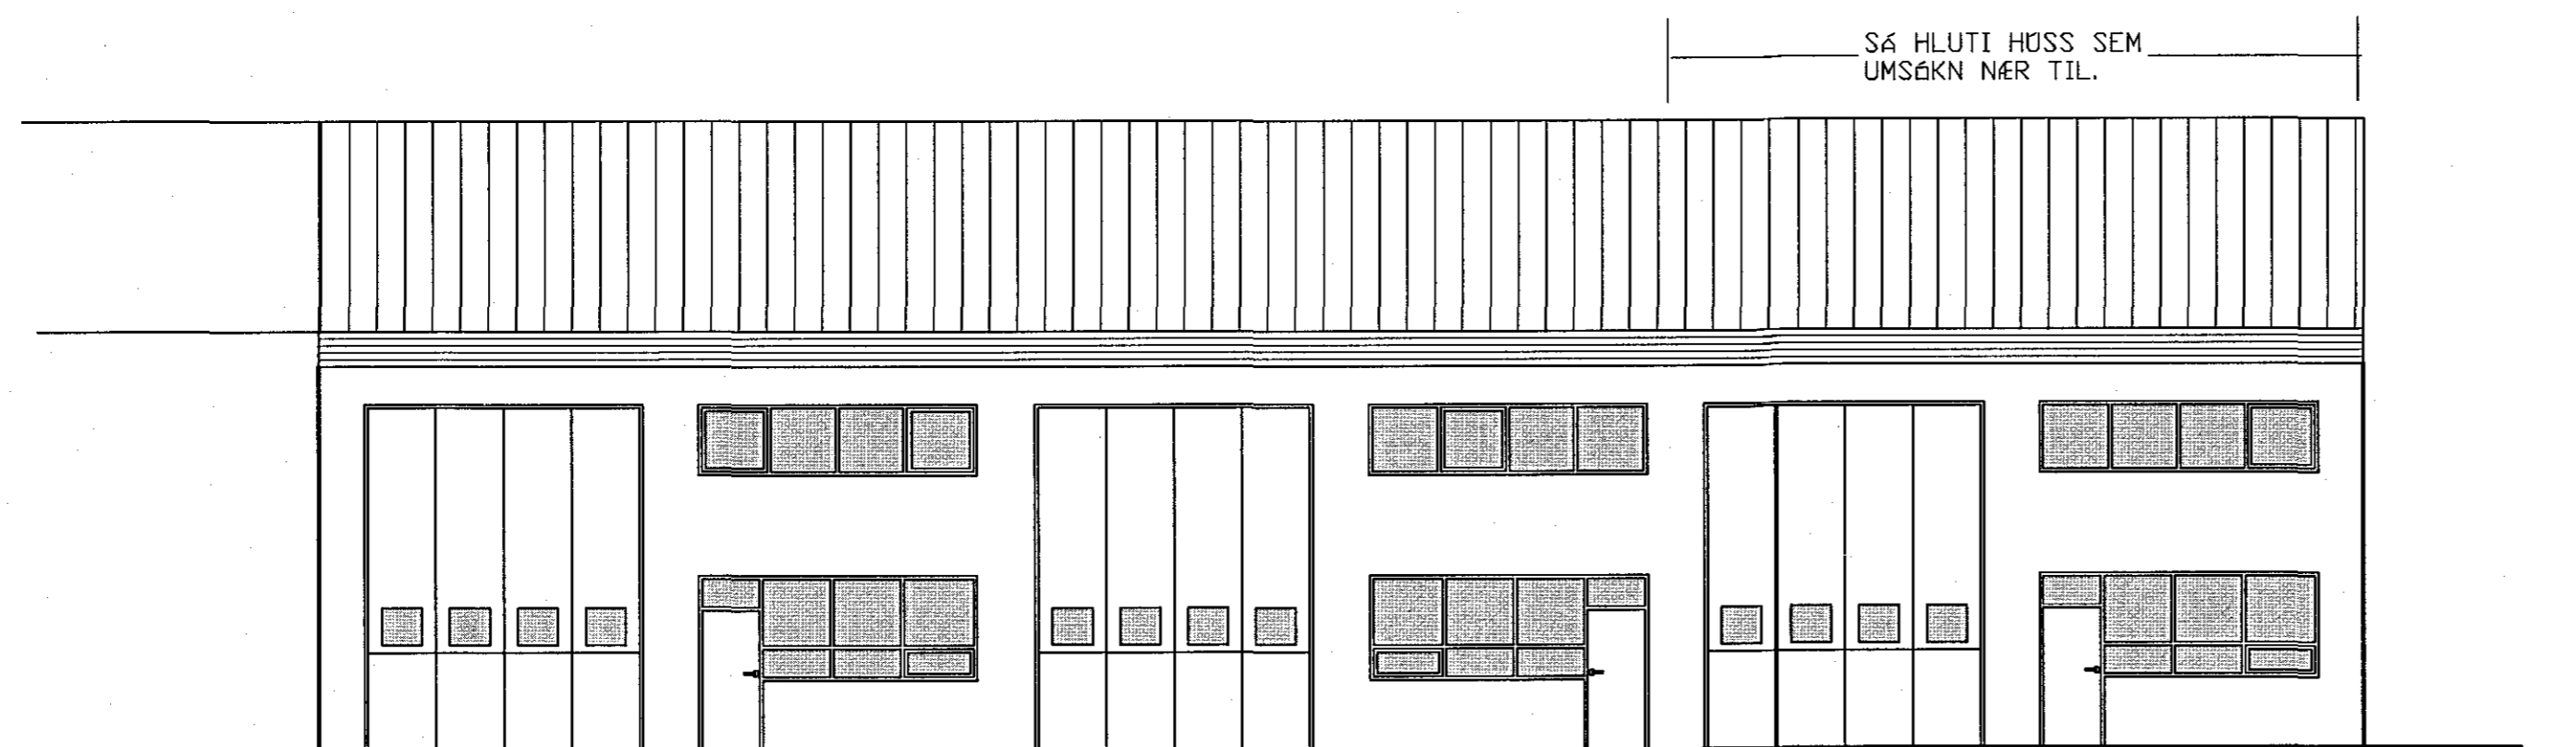

ÚTLIT, AUSTUR

BREYTING FRÁ ELDRI SAMÞYKKTRI
TEIKNINGU. HURD HEFUR VERIÐ FÆRD

Samþykkt þann

08. mars 2017

Byggingafultrúinn *M. Þorir*

Breyting: Dags: Lýsing:

ARKITEKTASTOFAN AUSTURVÖLLUR
FLÚDASEL 66, 109 REYKJAVÍK arkaust@mmedia.is

KRISTJÁN BJARNASON
BYGG.FR, BFI s: 698-6930
Kt: 120369-5479

VERKEFNI: **SKÚTAHRAUN 9a**
HAFNARFIRÐI

TEIKNING: **SNID - ÚTLIT**

DAGS/TEIKNAD: 20.11.2016/ KB BREYTING:

SIGN:

MÆLIV: 1:100

VERK NR: **A-322**

TEIKN NR: **A-2**

