
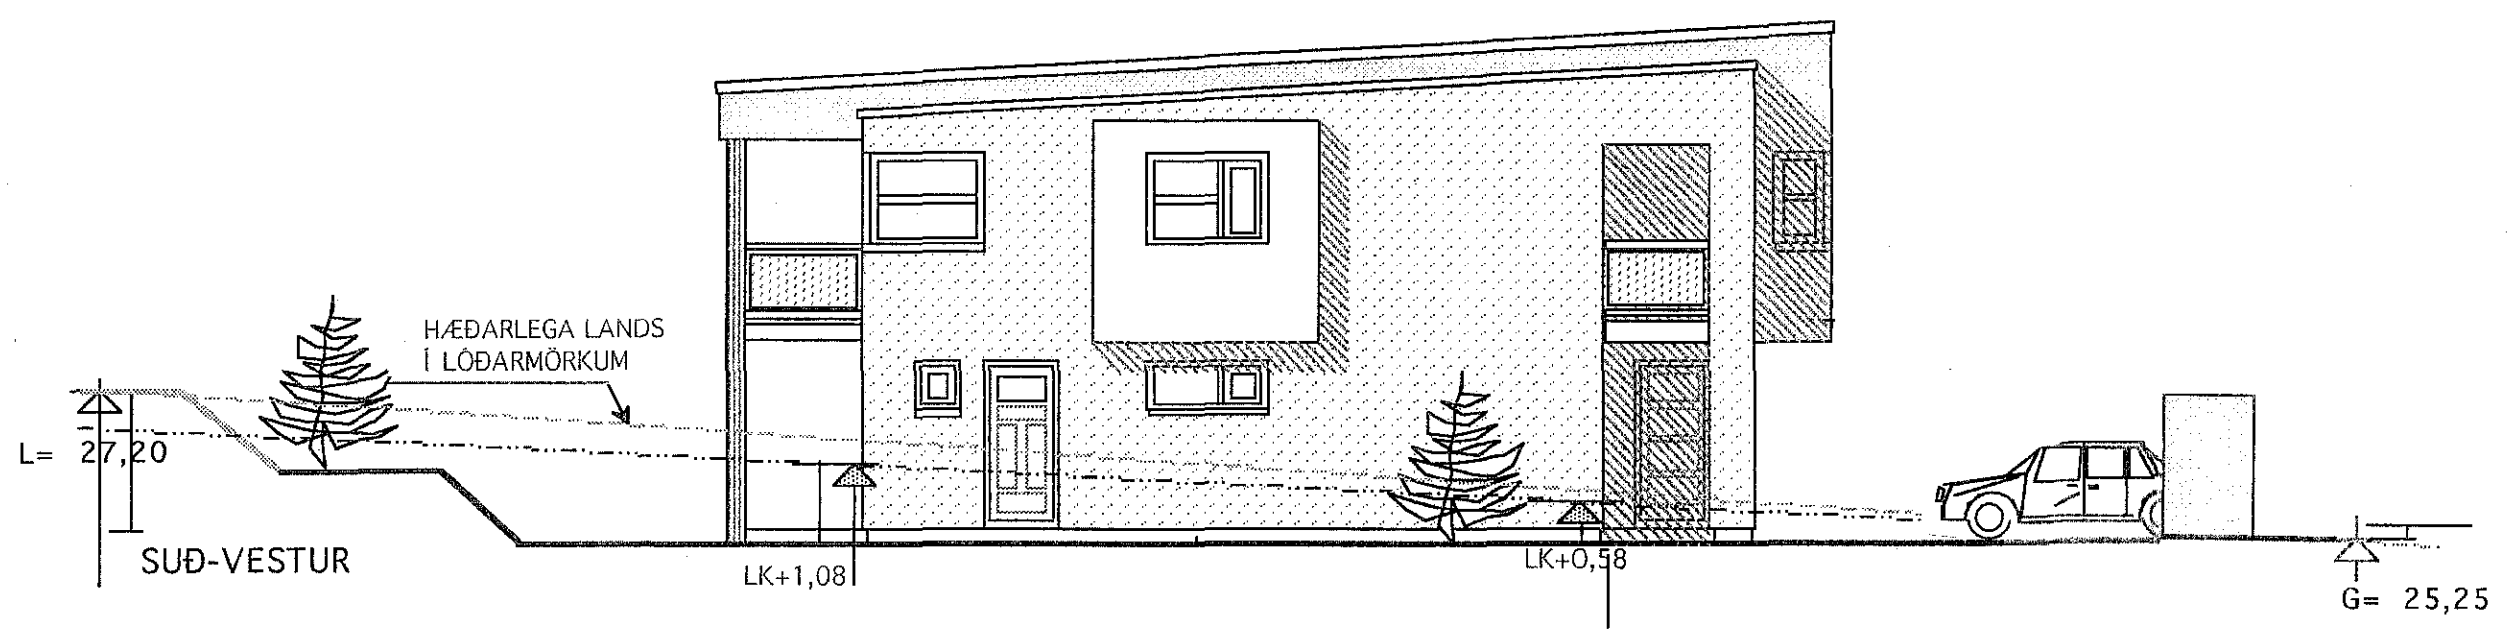
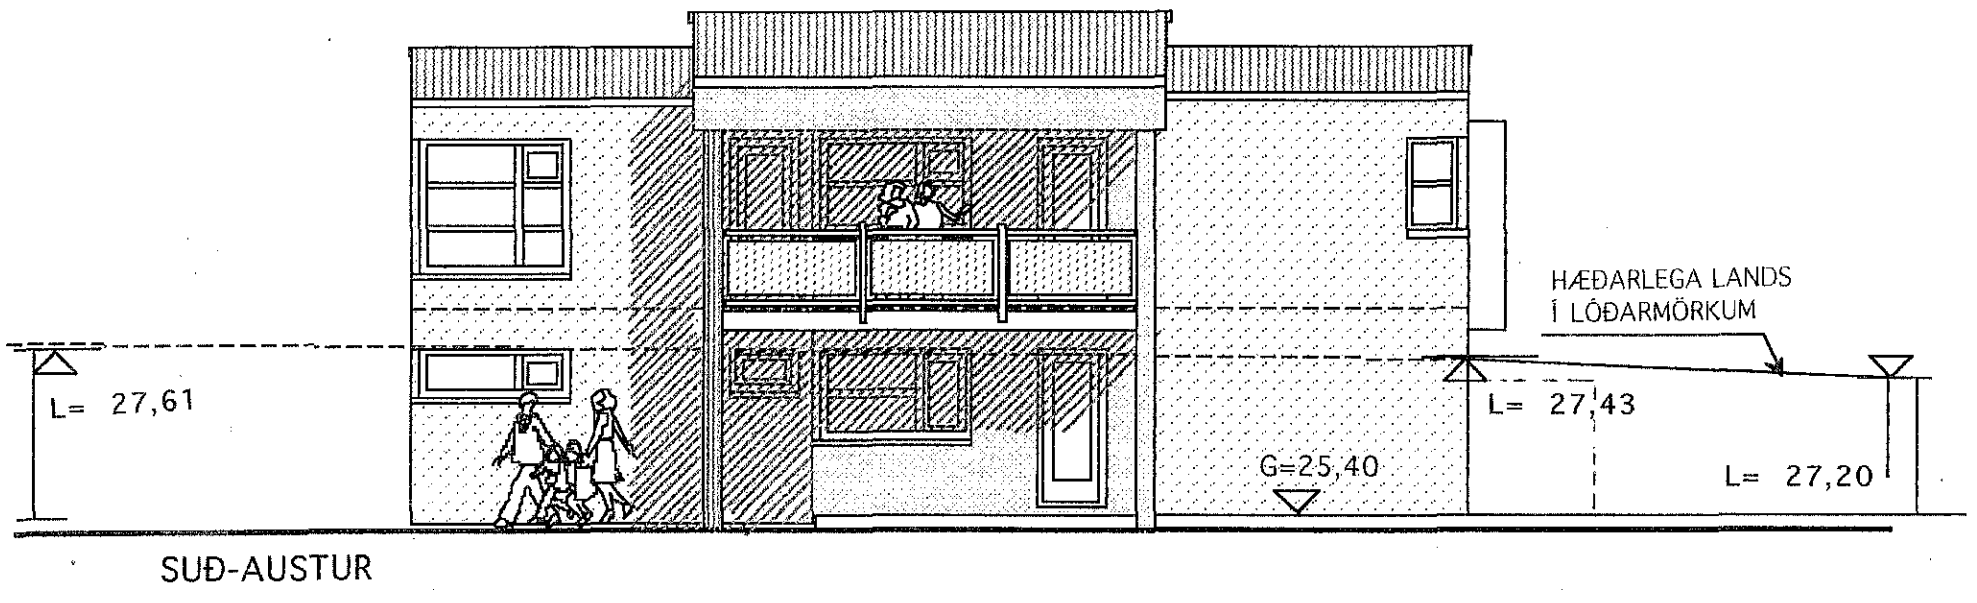
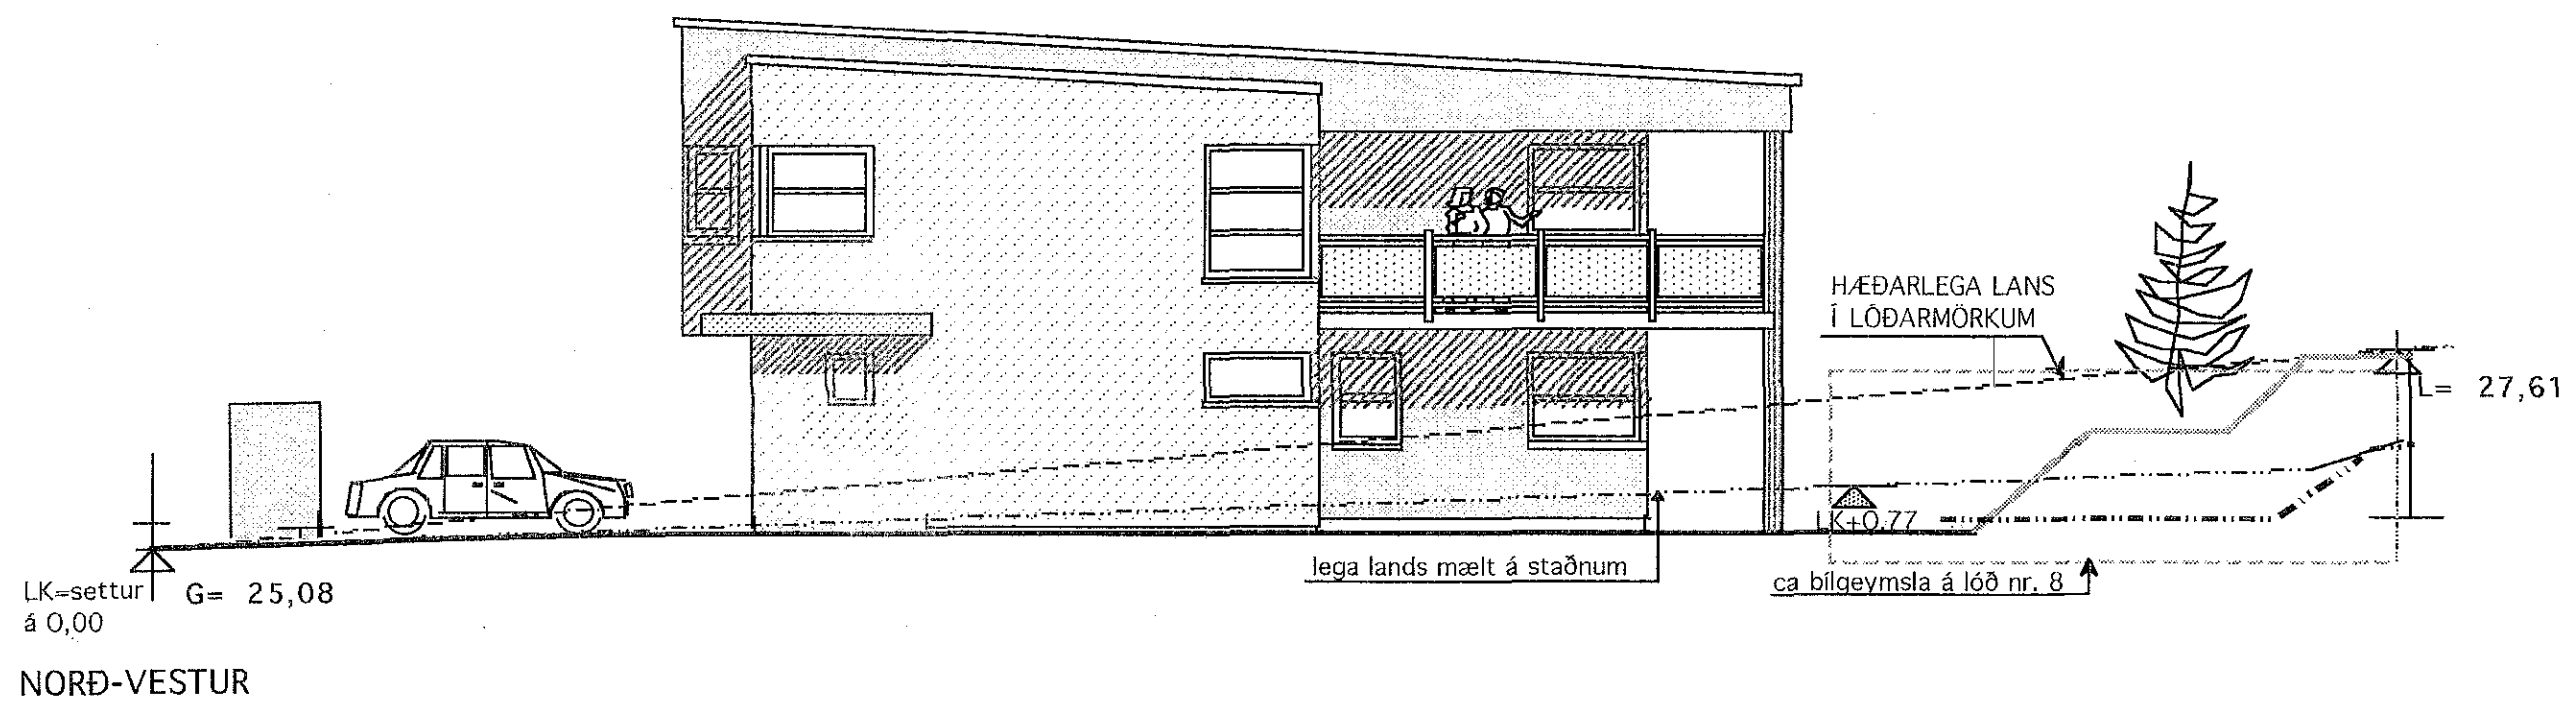


Samþykkt þann  
22. mars 2017  
Byggingafultrúinn *[Signature]*

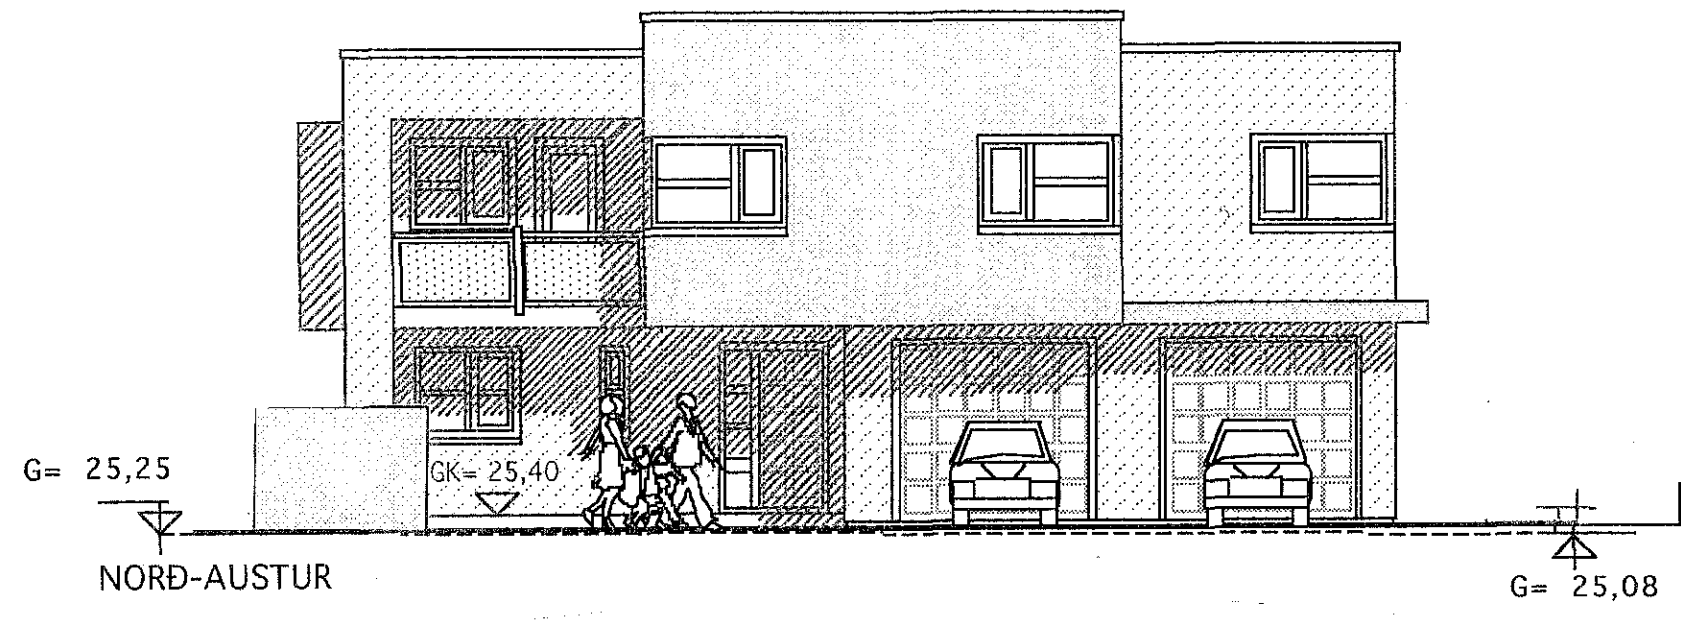

Breytt 24. feb. 2017. Reyndarteikning.  
Minniháttar breyting á innréttingum 2. hæð.  
+ færsla á sorpgeymslu.

Verkefni	
LINDARHVAMMUR 10 HAFNARFIRÐI	
Heiti	
ÚTLITSMYNDIR	
kvarði 1:100	verk.nr
dags. 10. nóv...2003	dags br. 24. feb. 2017
hönnun S. Ó. - G. G.	teikn nr
teikn G. G.	<b>A-3</b>

Gíslí G. Gunnarsson B.F.Í, kt. 020649-2409  
Hringbraut 17  
220 Hafnarfirði  
s. 555-2020 FAX 555-2021  
netfang: kvardi@vortex.is www kvardi.is

*[Signature]*