



Samþykkt þaga.
03. maí 2017
Byggingatillitunin

Upprunalegur hönnuður: -


FYLGISKJAL - BREYTINGAR **Úr Gildi**
- - - - - Viðbygging

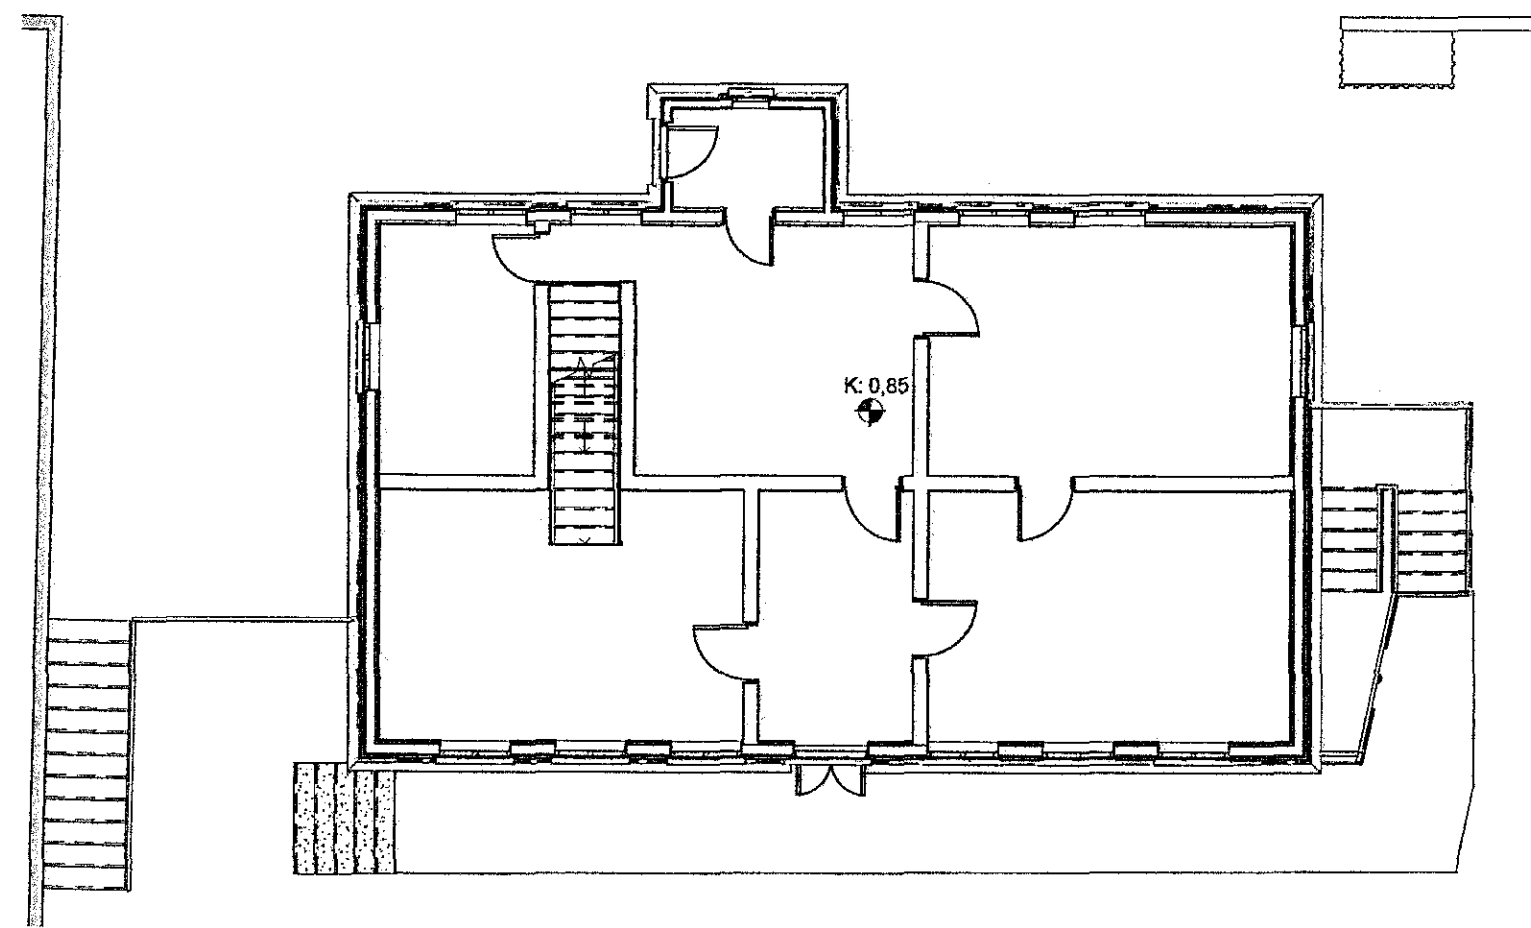


1. GRUNNMYND - BREYTINGAR
1 : 100

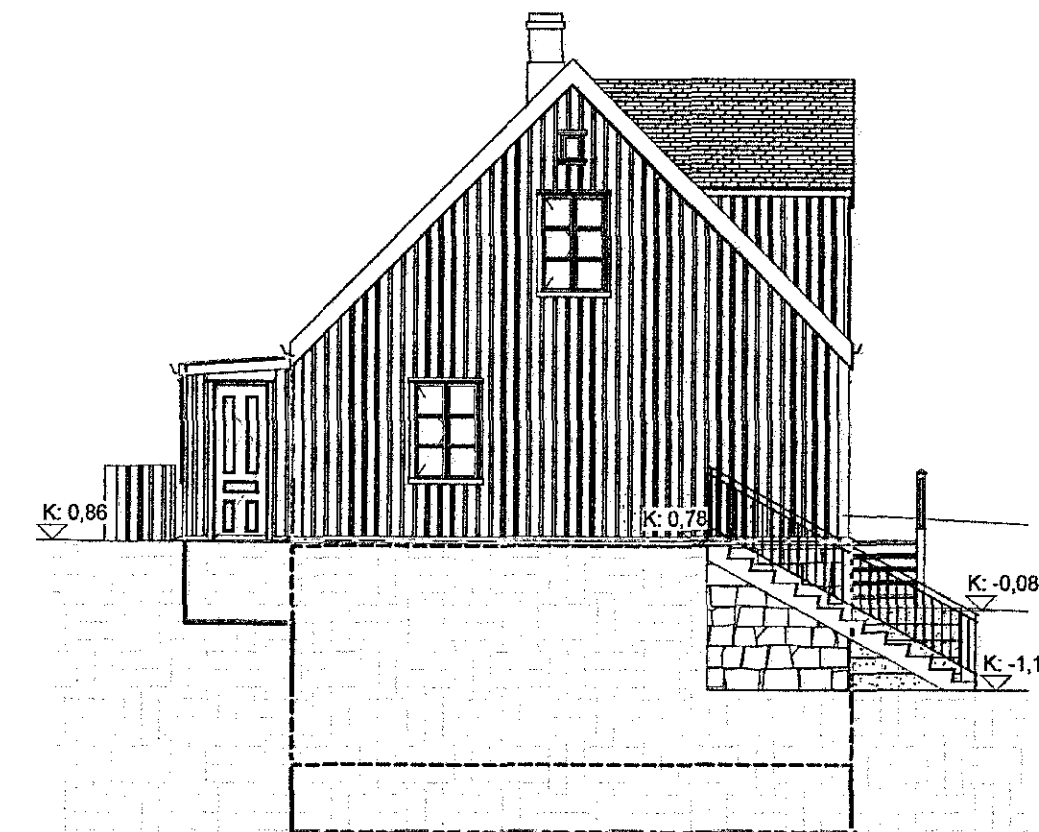


VESTUR - BREYTINGAR
1 : 100

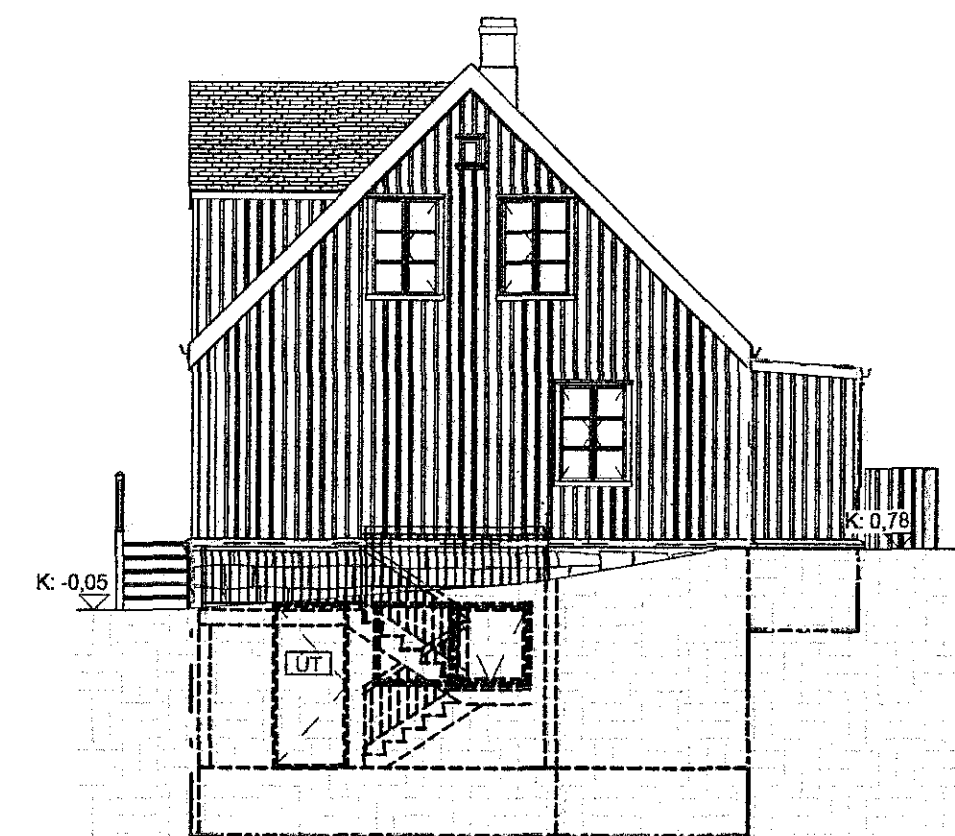

AUSTUR - BREYTINGAR
1 : 100

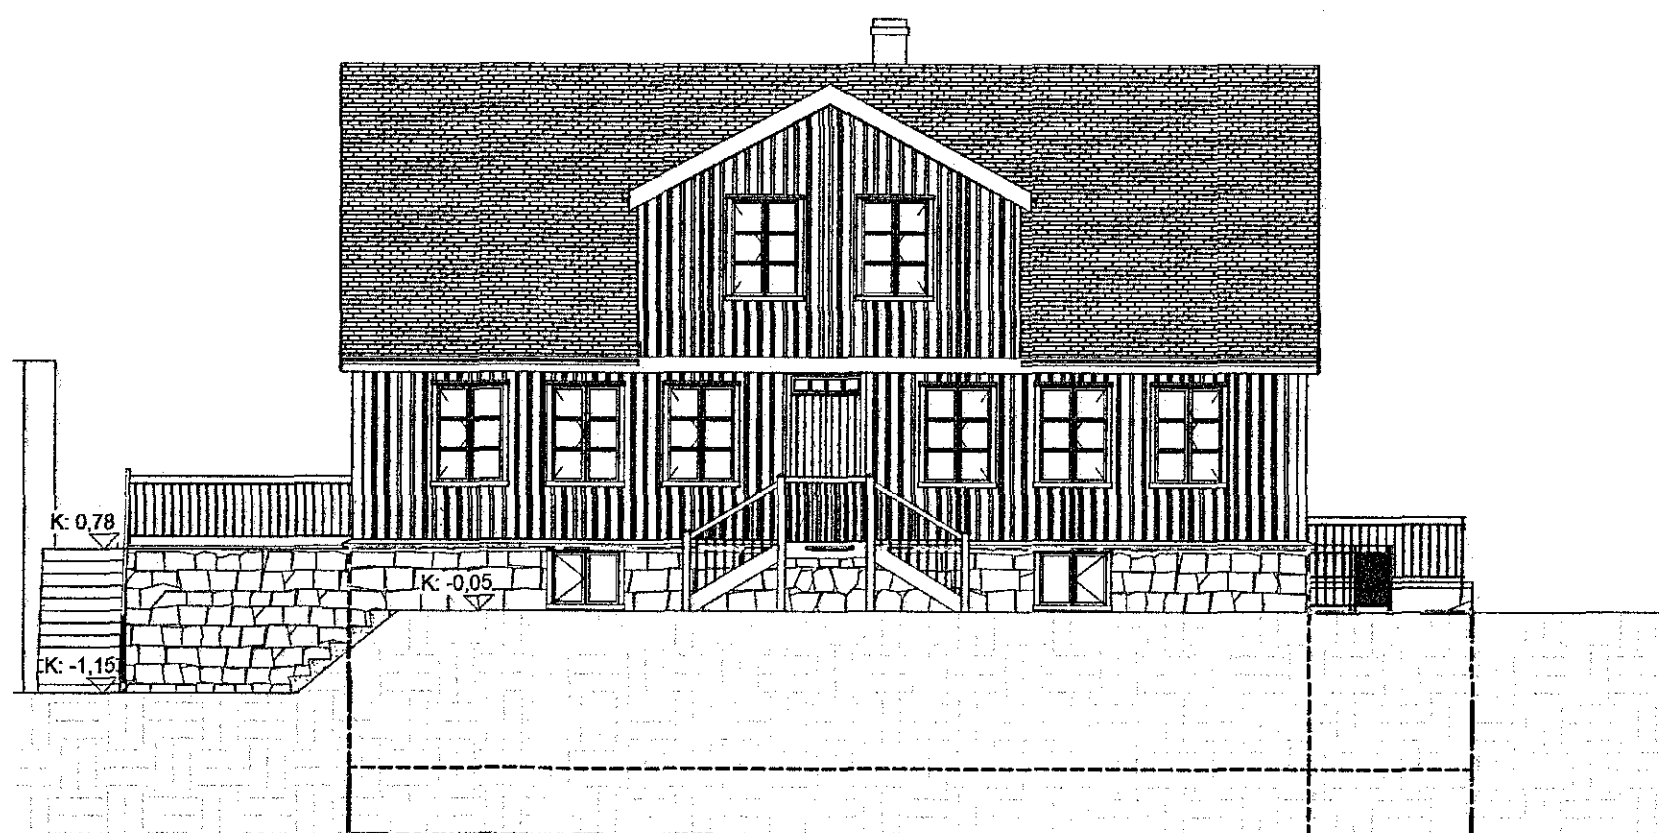

SUBUR - BREYTINGAR
1 : 100

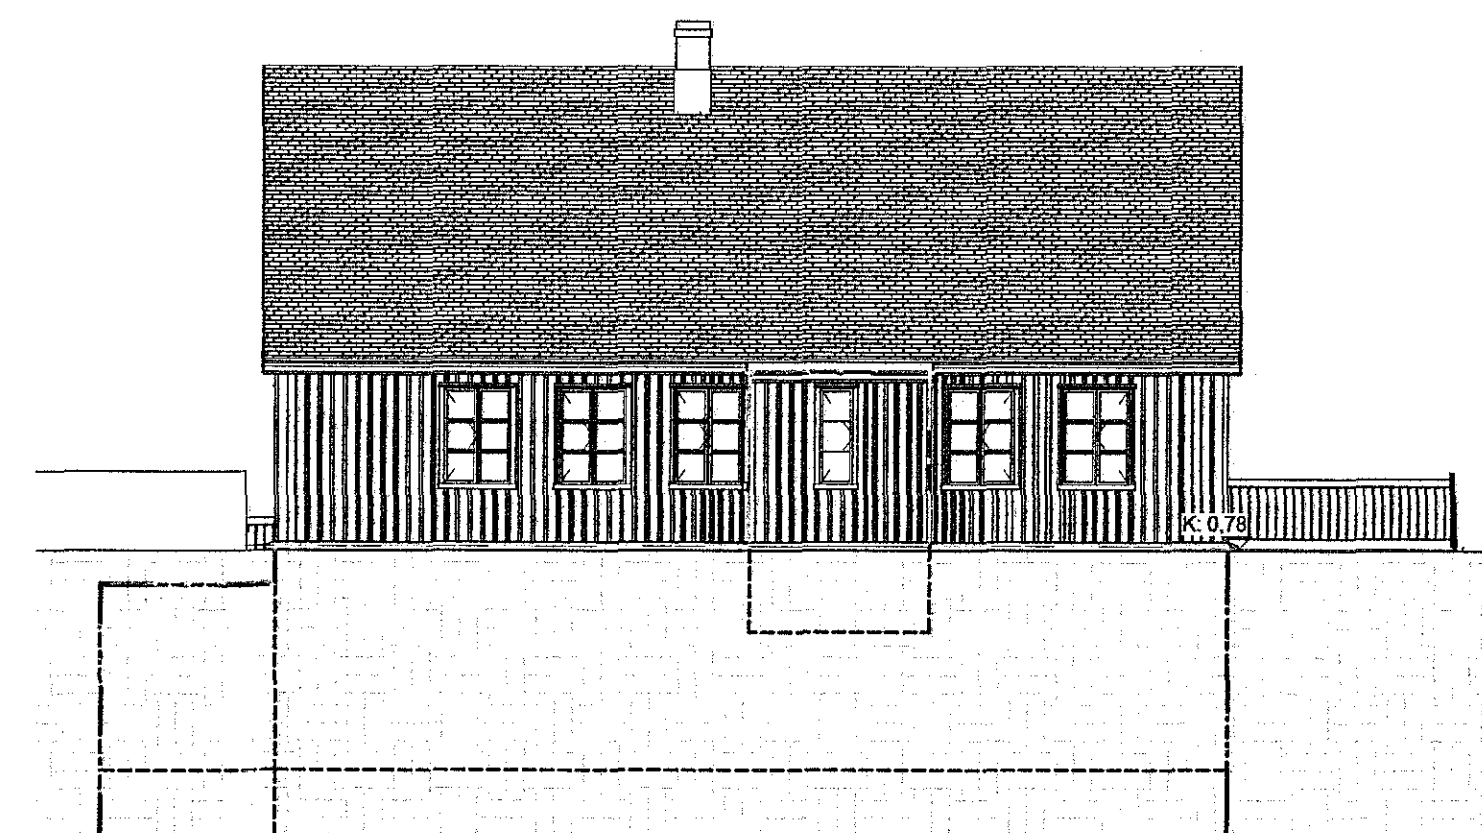

NORÐUR - BREYTINGAR
1 : 100

| | | | | |
|------|--------------------|------------|---------|-----------|
| 1 | ADALUPPDRÁTTUR | 27.04.2017 | SE | RS |
| Utg. | Skýring / Breyting | Dags. | Teiknad | Yfirfarid |

Fiskveiðihlutafélagið Venus
VERKKAUFI / EIGANDI
Endurbygging
TEGUND VERKS

Austurgata 12
GATASTADSETNING

ADALUPPDRÁTTUR
Fylgiskjal - Breytingar

LANDNÚMER: 120011
STADGR.: 1400-1-05100120
MHL: 01
MKV: 1:50
BLAÐST/ERD: A2
ÚTGÁFA DAGS: 24.11.2016
TEIKNAD: RS
YFIRFARIÐ: SE

1621
VERKNR.

305 - 1
RADNR. ÚTGAFA



Jón Ólafur Ólafsson FAI
kt: 090358-4099
Sigurður Einars son FAI
kt: 110457-2789

BATTERIÐ | ARKITEKTAR
Hvaleyjarbraut 32 | 220 Hafnarfjörð | S: 54 54 700 | batteri@arkitekt.is | www.arkitekt.is

© BATTERIÐ | ARKITEKTAR
ÖLL AFRYKT OG AFRYKTUN TEIKNINGAR AD HLUTA EDA I HEILD ER HÁÐ SKRIFLEGU LEYFI HC FUNDA