



Úr Gildi

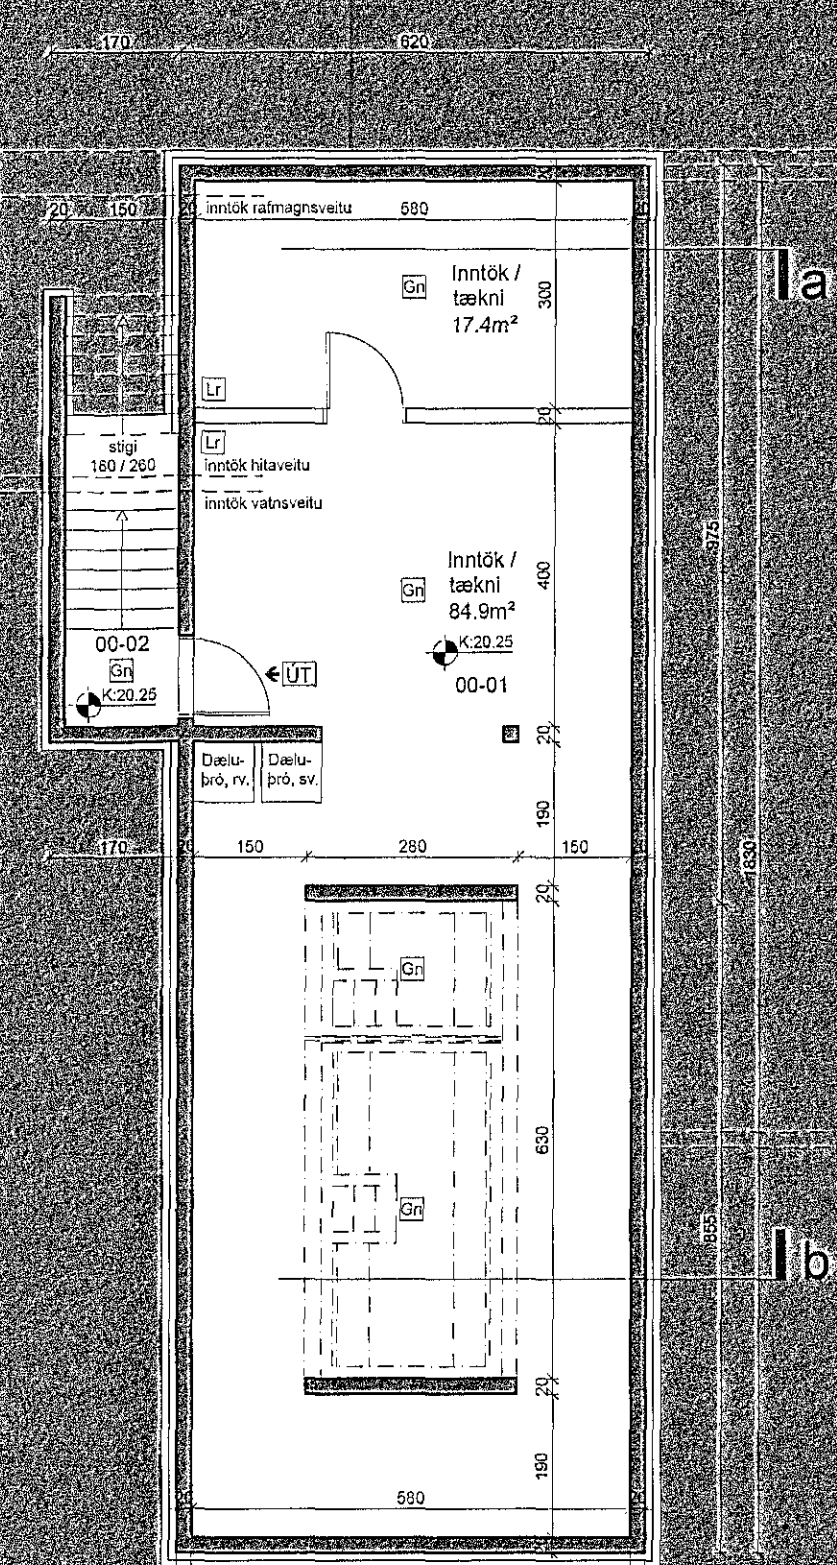

Ia  
Ib

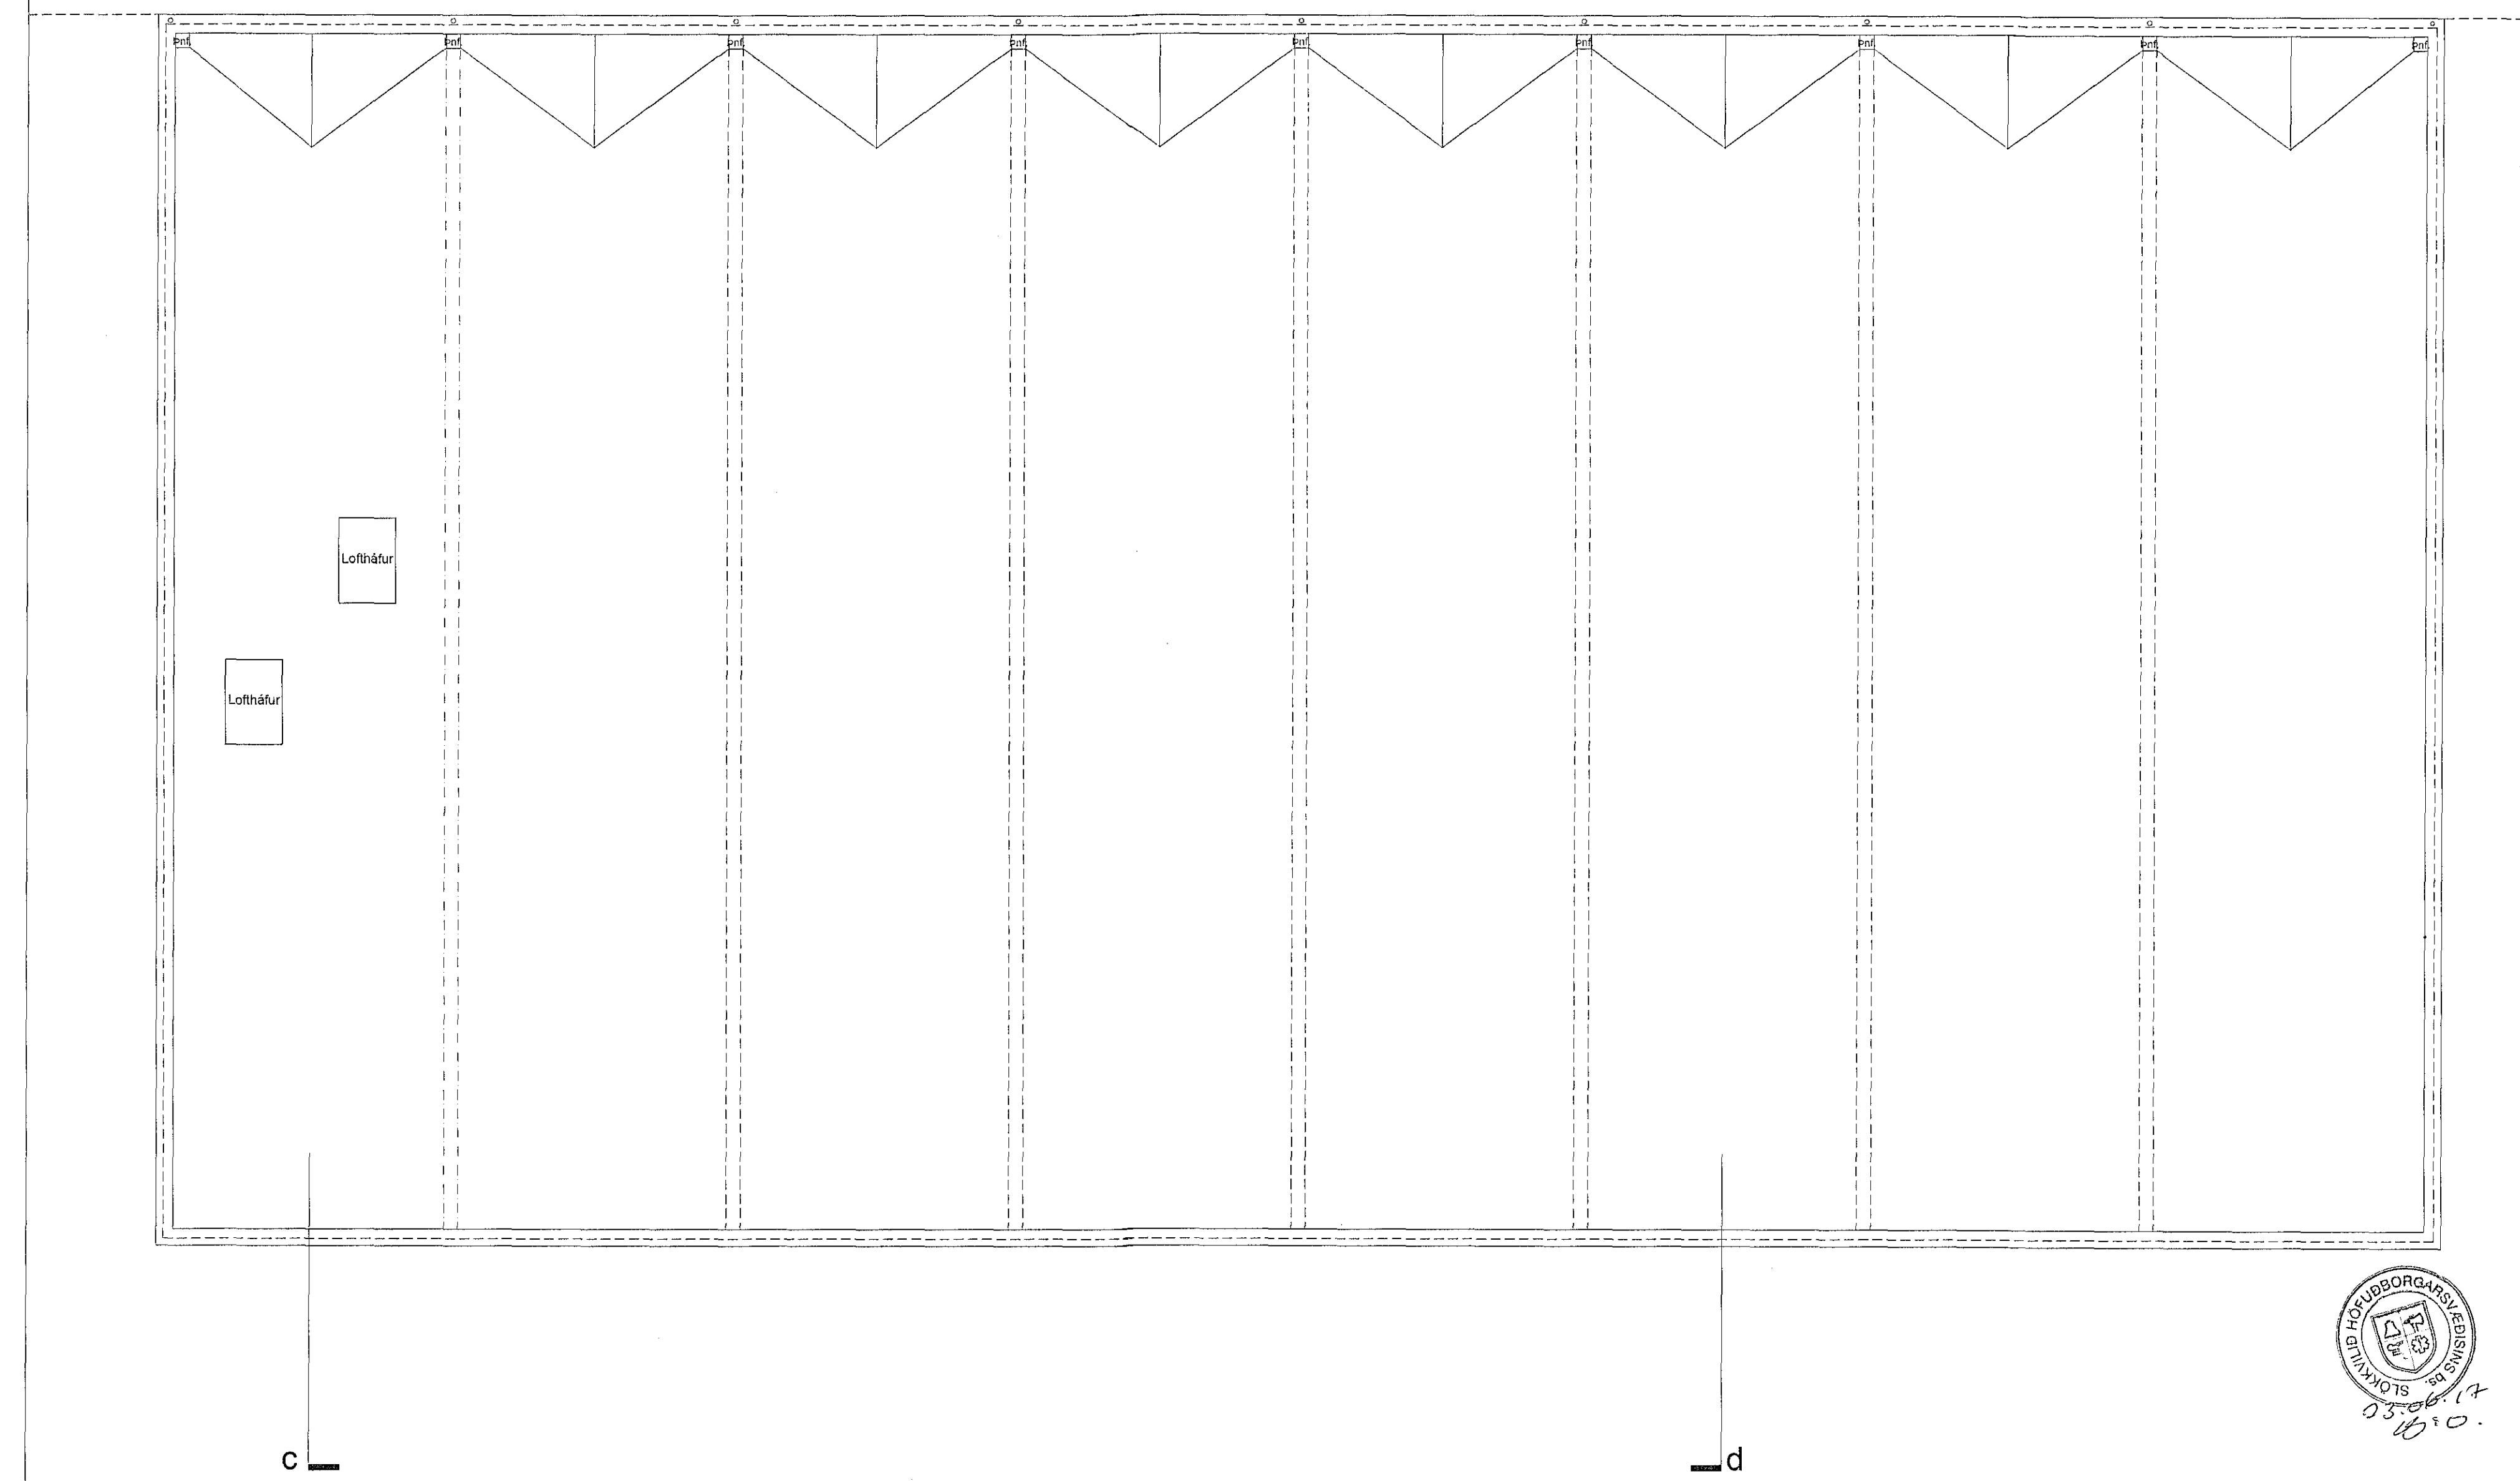


c

d

GRUNNMYND KJALLARA 1:100

ÞAKMYND 1:100

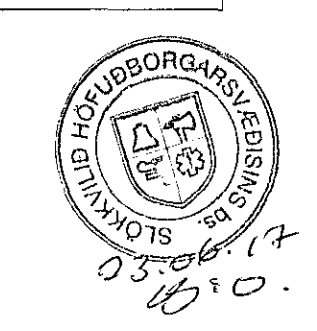

Virfangið af  
Brunavarnir  
yfirfarar f.h. GR  
19.6.2017

C:  
B:  
A:  
BREYTINGAR: \_\_\_\_\_ DAGS: \_\_\_\_\_

LYKILMYND:  
\_\_\_\_\_

Heilsuræktarstöð Tjarnarvöllum 7

ADALUPPDRA'TTUR  
GRUNNMYND KJALLARA, ÞAKMYND

VERK: WCJ-1706  
KVAFDI: 1:100 TEIKNAD: AL  
DAGS: 07.06.2017 SKRÁ: grunnur-1.dwg

ÚTI INNI

ARKITEKTAR

ÞINGHOLTSSTRÆTI 27 101 REYKJAVÍK  
SÍMAR 5527660 & 5527660 FAX 5527661  
NETFANG ul@ul.is  
VEFFANG http://www.ul.is  
ARKITEKTAR FAI  
• BALDUR Ó. SVAVASSON  
120357-5149  
JÓN ÞÓR ÞORVALDSSON ARKITEKTAR FAI  
021296-7979

TEIKNINGANR: **A-103** BREYTING: \_\_\_\_\_