



Samþykkt
 08. des. 2017
 Bygginguáttalinn (1/17)




norð-austur

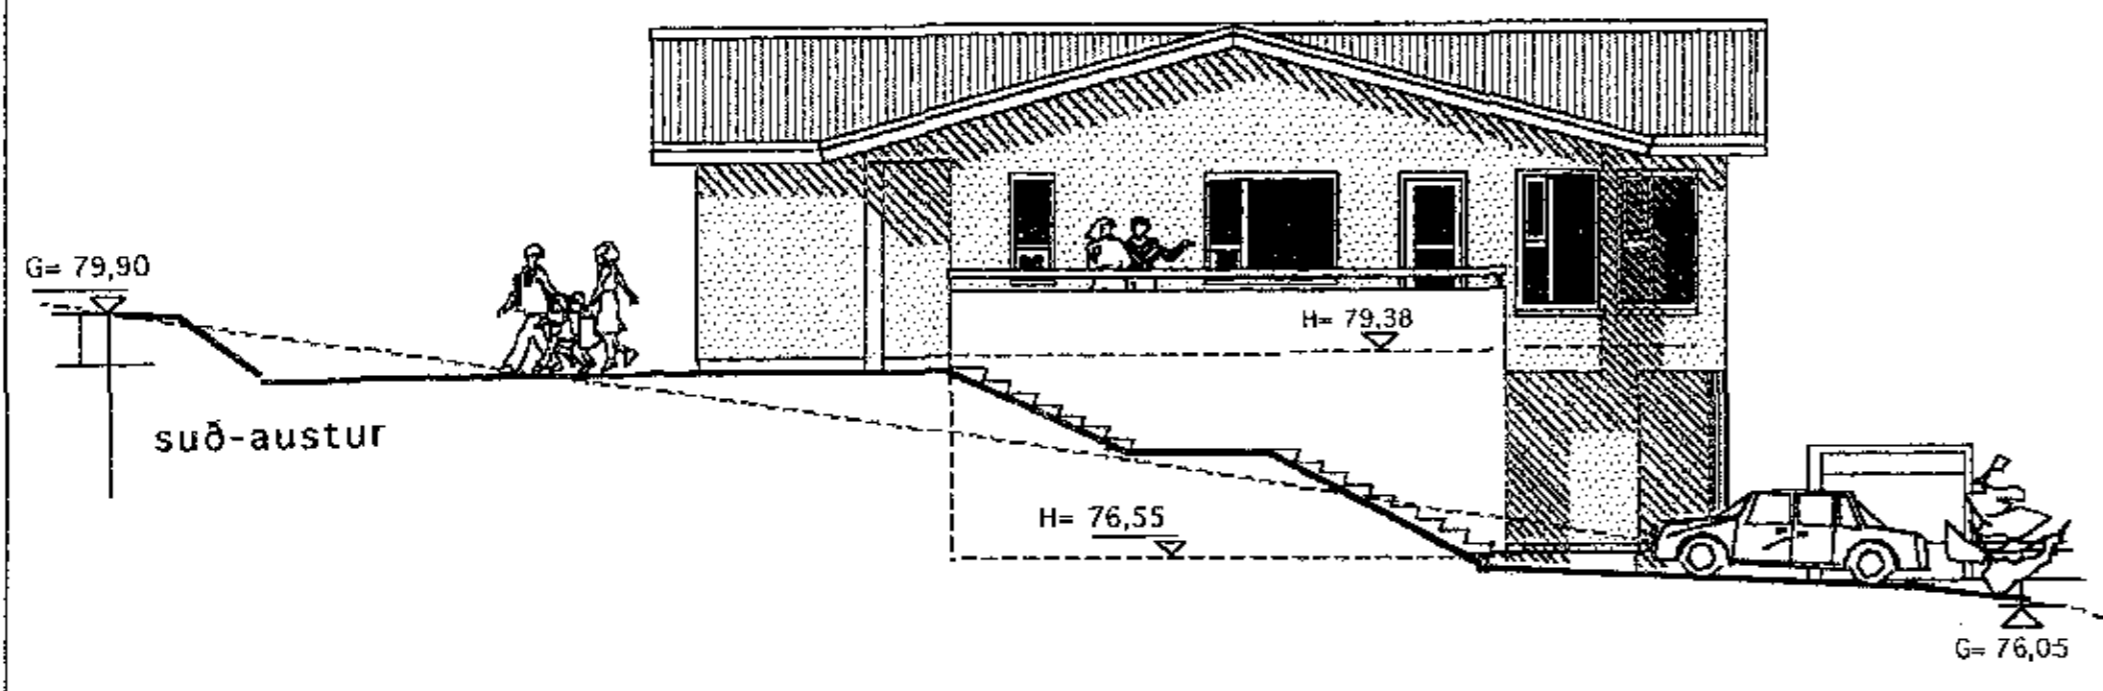

suð-austur

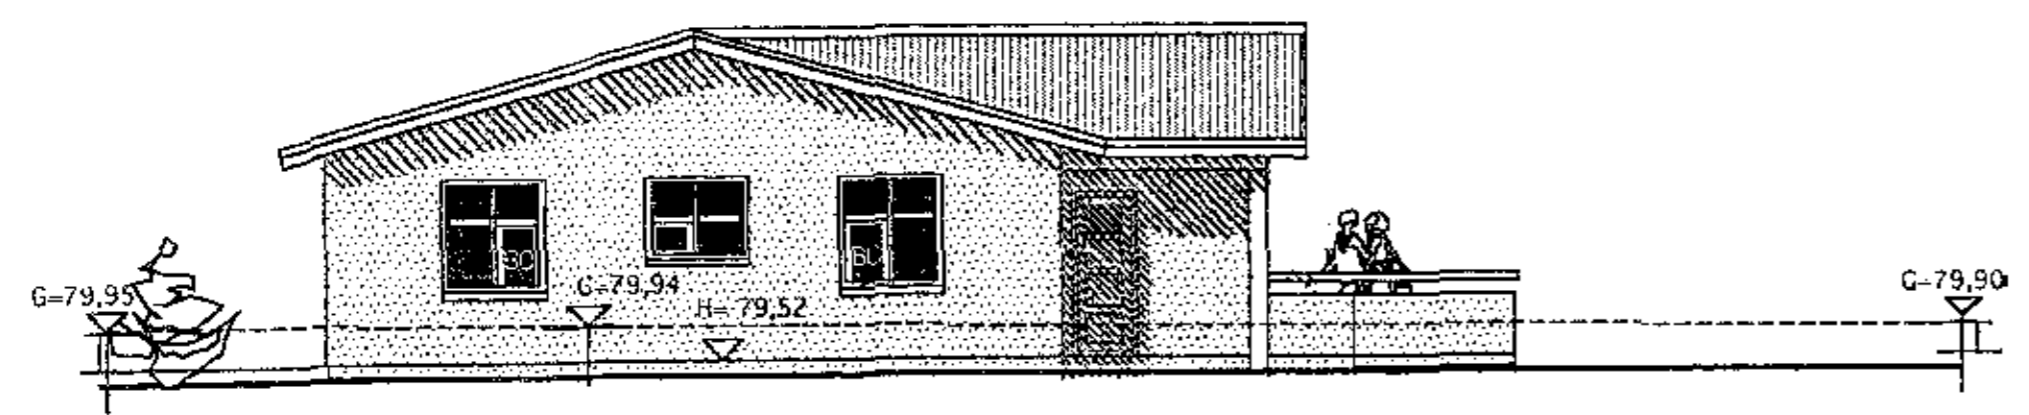

suð-vestur

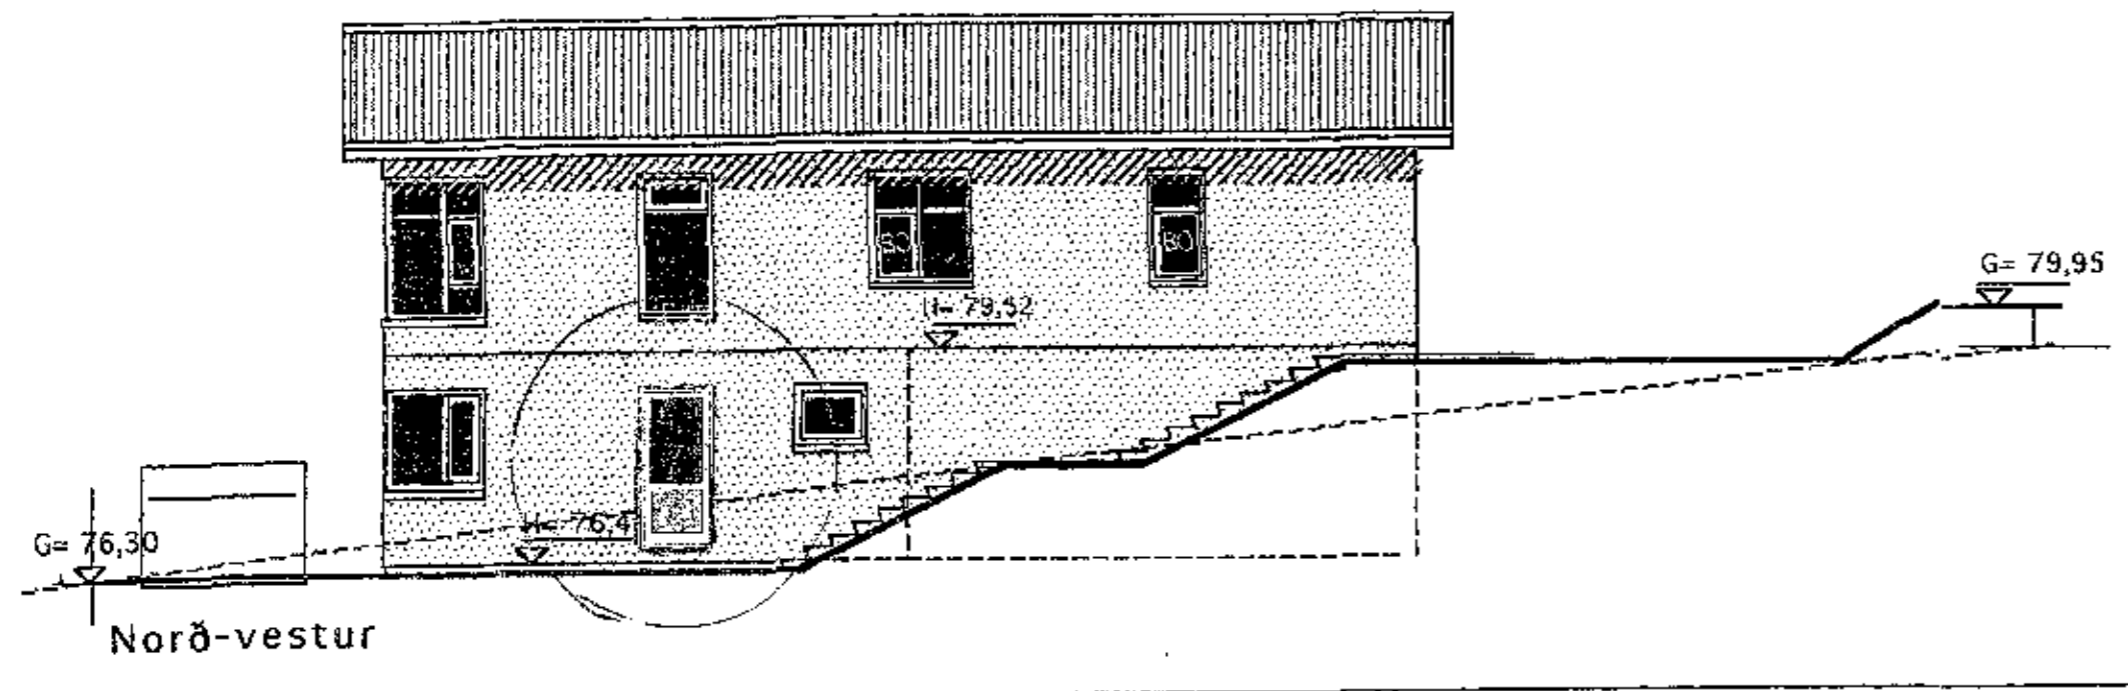

Norð-vestur

Breytt: 27. nóv. 2017
 Glugga á norð-vestur hlið 1. hæðar breytt í hurð.

	Verkefni FURUÁS 41 HAFNARFIRÐI
	Heiti ÚTLITSMYNDIR
kvarði: 1:100	verk.nr. 2017-121
dags.: 6. MAÍ.2007	dags. br.: 27. nóv. 2017
hönnun: G. G.	teikn. nr. A-3
teikn: G. G.	
Hringbraut 17 220 Hafnarfirði s. 555-2020 FAX 555-2021 Gísli G. Gunnarsson PFI kt. 020624-2409. kvardi@vsn.is 