


1 2.Hæð
1:100

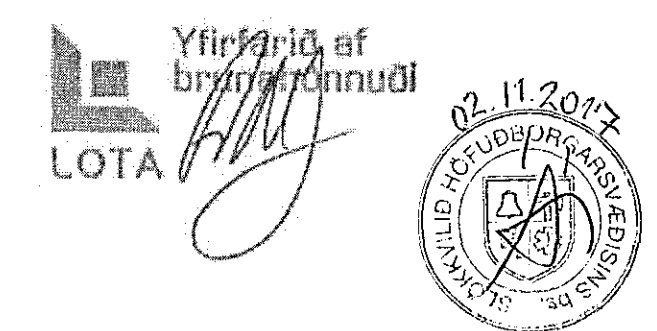

mansard
teiknistofa ehf

Suðurlandsbraut 30 - 108 Reykjavík
www.mansard.is / jonhrath@mansard.is
Kt.: 570394-2079 - s.062-7102

Verkefni: Eskivellir 11 - 220 Hafnarfirði

Efni: Aðaluppdrættir :
Grunnmynd 2.hæð

Verknúmer: A-15-03-03	Mkv.: 1:100	A1
Teikn. nr.: A-103	Dags.: 22.08.2017	
Hannað: JHH	Teiknað: JHH	
Jón Hrafn Hildóverson byggingafræðingur BFI		
Kt.: 260662-6519		
Samþykkt:		

1.9.2017 11:49:10