


Útlit - Austur
mkv: 1 : 100

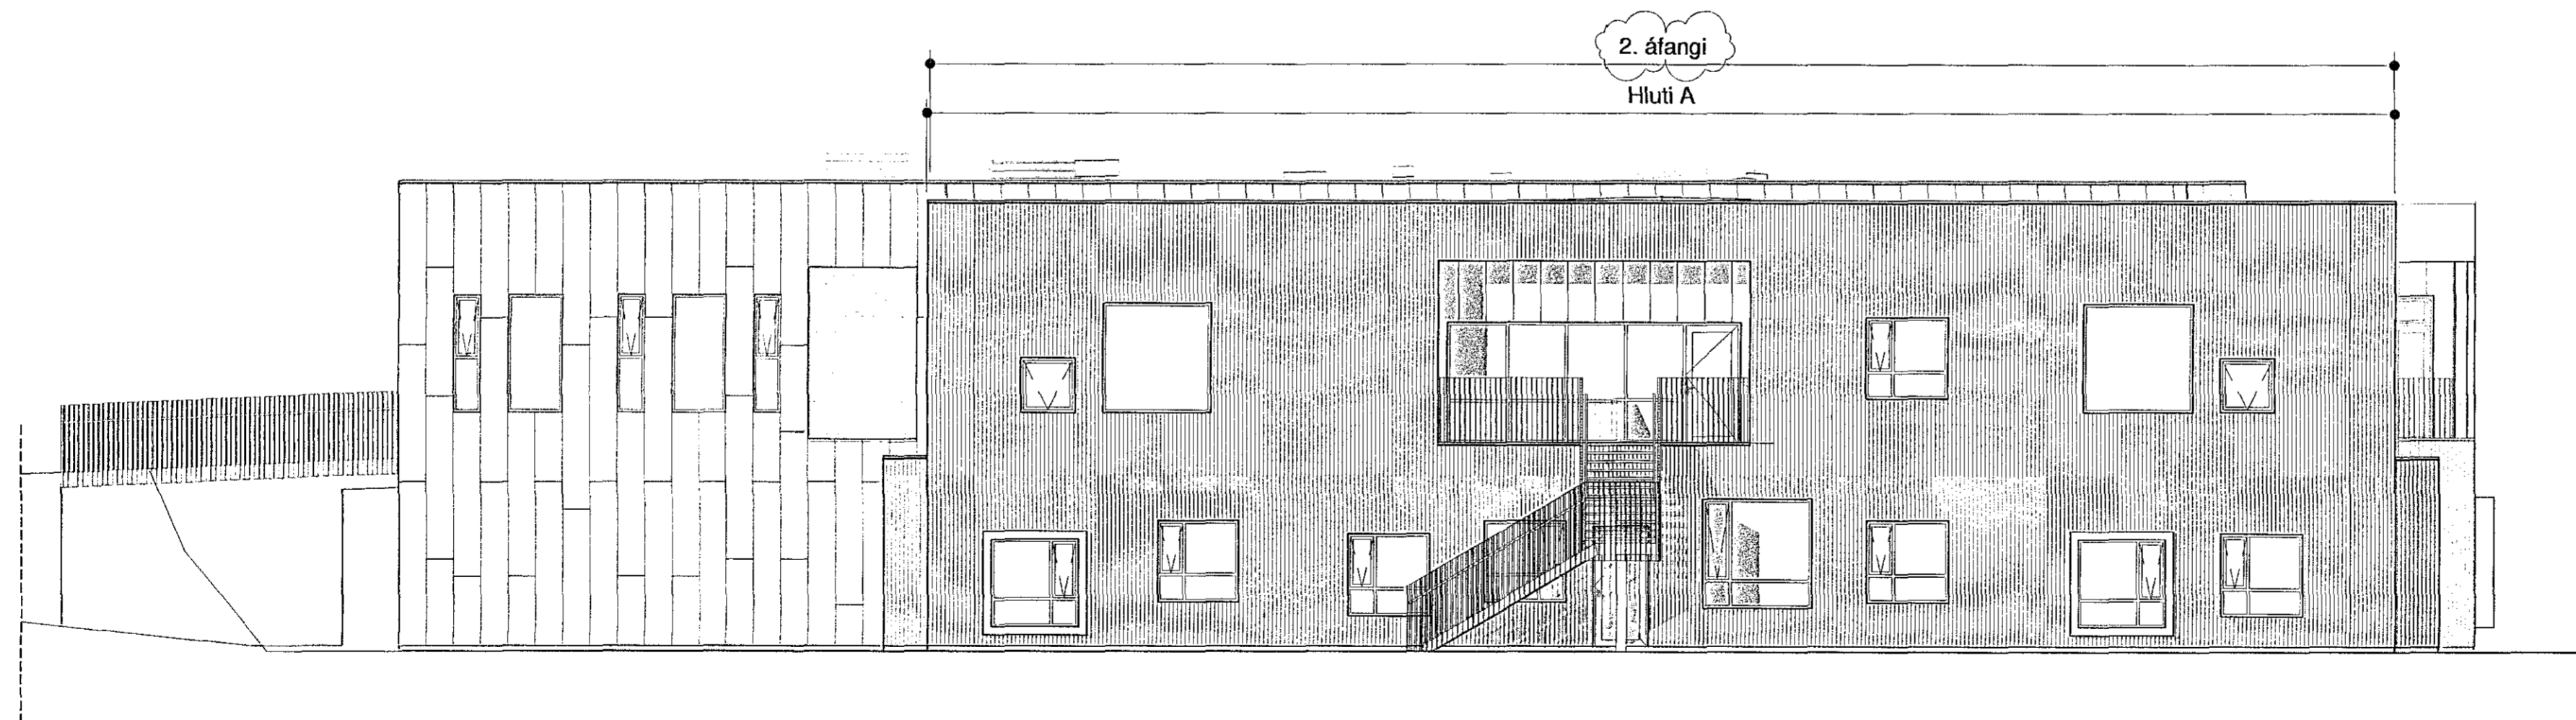

Útlit - Vestur
mkv: 1 : 100



Digitally signed by
Guðmundur H. Guðmundsson
DN: cn=Guðmundur H.
Kjartansson, o=Kjartansson, ou=Kjartansson, email=gu@kjar.com
Reason: I have reviewed
this document.
Location: Reykjavík
Date: 2018.09.18 15:13:32


- B 11.09.2018 Teikning uppfærð m.v. áfangaskiptingu
- A 19.09.2017 Uppfærðar teikn. v. athugasemda frá Hafnarfjarðarbæ

BREYTINGAR

VERKHEFTI
Hádegisskarð 1, Hafnarfirði
Skóli, mhl.01
Aðaluppdrættir

VERK
Útlit austur og vestur

MÁL: 1 : 100 / A1	DAGS: 06.09.2017
HANNAÐ: ISC	TEIKNAR: ES/HP
YFIRFARÐ: Svági	
VERKINGMÉR 484-02	FL. TEIKNINGANÖMÉR 04 1.3-03
	ÖTÖ B

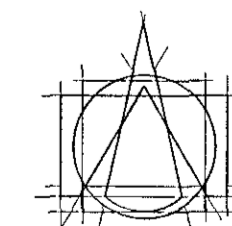

Tark

ARKITEKTAR
BRAUTARHOLI 4 - 105 REYKJAVÍK - ÍSLAND
Sími: 540 5700
teiknistofnan@tark.is
www.tark.is

[Signature]