
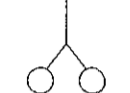





-  Brunaslanga
-  Tölvubærni Slökkvæðis
-  Stjórnsáð Brunavöðrunarkerfis
-  Handslökkvæði

GP ARKITEKTAR

Verkefni: Selhella 7
Grunnmynd

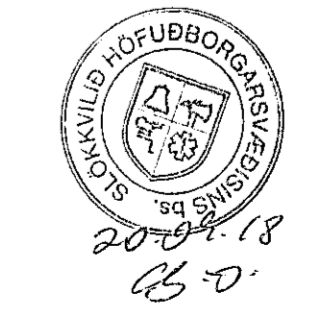

BRUNAHÖNNUN
20
Digitally signed by Gunnar H. Kósson
DN: cn=Gunnar H. Kósson, o=Kósson Gunnar, email=gk@koy.com, c=IS
Reason: I have reviewed this document
Location: Reykjavik
Date: 2018.09.19 08:42

Tekning nr. 002A
Mál 1:100
Dags. 18.09.2018
Tekniad. GP

Fiskisöld 31
Sími: 5511790
gpark@gpark.is
Arkitekt FAI
Kl. 291246-4519

Nýr byggingarrellur