


Digitally signed by
Gunnar H. Kristjánsson
DN: cn=Gunnar H.
Kristjánsson, o=Gunnar
H. Kristjánsson, ou=,
email=gunnar@brunahonun.is
Reason: I have
reviewed this document
Location: Reykjavik
Date: 2018.12.10
17:36Z

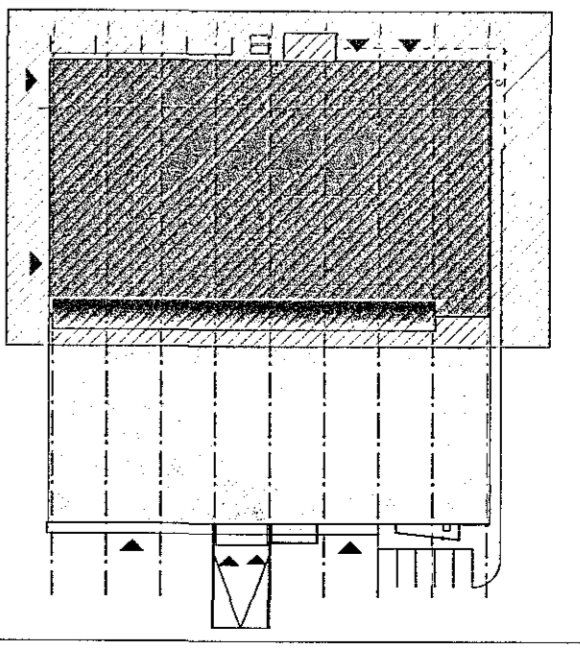

TEMPRA ÍSHELLA 8, 220 HAFNARFIRÐI	
Grunnmynd 2. hæð A	nú 1.3 kvarði 1.100
dags. 10. des. 2018	breytt: des. 2018 Vöbýggingum, sórum en skýi yfir gryfju, frestað
teiknistofa GINGI	Móttún 1, 460 Tálknafjörður gingi1@simnet.is
arkitektar lei gunnlaugur björn kristjánsson	kt. 110254-3349 sími: 6976984

Gunnar H. Kristjánsson