




Samþykkt þann
06. mars 2019
Byggingafalltákninn í Halli

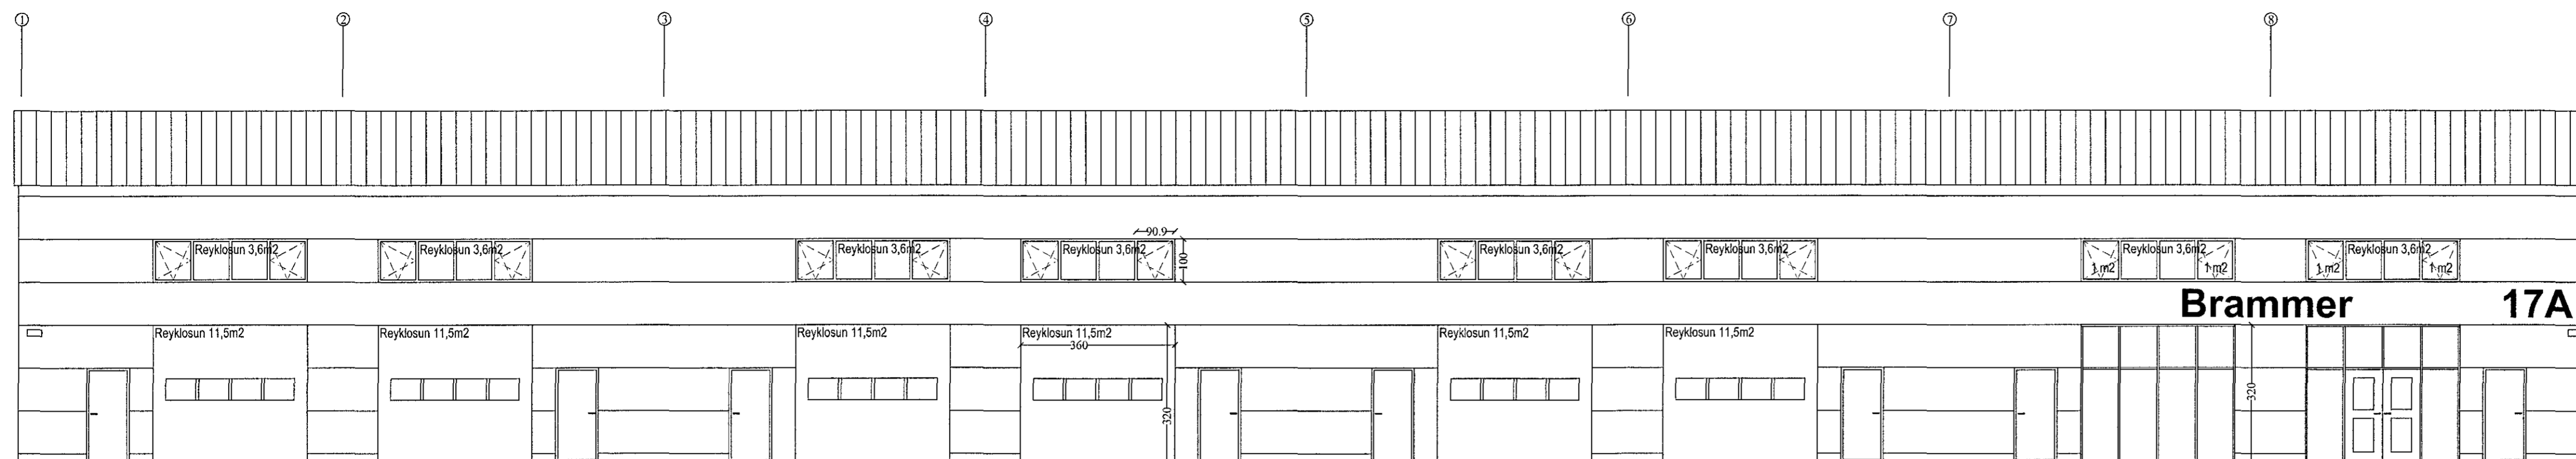


Steinhella 17A, AUSTLÆG HLID, mkv. 1:100

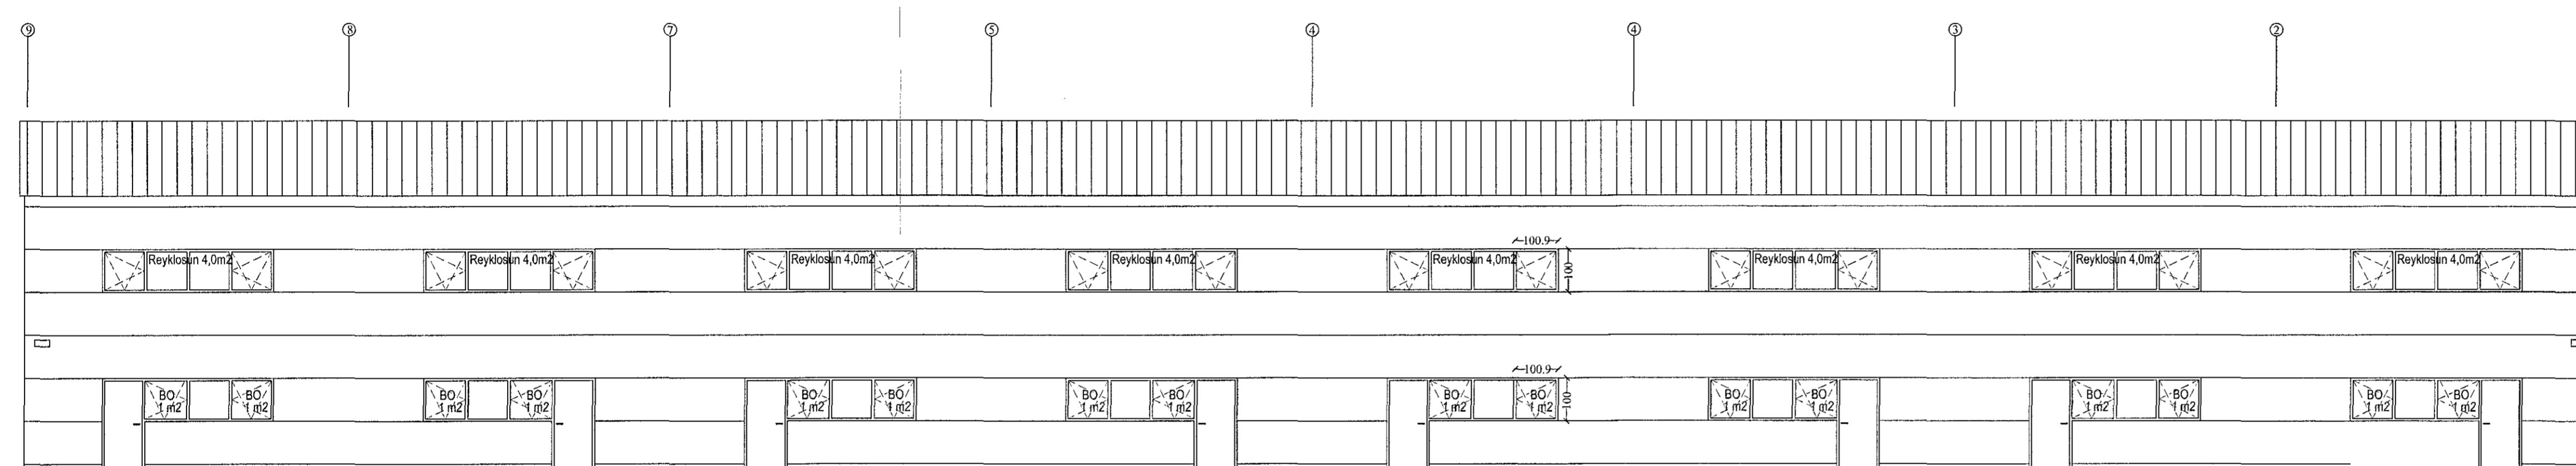


Steinhella 17A, VESTLÆG HLID, mkv. 1:100.

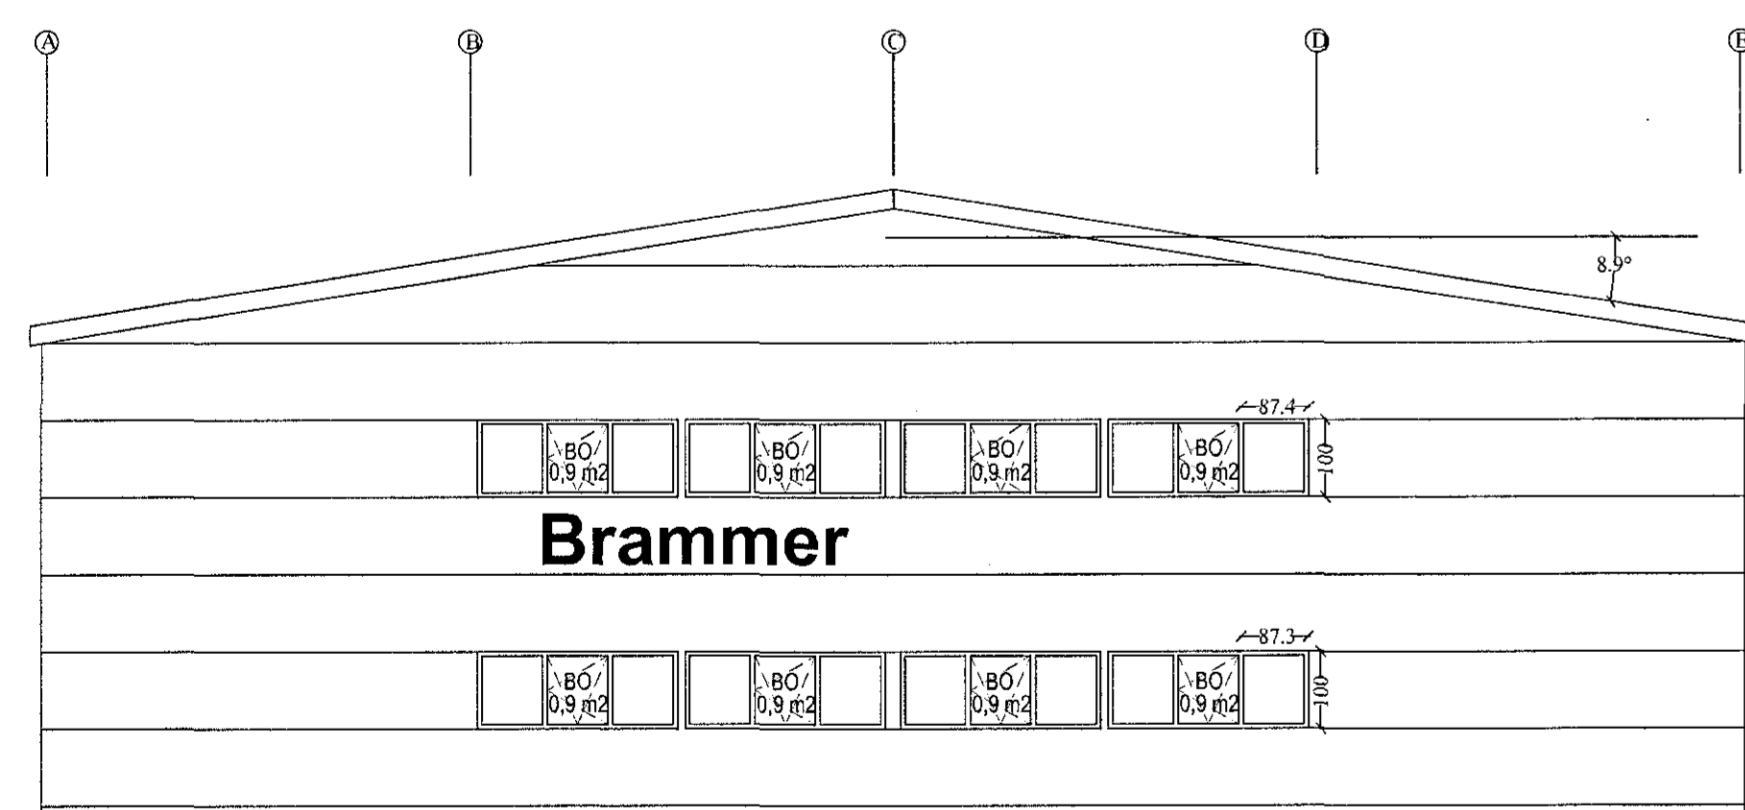

Steinhella 17A, NORÐLÆG HLID, mkv. 1:100

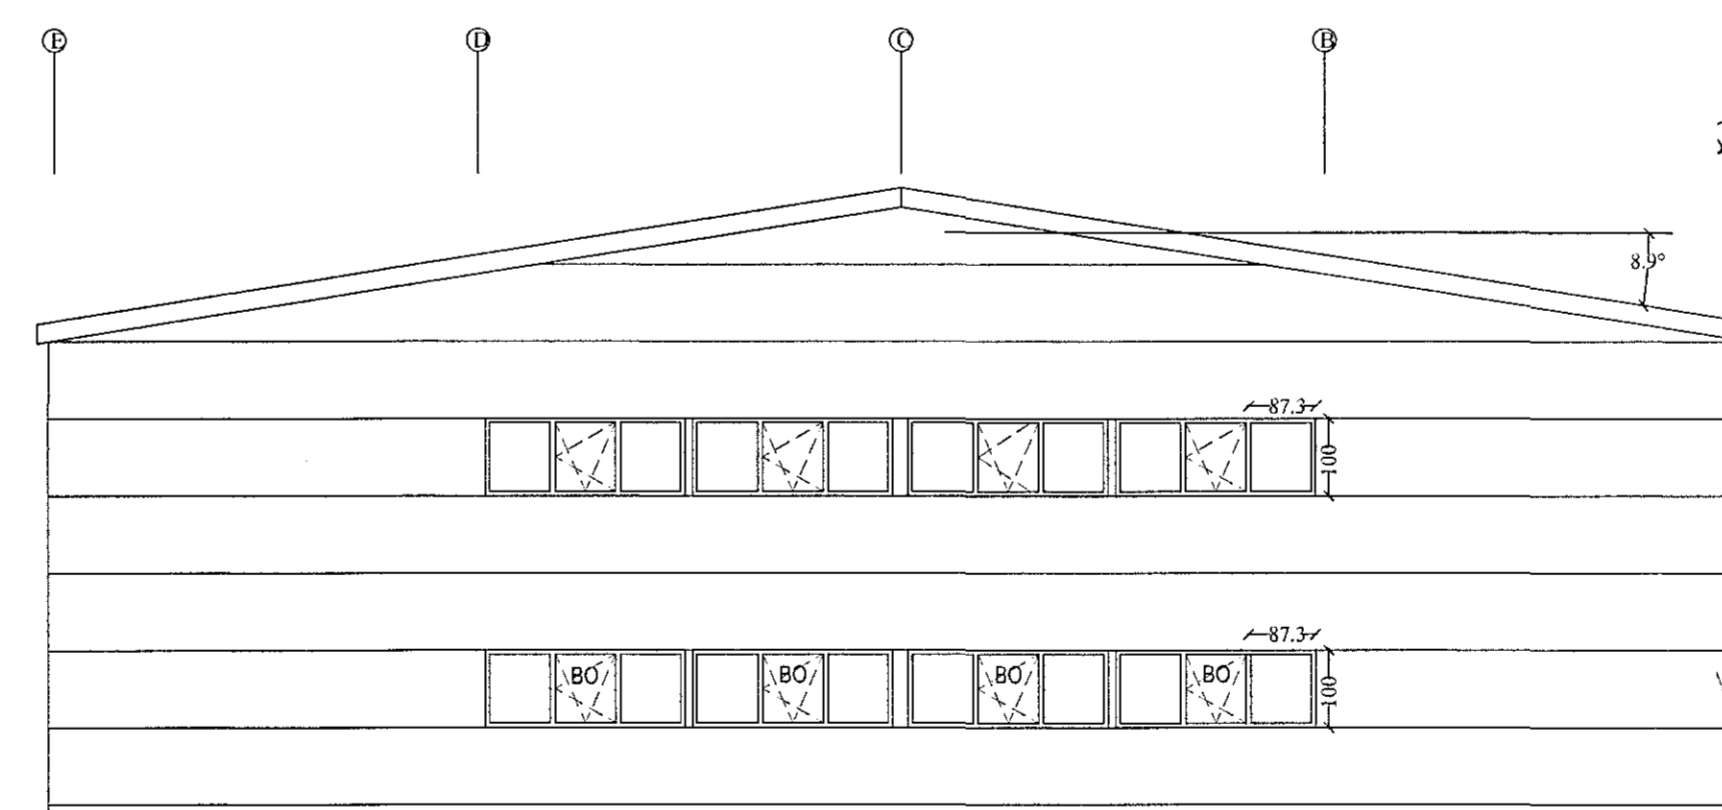

Steinhella 17A, SUÐLÆG HLID, mkv. 1:100

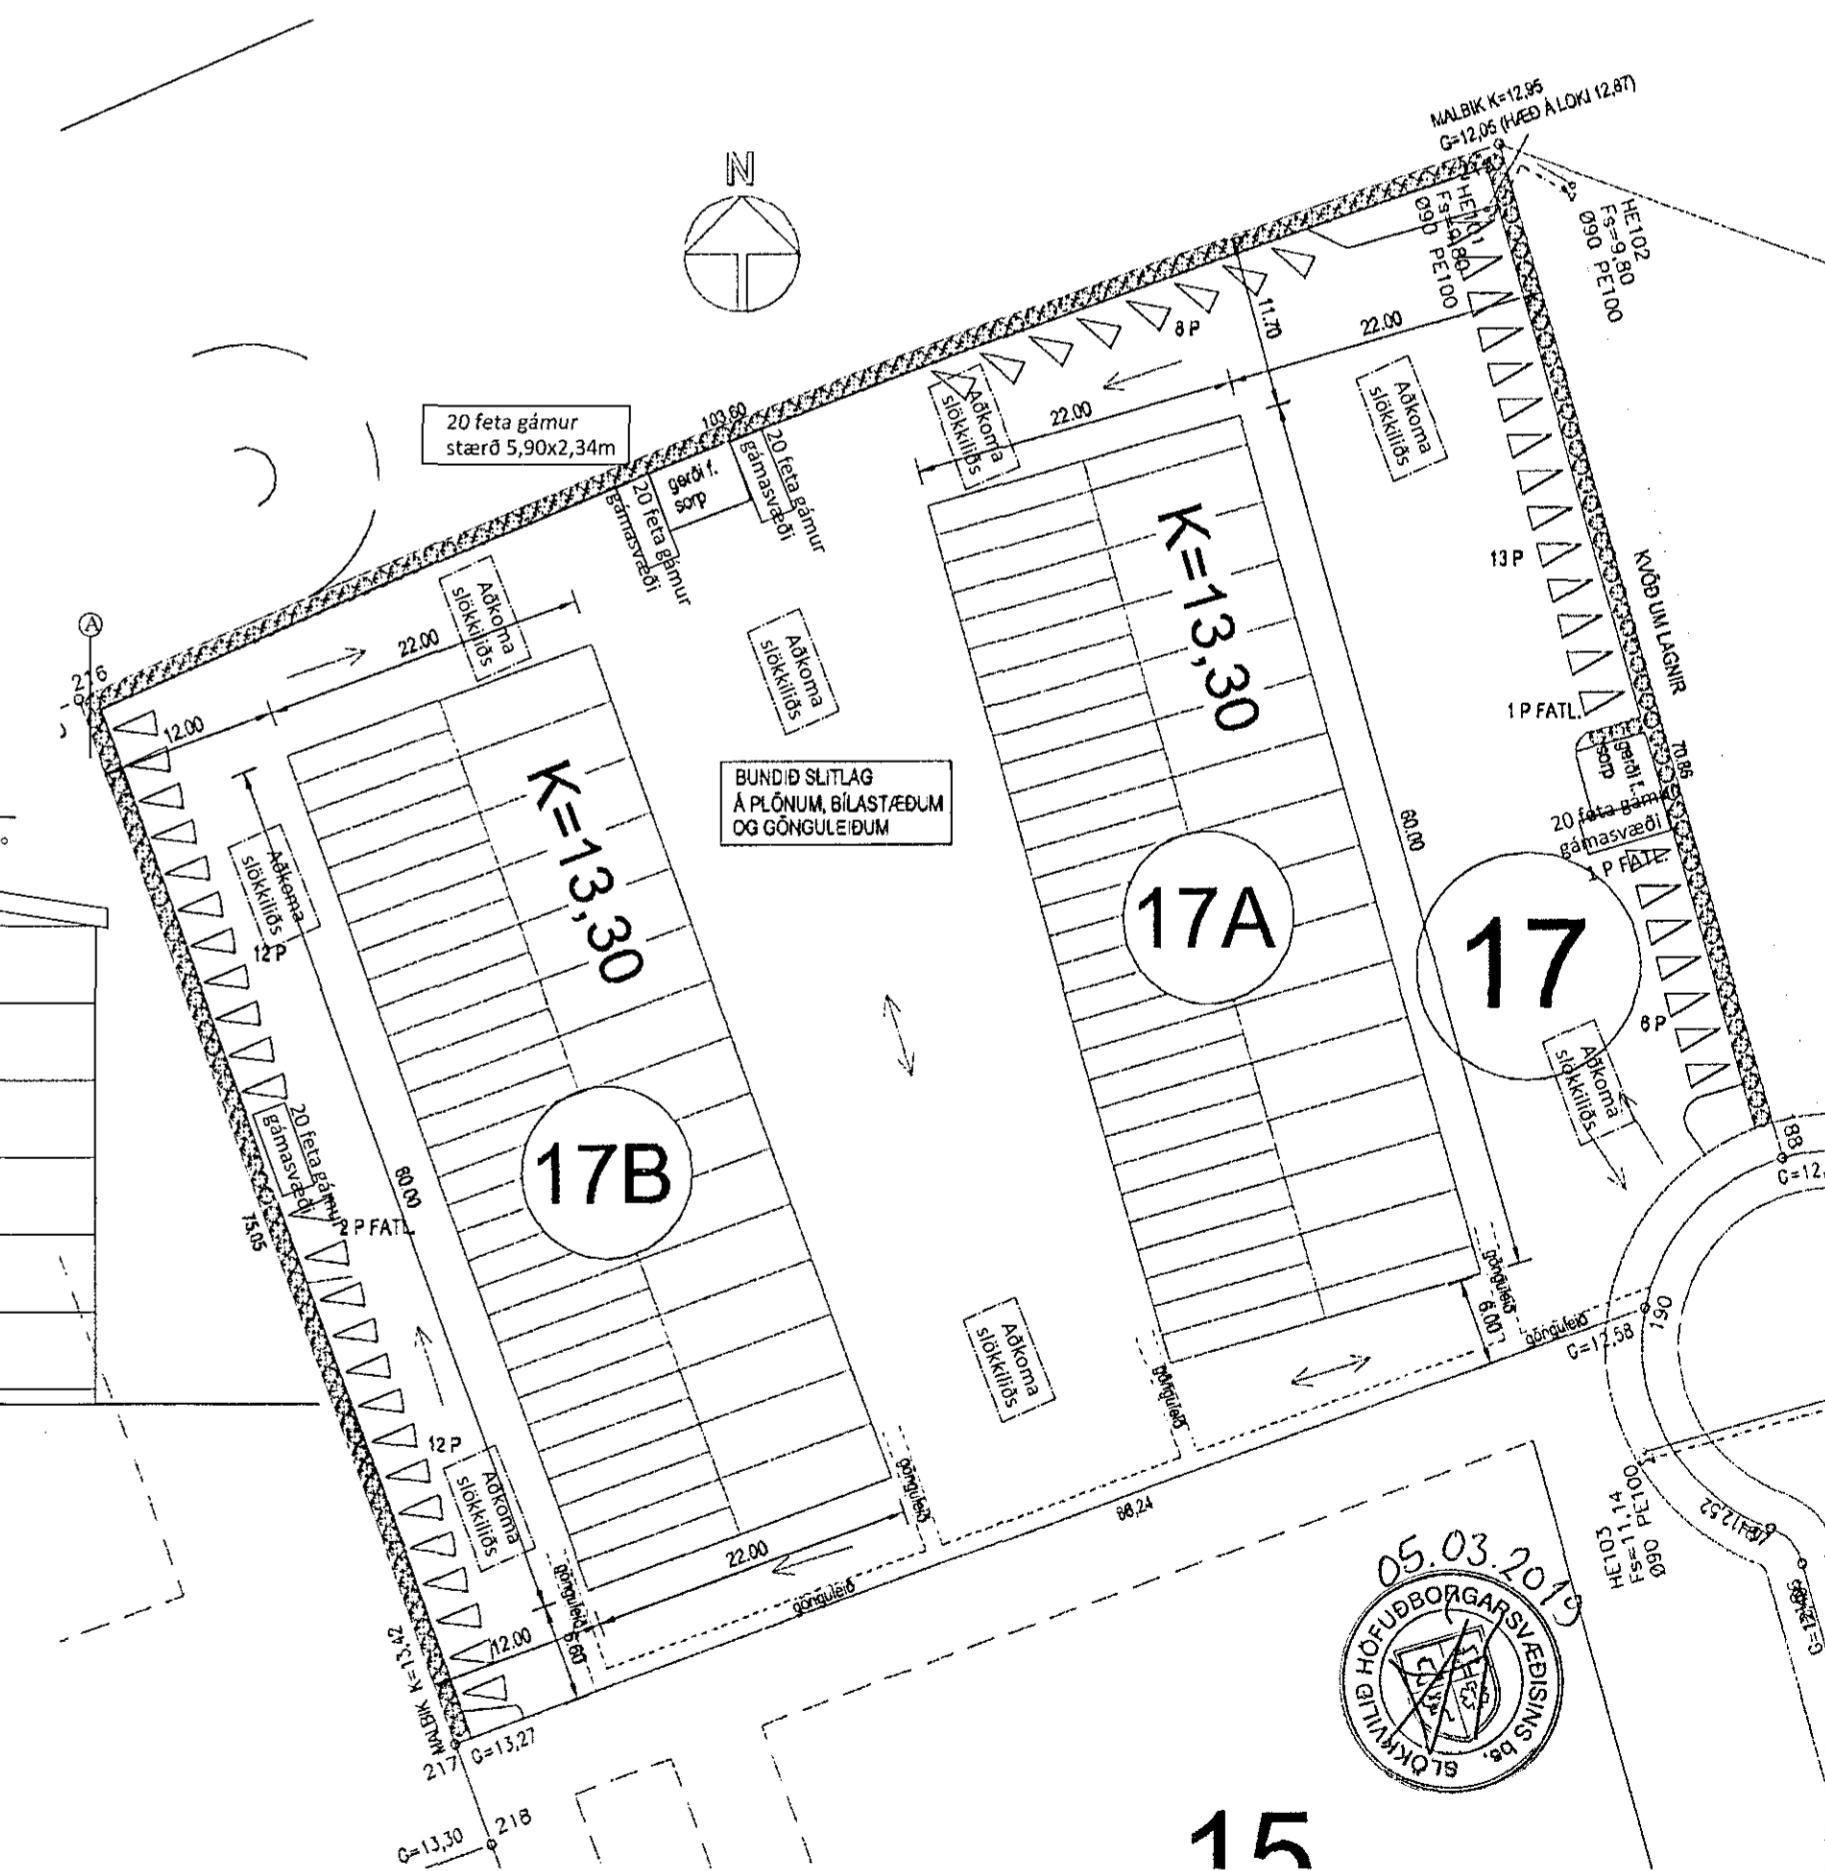

Afstöðumynd 1:500

22.05.2018
07.05.2018
10.01.2017

BR.	BR. DAGS	EDLI BREYTINGA.	SIGN.
01	12.06.2019	Verið er að breyta skrifstofurými í verslunarrými 0103	Sigurbj. Hall

STABURK Steinhellu 17A, 221 Hafnarfirði
Vallahverfi
SKYRING: Útlit austur og vestur.
Útlit norður og suður, afstöðumynd og gámasvæði.

TEIKNING NR:
BN0102
KVARDI:
1:100, 1:500
REIKN:
Sigurbj. Hall.
TEIKN:
Sigurbj. Hall.
DAGS:
12.02.2019
VERK NR:
Steinh. 0101

SIÐURSTYTT
05.03.2019
SIGURBJARTUR HALDÓRSSON
BYGGINGATEKNIFRÆÐINGUR, FTFI.
Laxakvísl 35, 110 Reykjavík
Sími: 567-1065, 775-2233, sígur@sigur.is
Sími: 567-1065 og hönnustjóri.