


- R.s. Reykskjafi.
- O.H.S. Handalokkvitaski.
- L.R. Lofttraesting.
- B.op. Bjorgunarlop.

29.1.2019 22:04 e.h. Brennisk.1903 - des 2018.dwg JonG

Grunnmynd 5. hæð. 1:100 Stærð. 5. hæðar. 204,0 m²

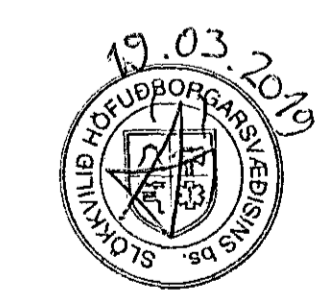

Digitally signed by
Gunnar H. Kristjánsson
DN: cn=Gunnar H.
Kristjánsson, o=Jon
Guðmundsson arkitekt
hlf.is, email=gunnar@
jonarh.com
Reason: I have reviewed
this document.
Location: Reykjavík
Date: 2019.03.14
13:20Z