



Útlit suðvestur 1:100

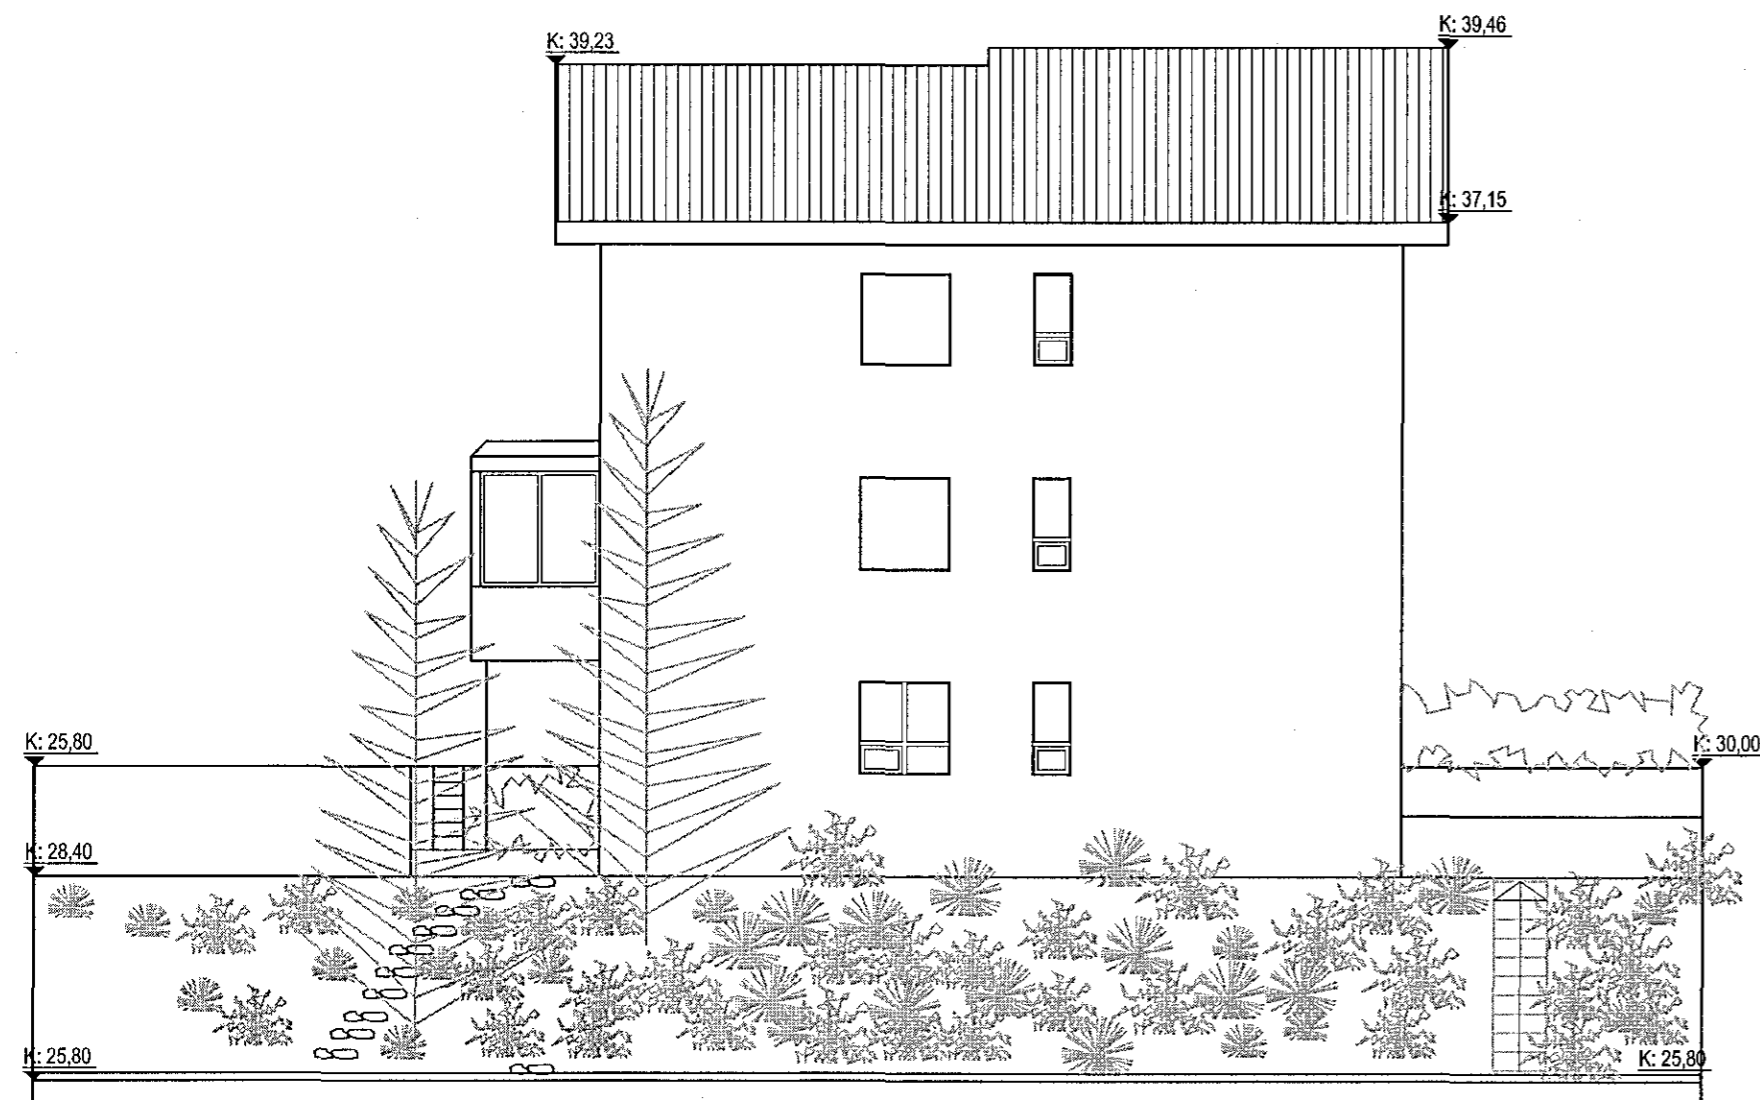

Útlit norðaustur 1:100

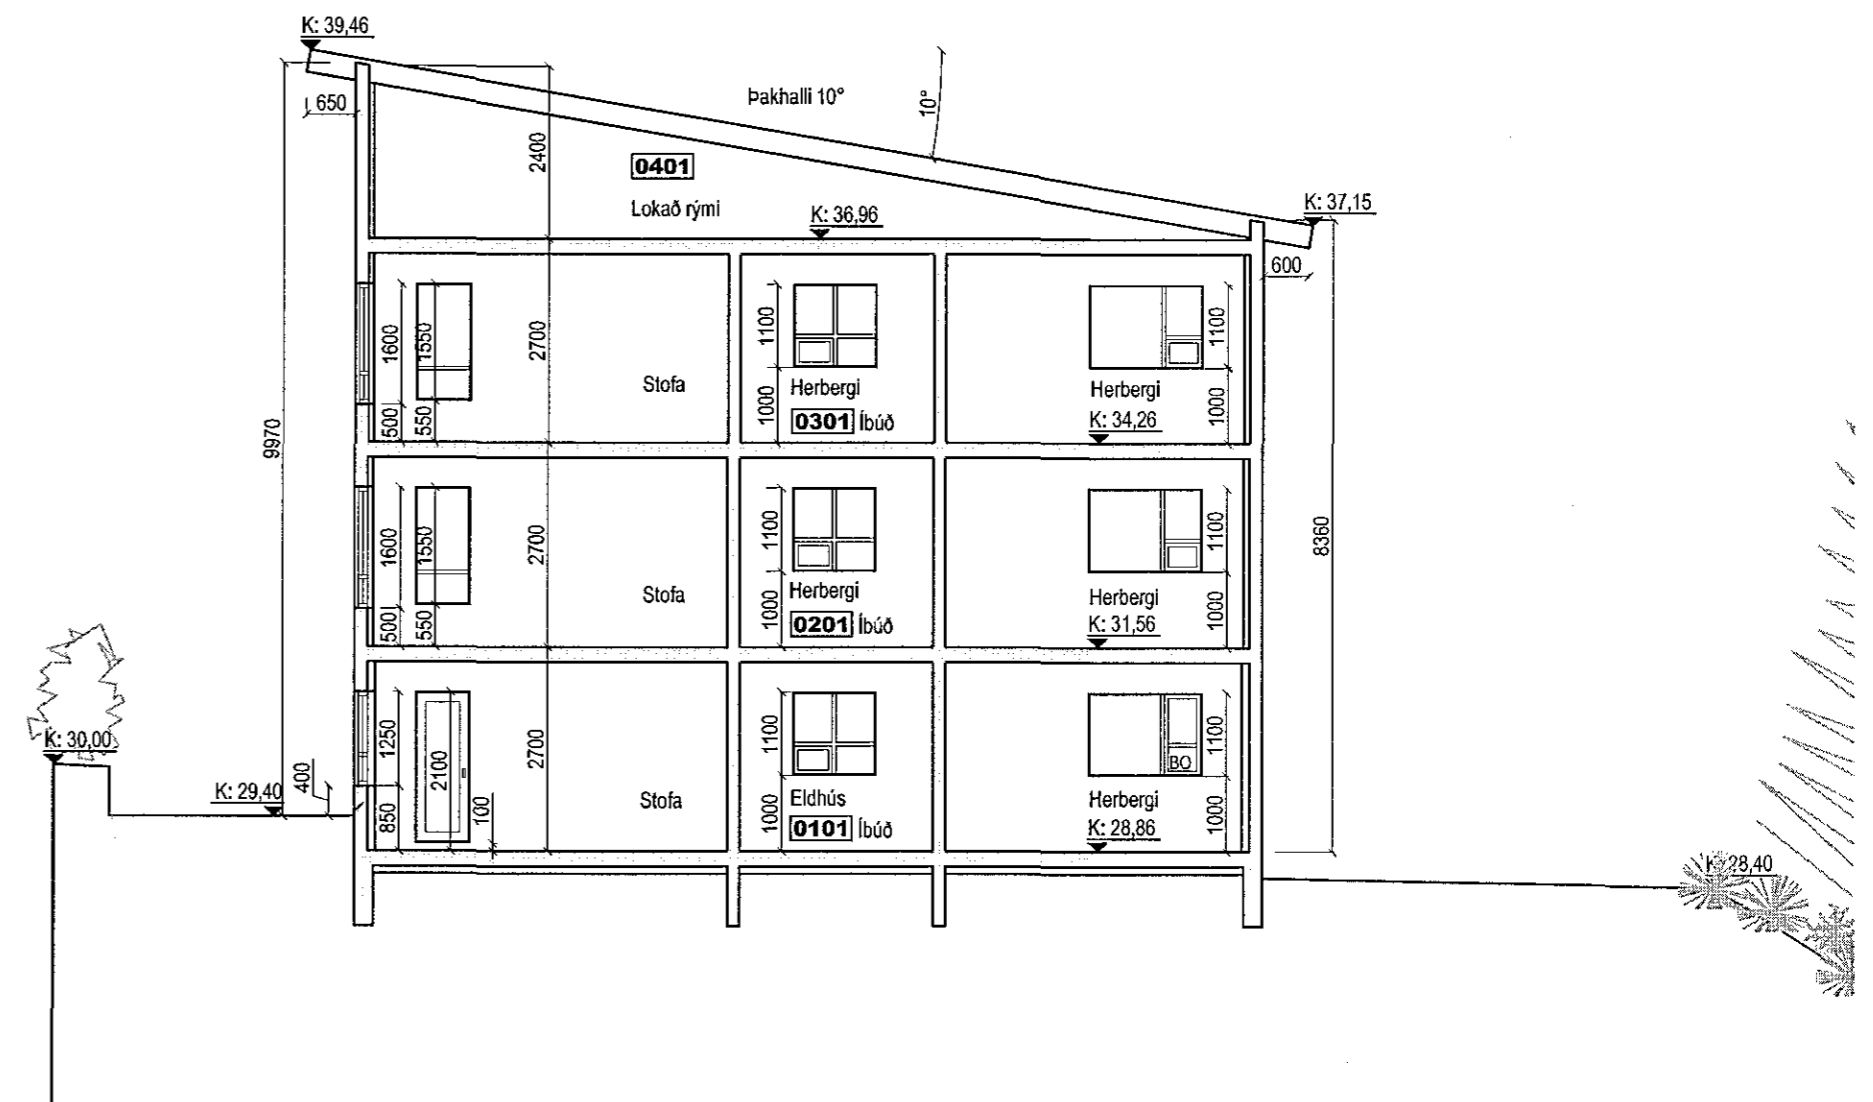

Snið a - a 1:100

KELDUHVAMMUR 1

LÝSING: Teikningar - uppmæling
DAGS: 28.08.2018 br 28.03.2019
VERKNR: 3/18
TEIKNINR: A - 102
EFNI: Útlit og snið
MKV: 1:100
TEIKNAD: SH

S. Halldór 29/3 2019
Sigurbjartur Halldórsson

Sigurbjartur Halldórsson

Byggingartækni- og arkitektúr
Kt. 230656-3479
Laxakvísl 35, 110 Reykjavík vnr. 43064