



B-B.  
1 : 100

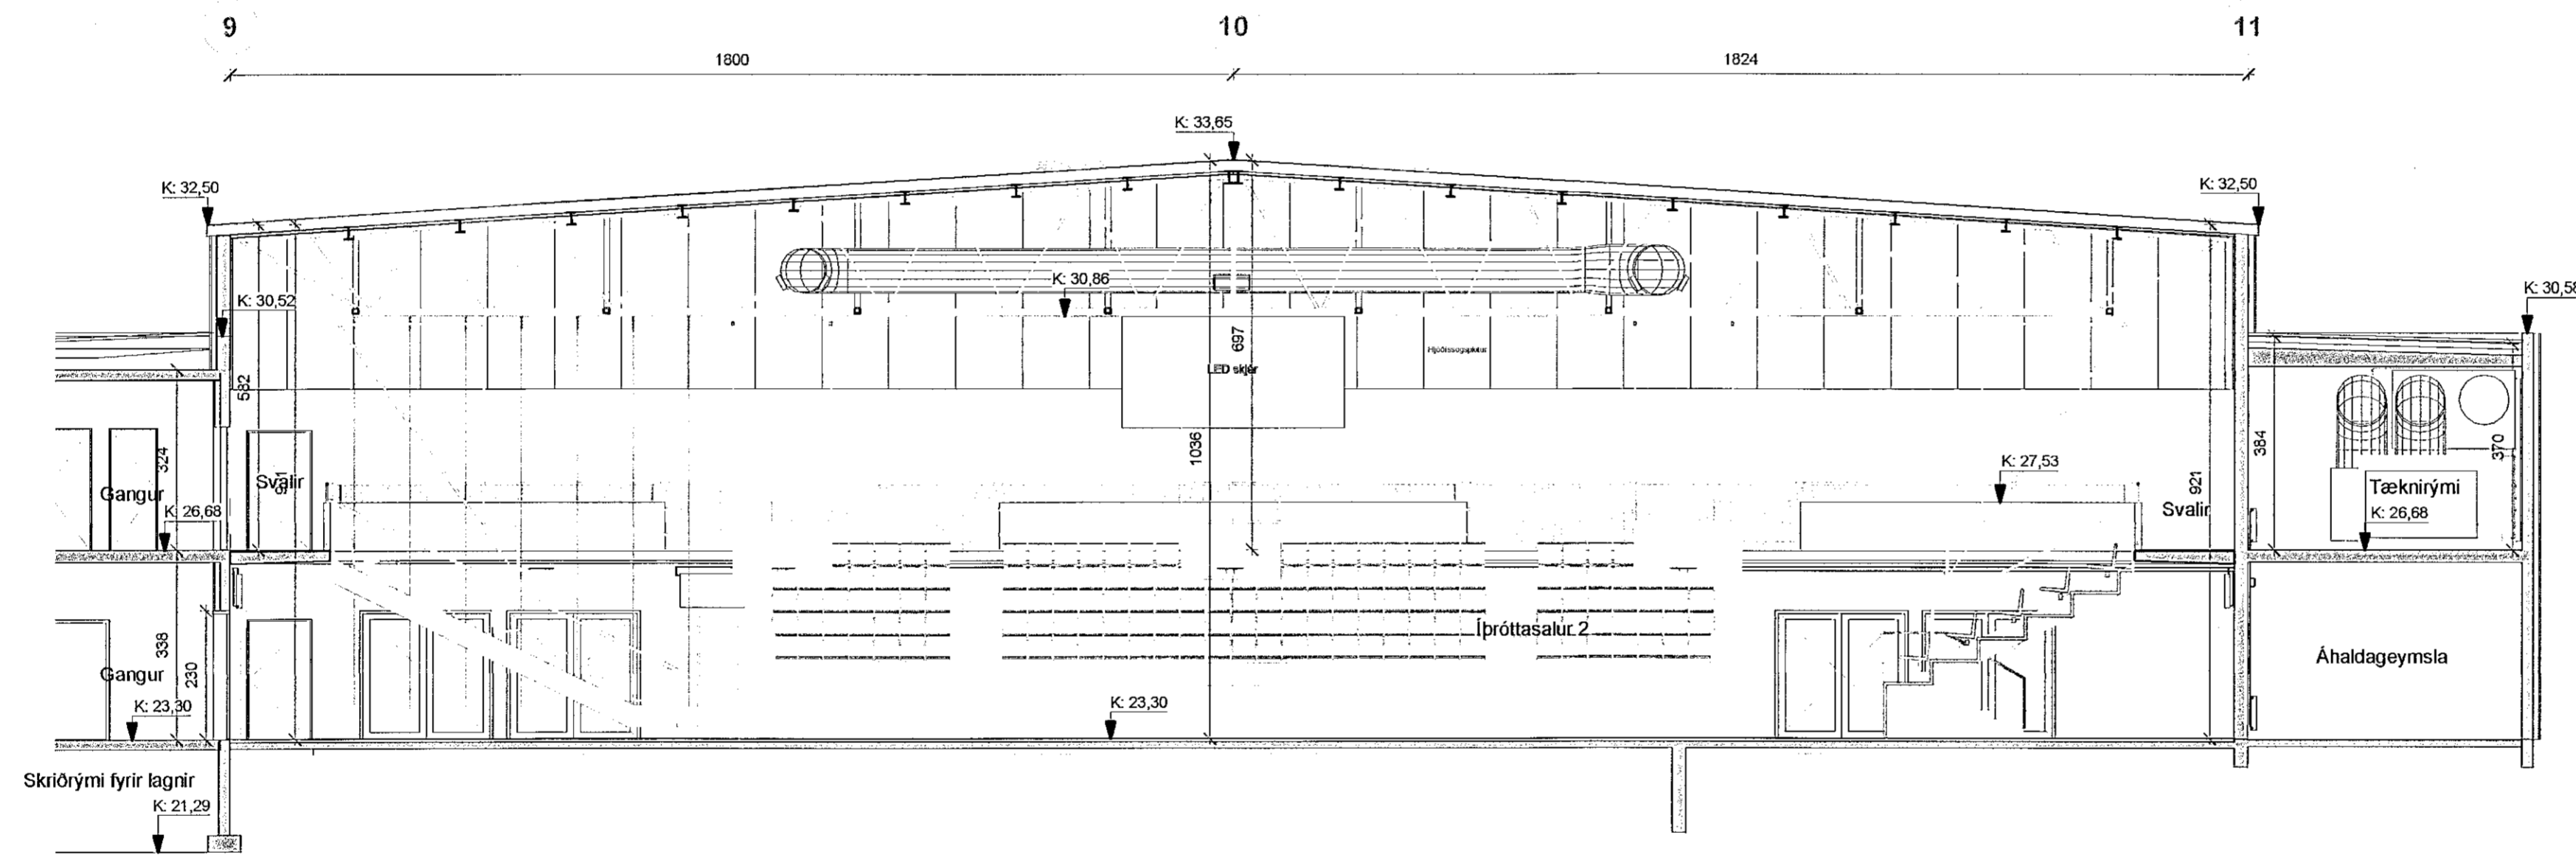

B-B - NA  
1 : 100

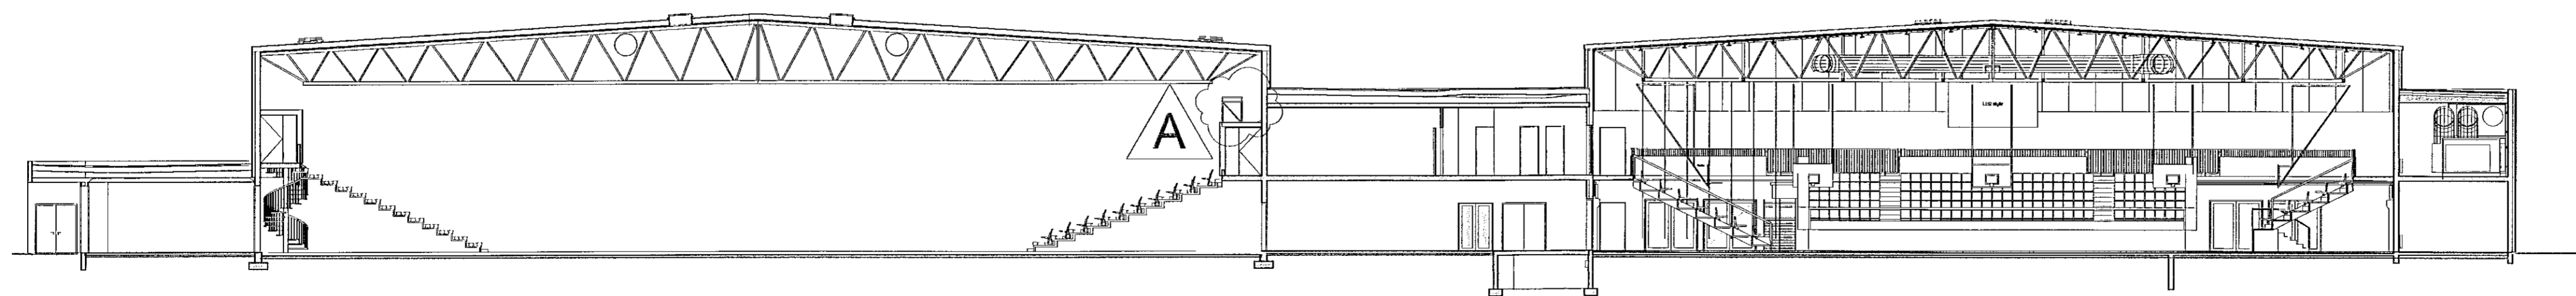

B-B yfirlit  
1 : 200

Skýringar vegna breytinga  
A Nýjar tæknisvalir í eldri íþróttasal (sal nr.1).

*[Signature]*  
2018-02-23  
13:01:56

A	KJH	HMH	09.02.2018
ÚTGÁFA	TEIKNAD	YFIRFARÐ	Dags

ASK ARKITEKTAR EHF  
GÍFFRÓDULU  
101 REYKJANÍK  
SÍM 575 0300  
www.ask.is

ÁRITUN ADALHÖNNUNAR

*[Signature]*  
Hönnuður: M. Jónsson  
ASK ARKITEKTAR



VERKFERÐIR  
ÍÞRÓTTAMÍÐSTÖÐ HAUKA  
Ásvöllum 1, Hafnarfirði

TEIKNAD	HMH	1:100, 1:200
Adalteikningar	KJH	
Sneiðing B-B	HMH	
	DAG:	04.11.2016

VERKNR:	ÁRKENNI - NÁMERS TEIKNINGAR	ÚTGÁFA
9623	A-111	A