


F-F
1 : 100

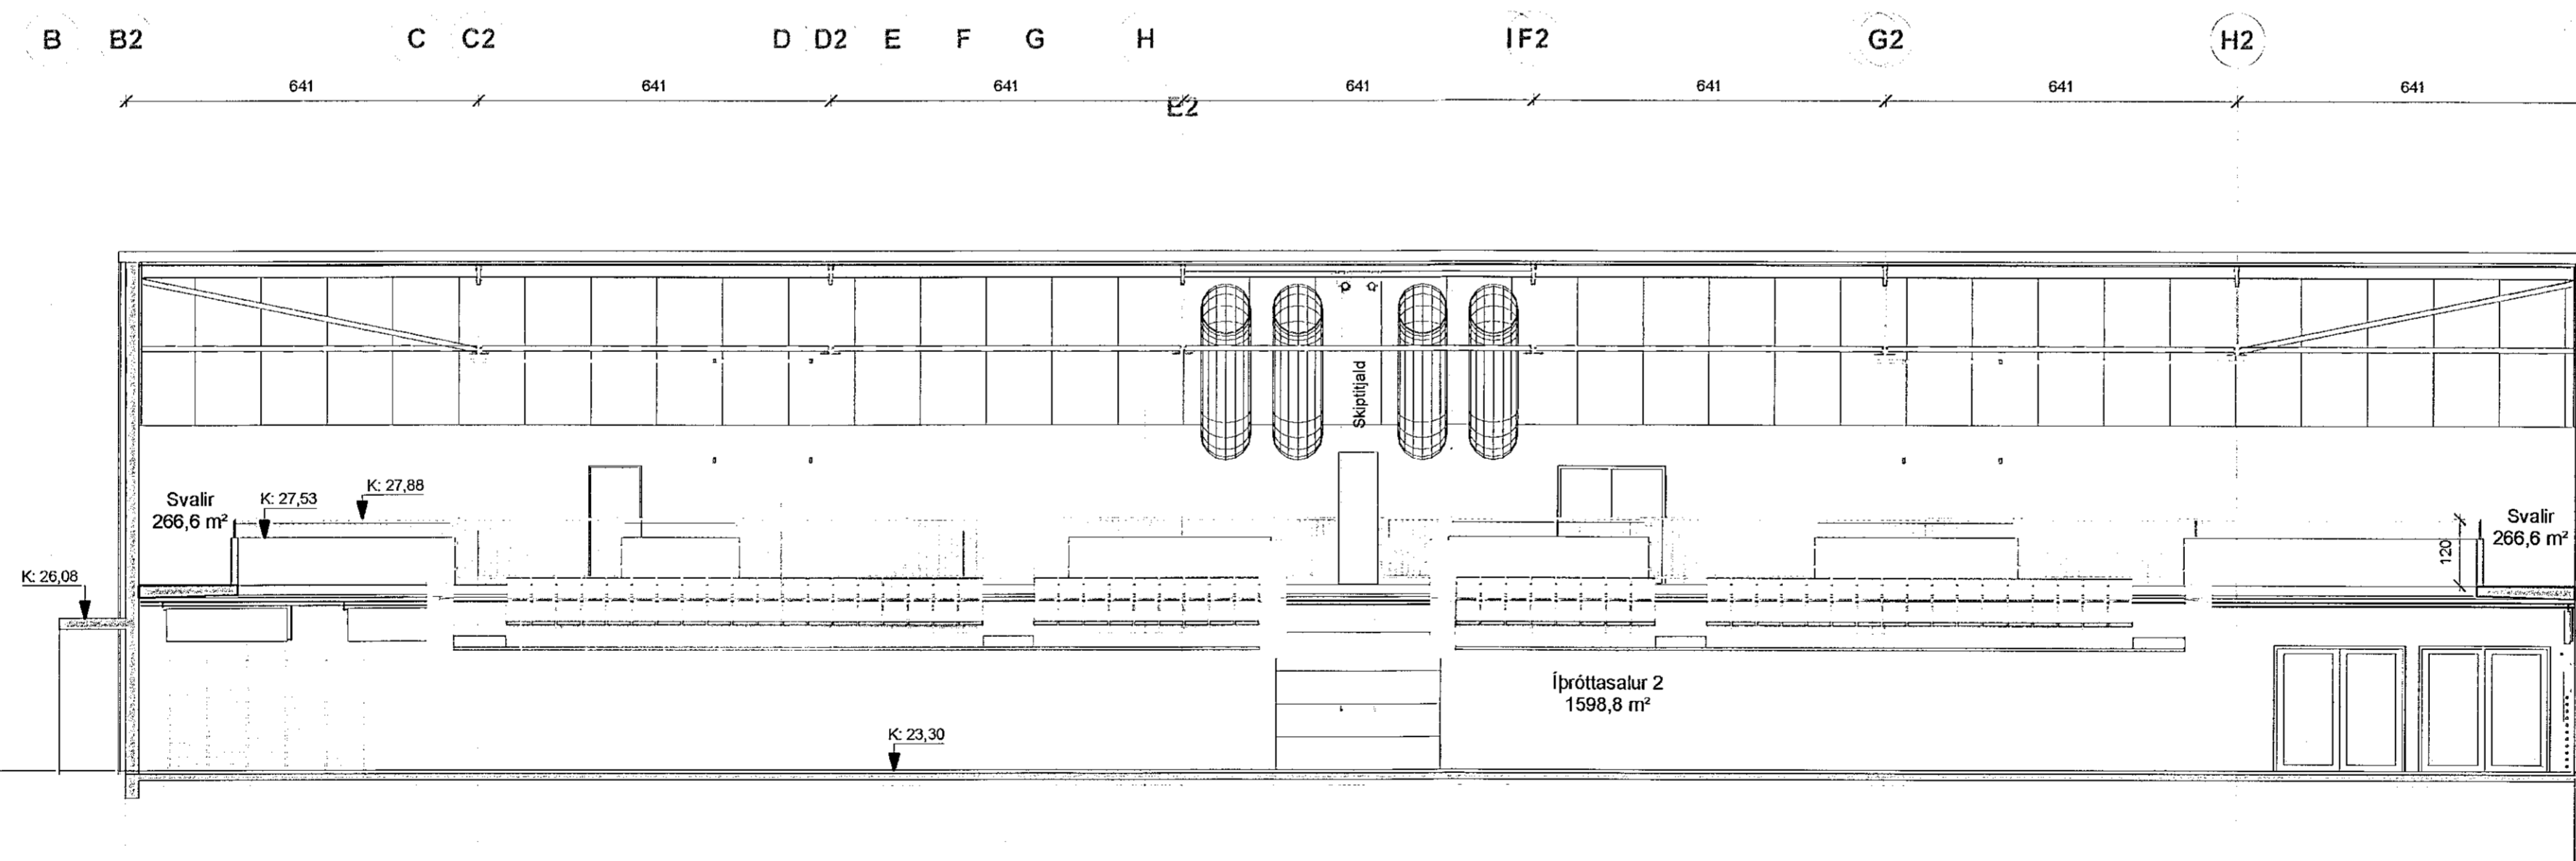

G-G
1 : 100

Skýringar vegna breytinga
A Gluggum og hurðum breytt.
Breyting á brunamerkingu á hurðum.

2018-02-2
3 13:03:26

A	KJH	HMH	09.02.2018
ÚTGÁFA	TEIKNAD	YFIRFARID	Dags

ASK ARKITEKTAR EHF
GÖRSGÖTU 9
101 REYKJANÚK
SMN 515 C300
WWW.ASK.IS

ÁSTJUN ARBÚKUNENDAR
Högni Már Halldórsson
ASK ARKITEKTAR

VERKFRJG ÍÞRÓTTAMÍÐSTÖÐ HAUKA Ásvöllum 1, Hafnarfirði	MAX. I. A. 1 : 100	
TEGUND TERNINGAR Aðalleikrýngar	HMH	
HEIÐ TERNINGAR Sveidng F-F og G-G	KJH	
	HMH	
	04.11.2016	
VERK NR. 9623	AUKENDI - TERNIR TERNINGAR A-115	ÚTGÁFA A