
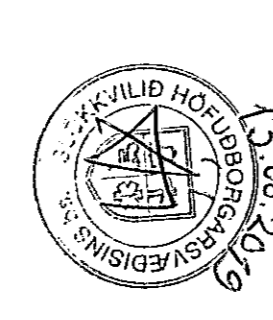
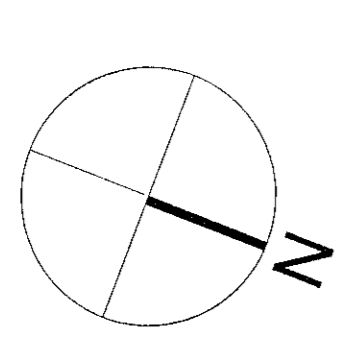


SKYRINGAR:
EKKI til umfollunar

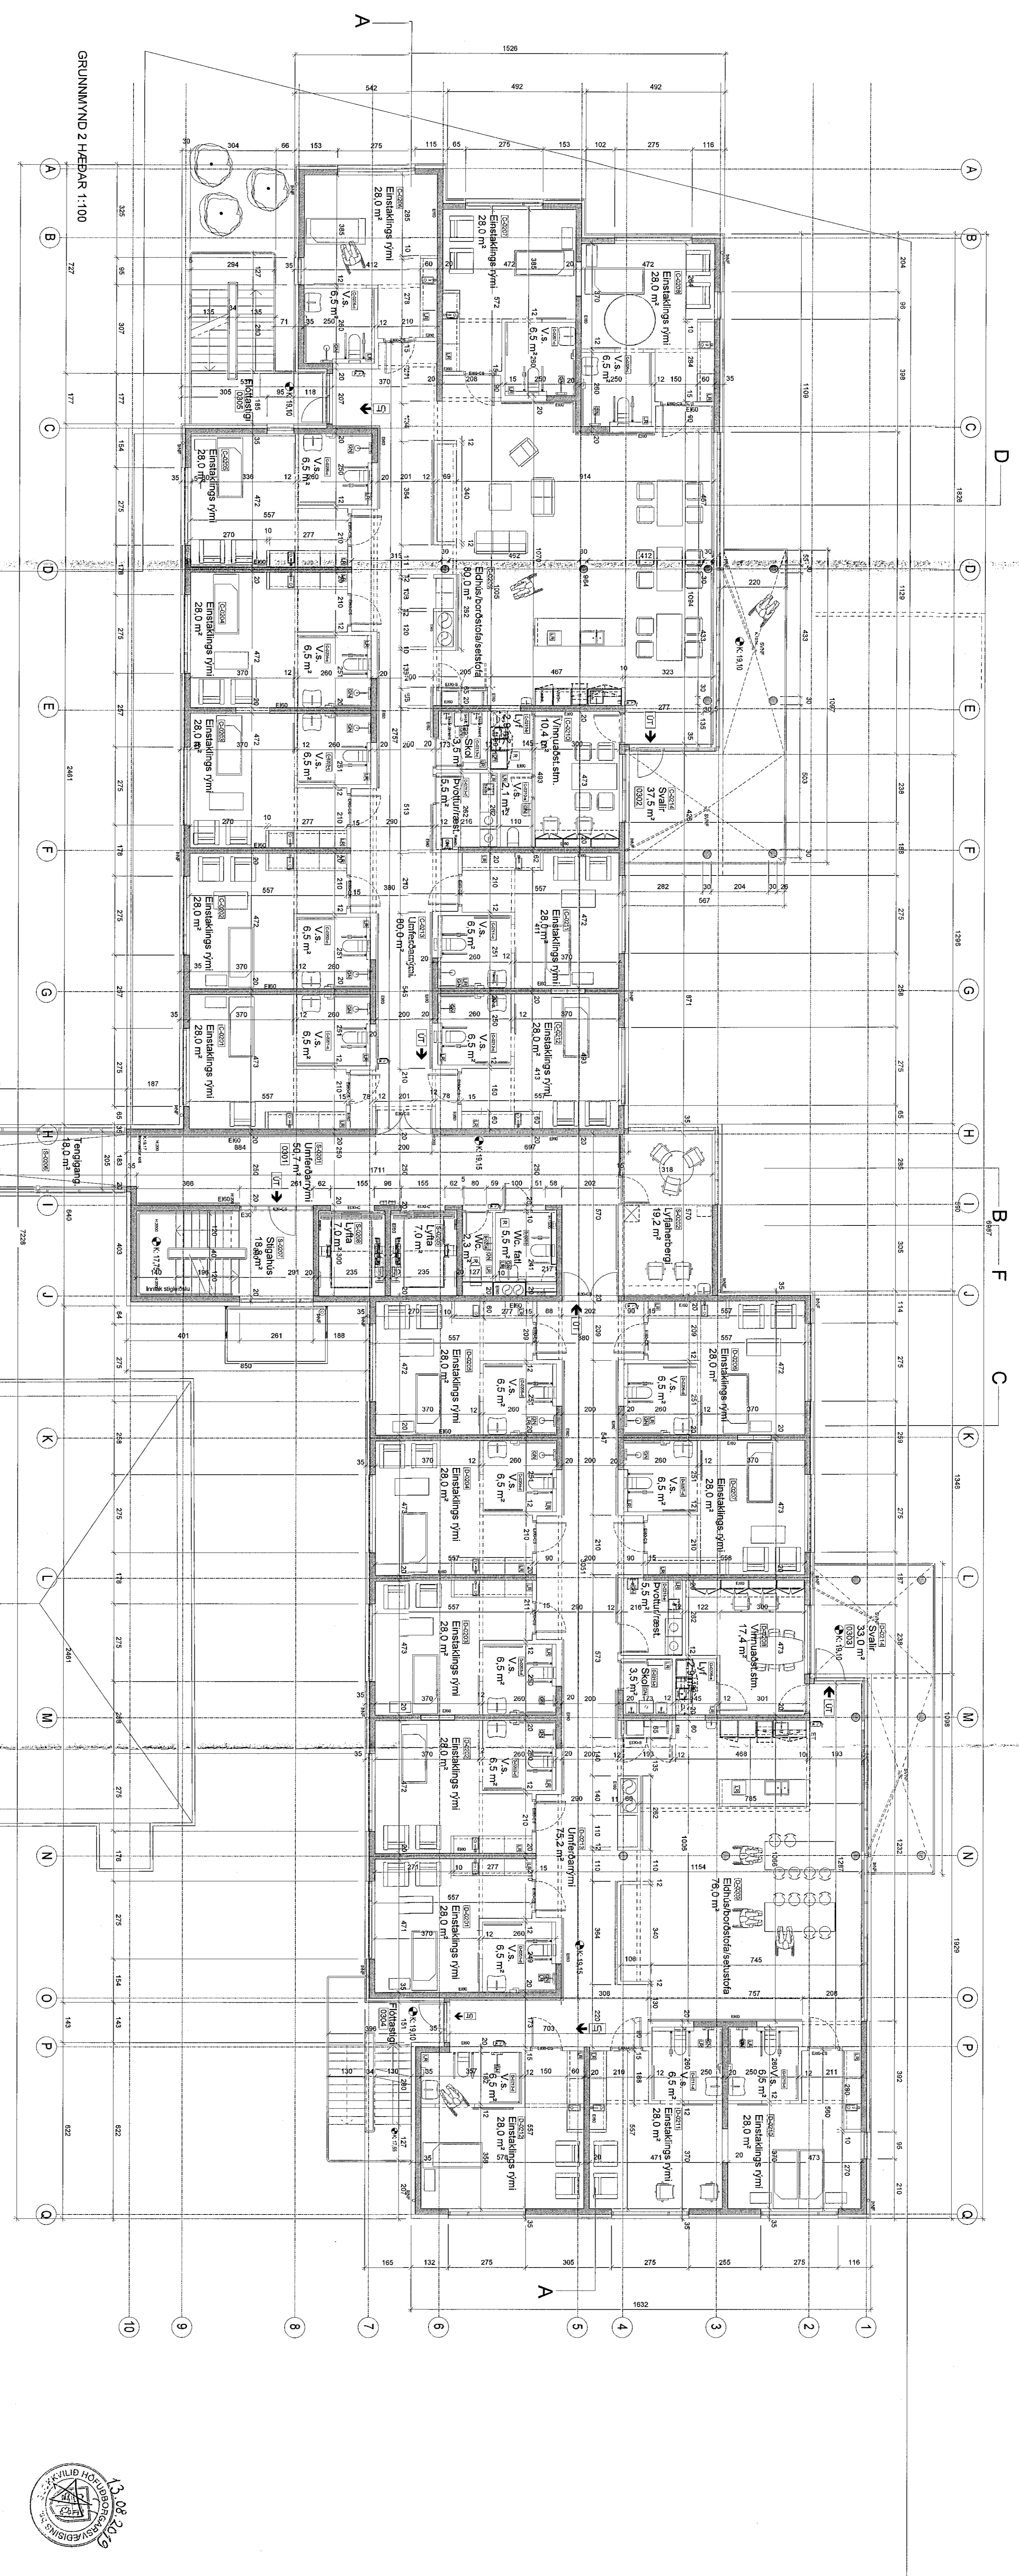

HEILBRIGGSFRILT
HAFNARFARBAR
OG KÖPUGGSSVÆÐIS
Gæðaklassi 5 - 210 Gæðskil
28.03.2019
D.A.S.

ABALUPPRÁTTUR

SÖLVANGUR SÖLVANGS/EGI 2 HAHAARFRIÐI
REYNDARTÆKING
VERK 1533 Deimur
KVASIS 1100
D.A.S. 12.01.2017
TEKNI J.S.P.
SPEL 1533 Deimur 1899

GRUNNMÝND 2 HÆÐAR
UTI INNI

ARKITEKTAR

ARNAR ÞÓRSSON
SILVA
NETTAN
VERJAN
BALDUR G. SÖLVANGSSON
12.03.2018
JÓN NORÐMANNSSON

A-103