



Samþykkt þann
14. ágú. 2019
Byggingafullgáinn í H. *[Signature]*

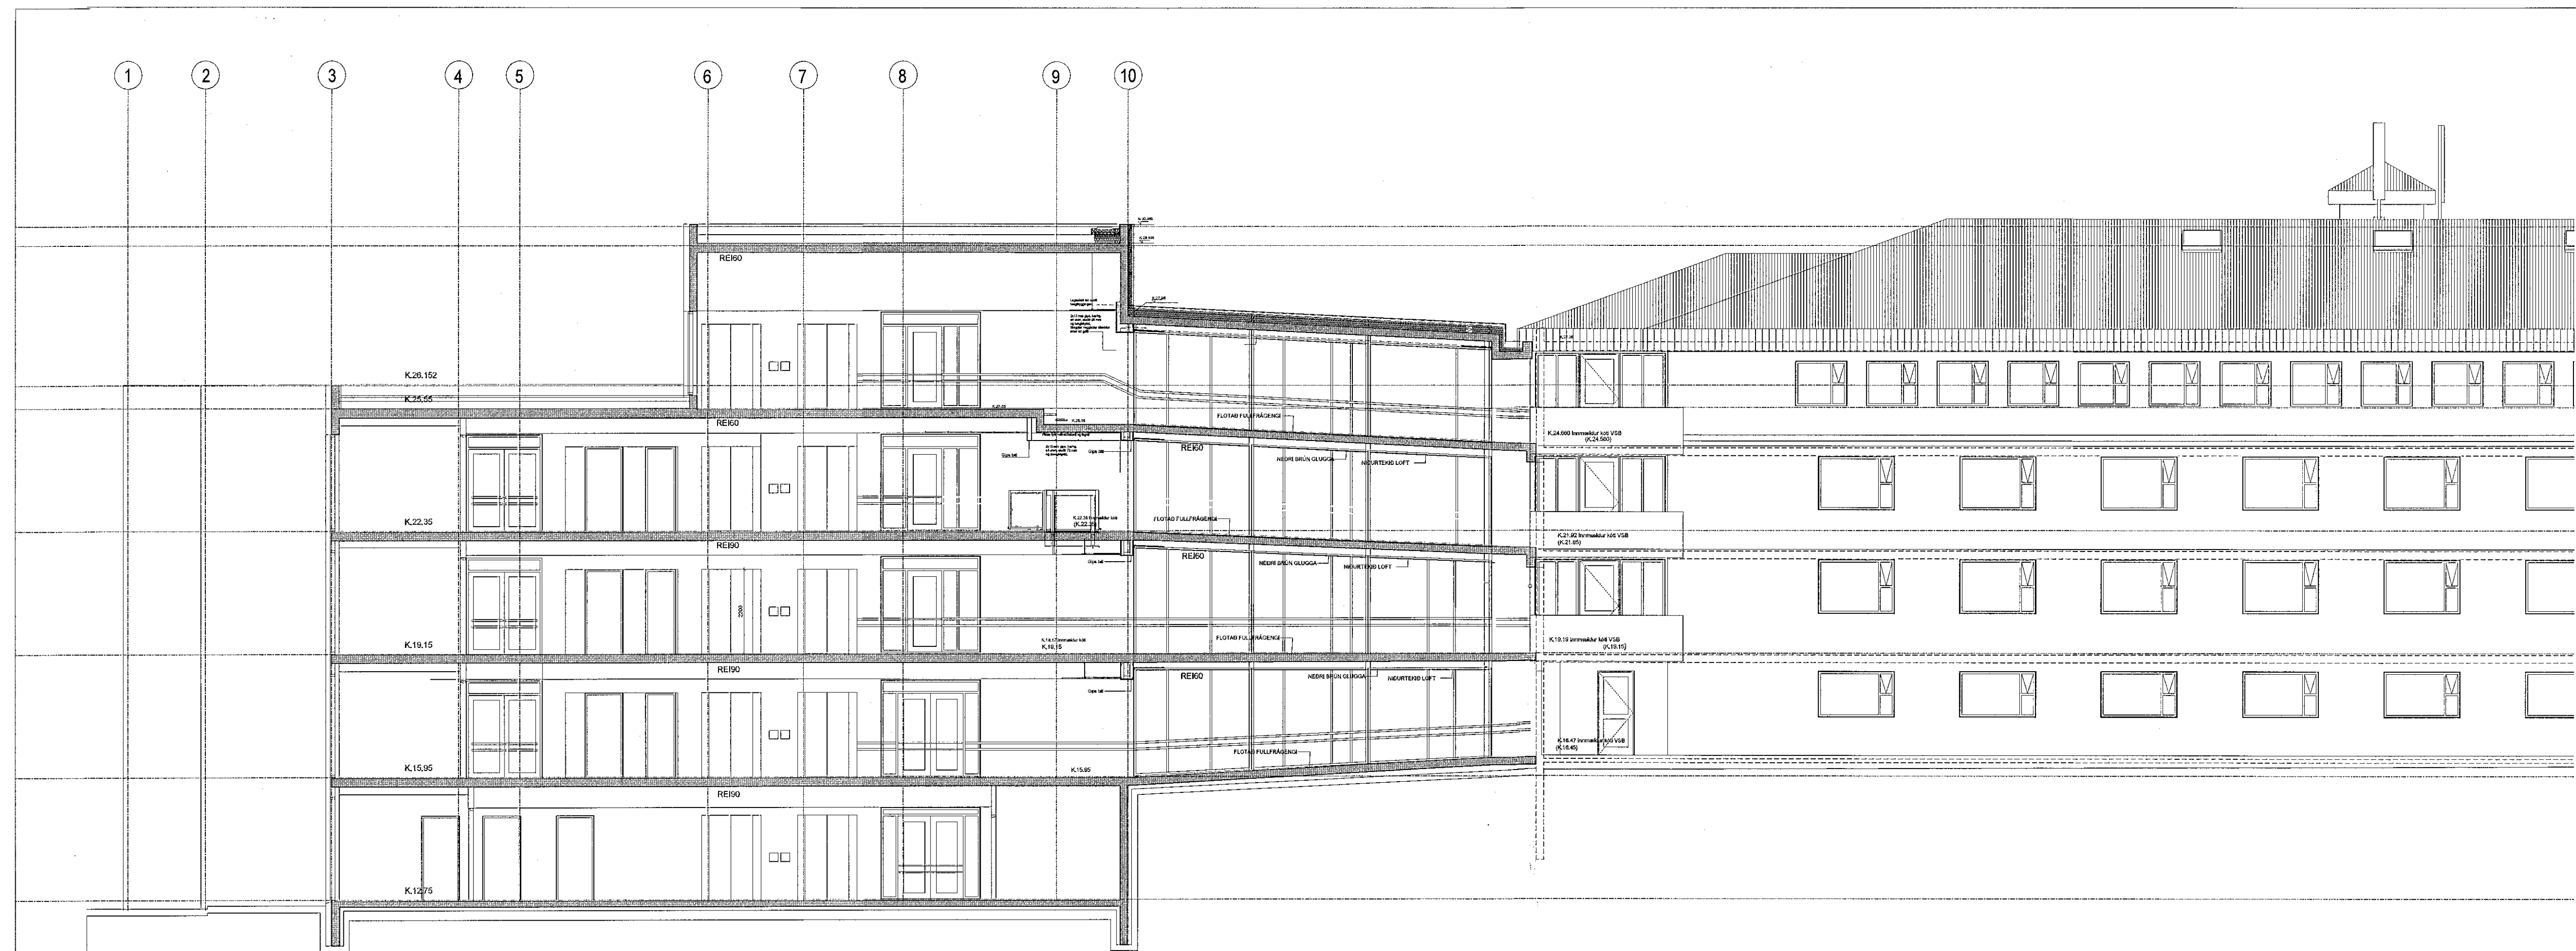

SNEIDING B-B 1:100

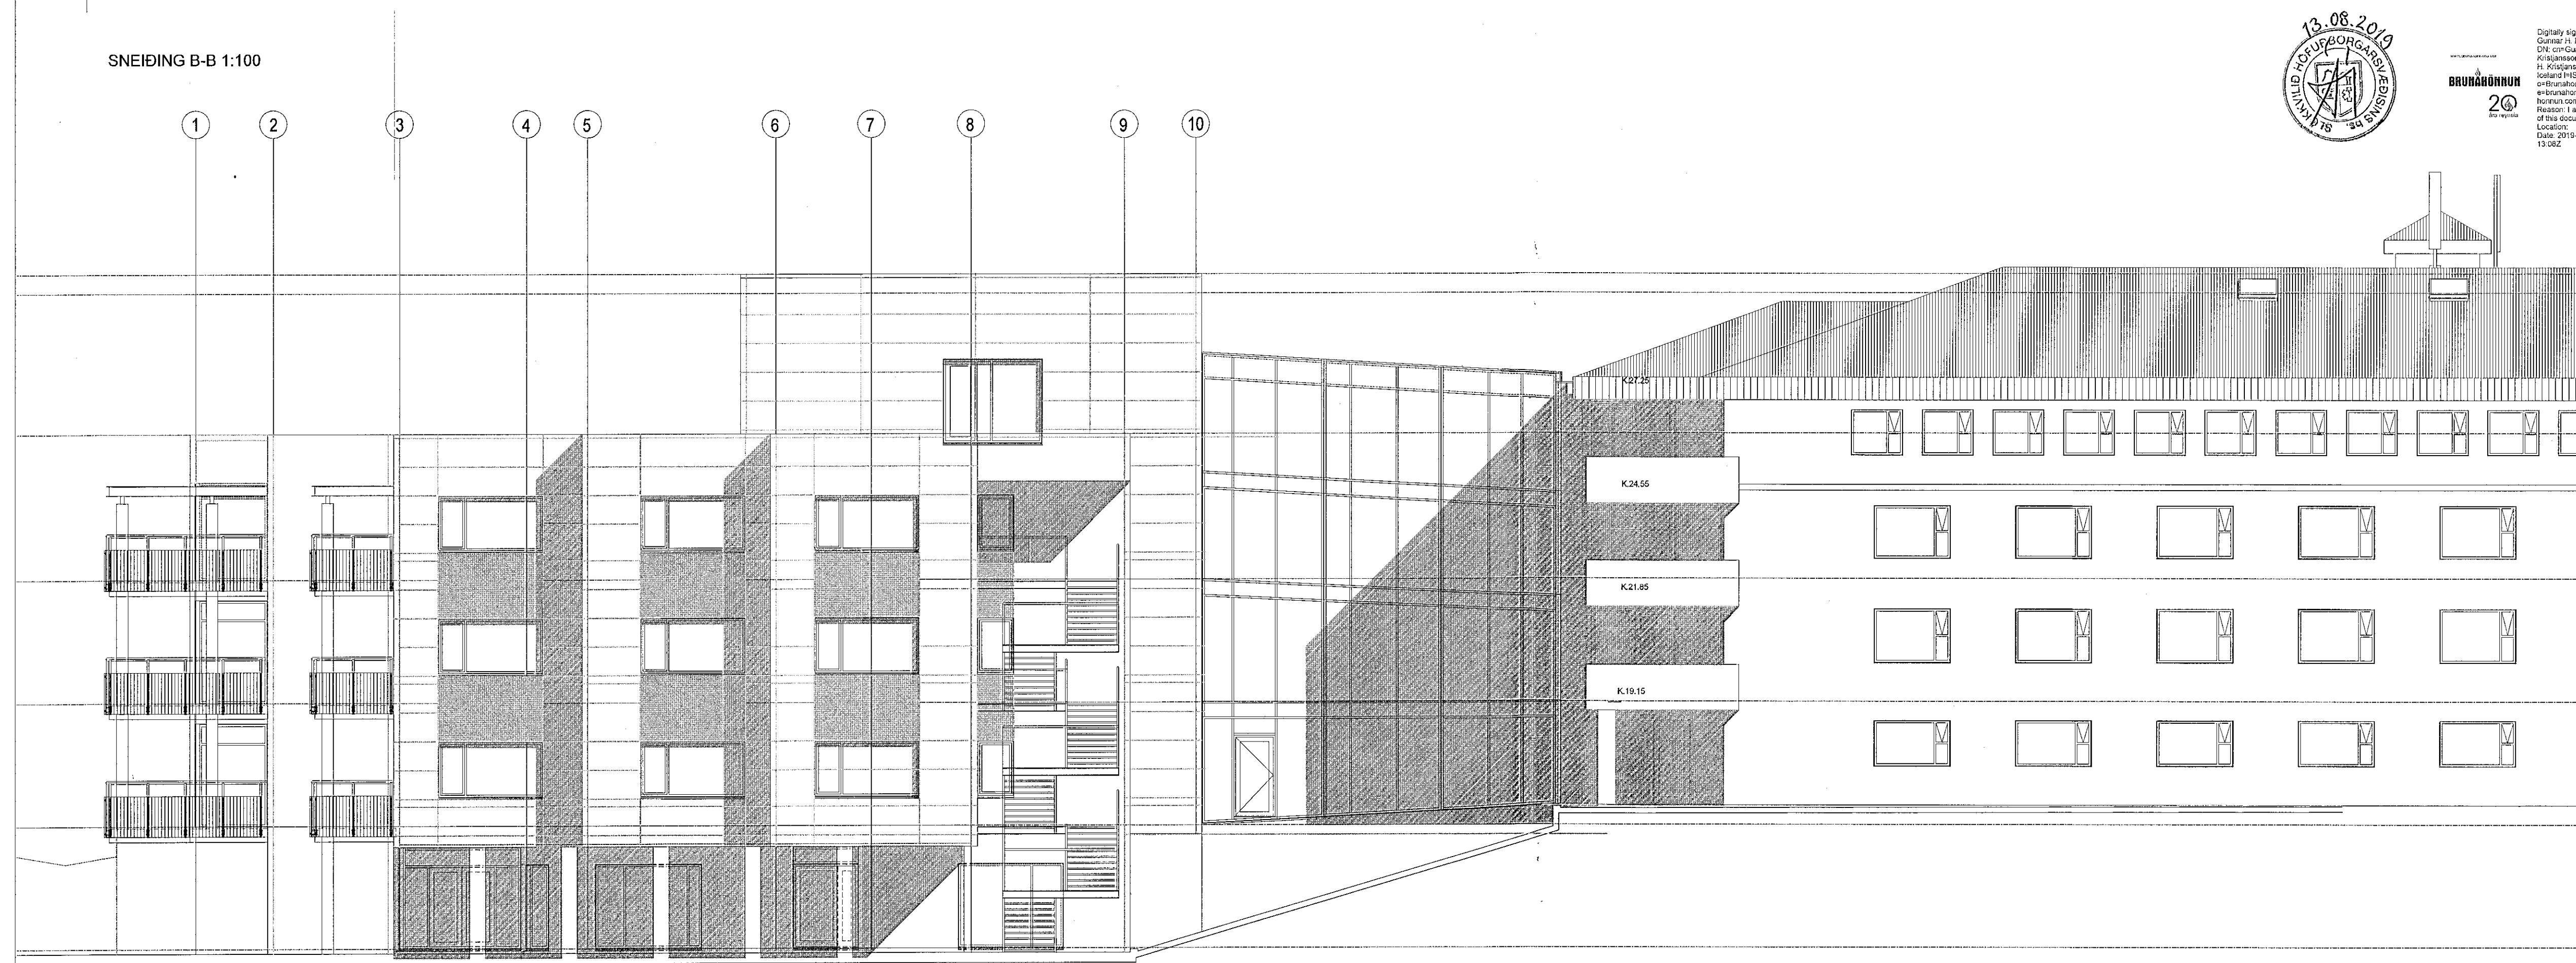

NORDVESTUR



Digitally signed by
Guðmundur H. Snjóvarsson
DN: cn=Guðmundur H.
Snjóvarsson, o=Guðmundur
H. Snjóvarsson, ou=Guðmundur
H. Snjóvarsson, email=guðmundur@snjovarsson.is
Reason: I am the author
of this document.
Location:
Date: 2019-07-29
13:02

D:
C:
B:
A: Innra skýpúlagi breytt 28.06.2019
BREYTINGAR: DAGS:

ADALUPPDRATTUR

SÓLVANGUR SÓLVANGSVEGI 2 HAFNARFIRÐI
REYNDARTEIKNINGAR
VERK: SOLV 1533
KVARDI: 1:100
DAGS: 12.01.2017
TEIKN: JB
SNEIDING OG ÚTLIT
SKRÁ: 1533-Grumur.dwg

ÚTI INNI

ARKITEKTAR
ÞINHOLTSSTRÆTI 27 101 REYKJAVÍK
SÍMAR: 5527660 & 5627660 FAX: 5527661
NETFANG: ul@ul.is VEFFANG: www.ul.is
BALDUR Ó. SVAVARSSON ARKITEKTAR FAI
122357-5149
JÓN ÞÓR ÞORVALDSSON ARKITEKTAR FAI
021256-7579

A
A-107