



08. JAN. 2020


Byggingarfulltrúinn í Hafnarfirði
Kjartan Rafnsson

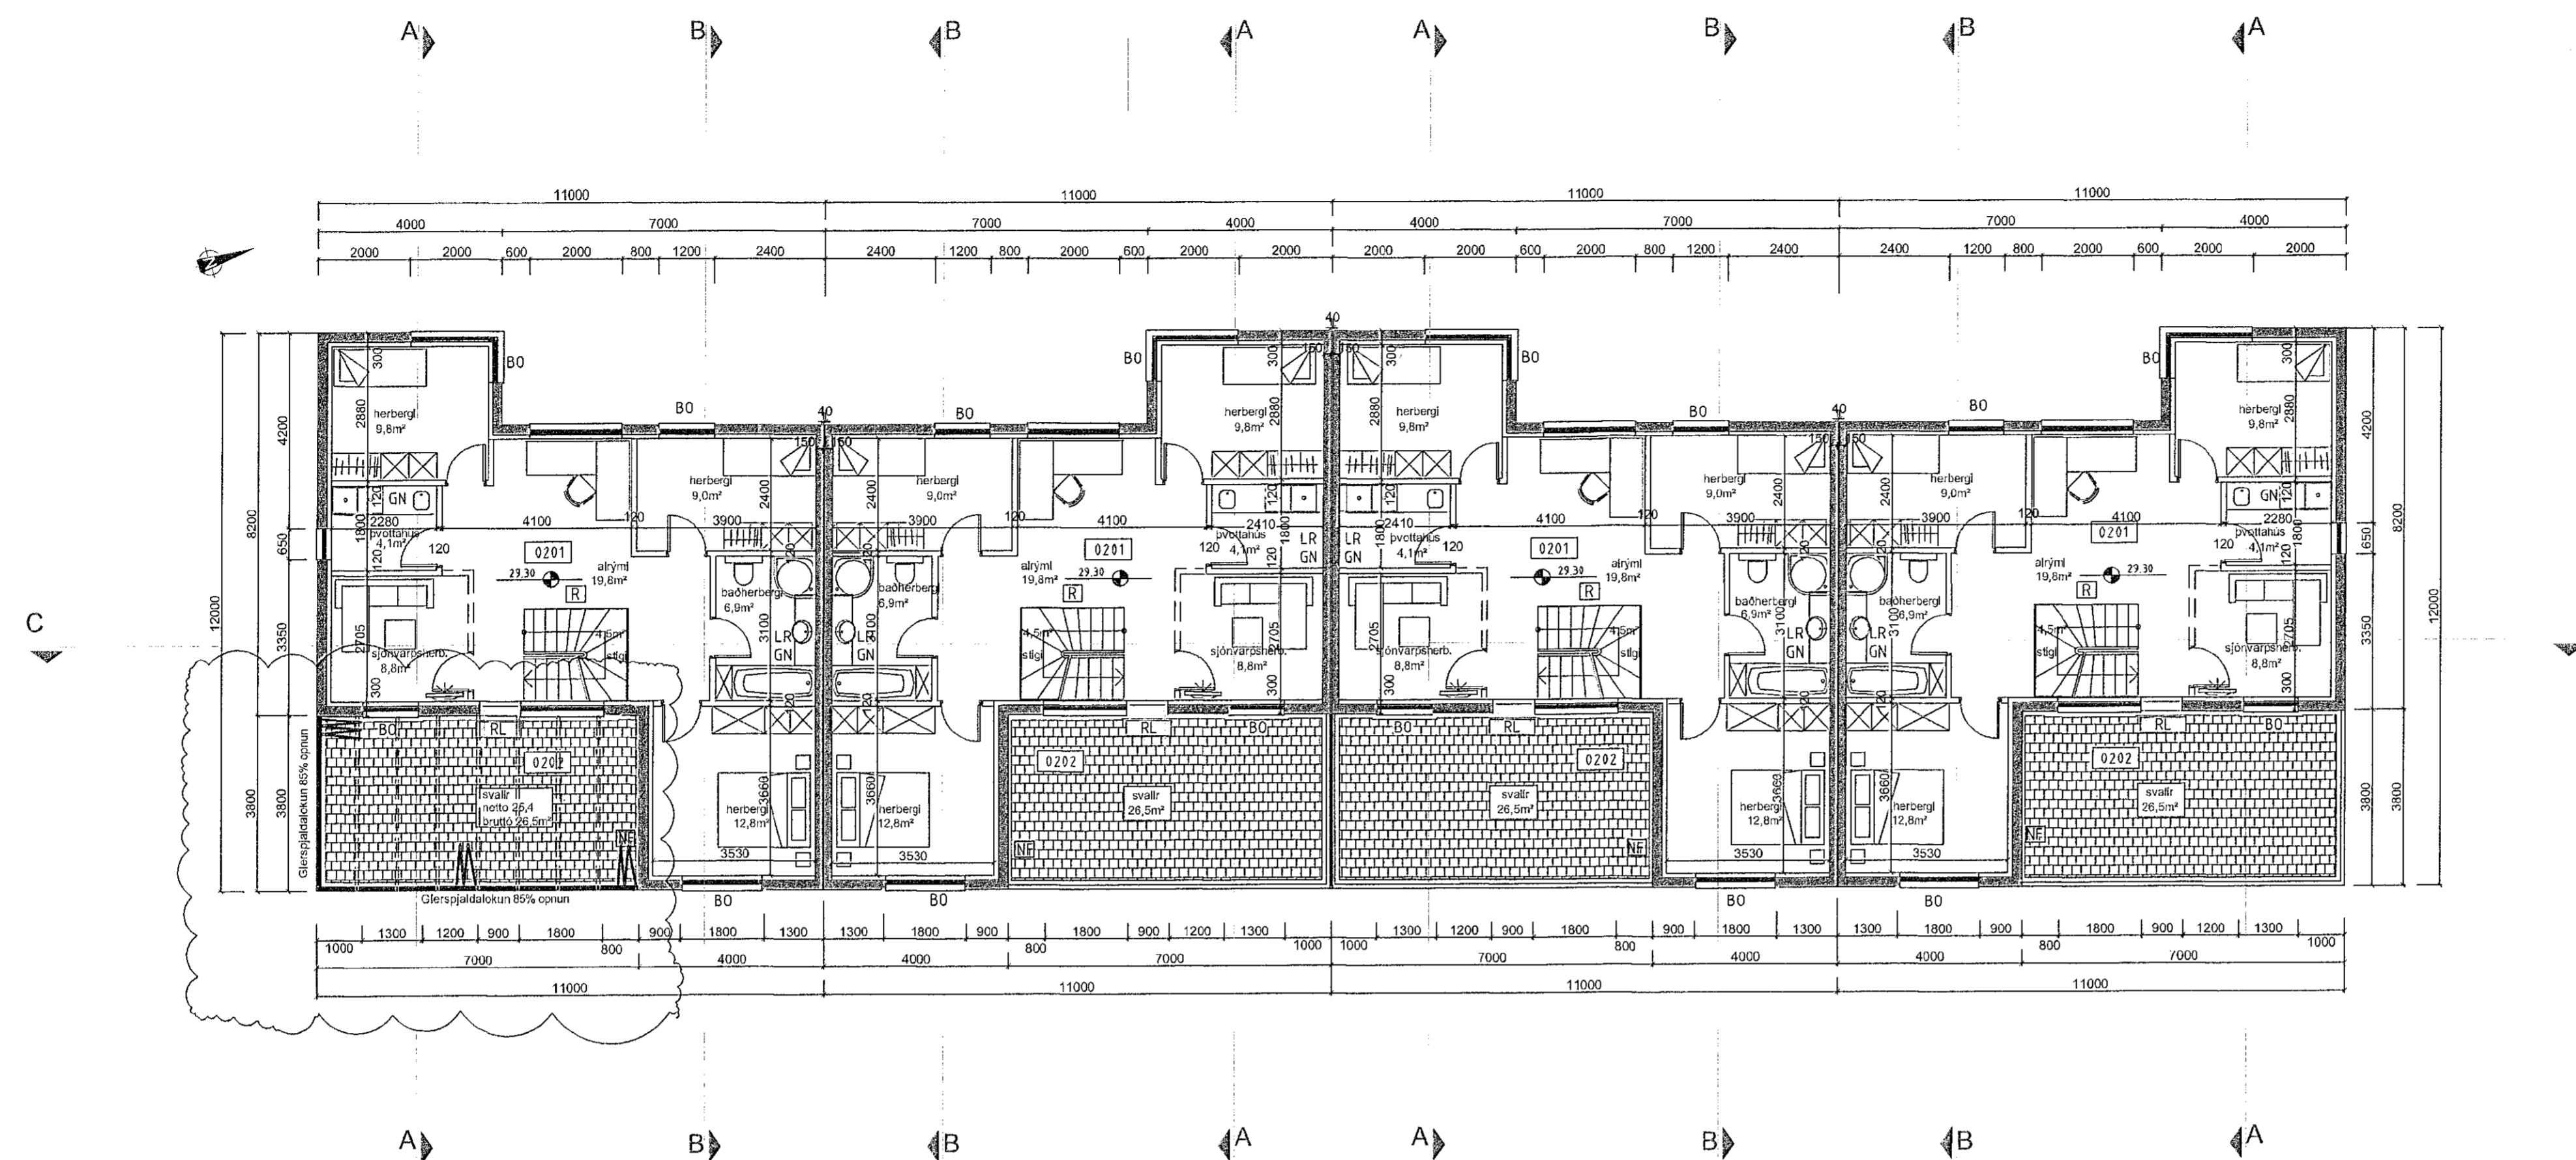


GRUNNMYND 2. HÆÐAR
1:100

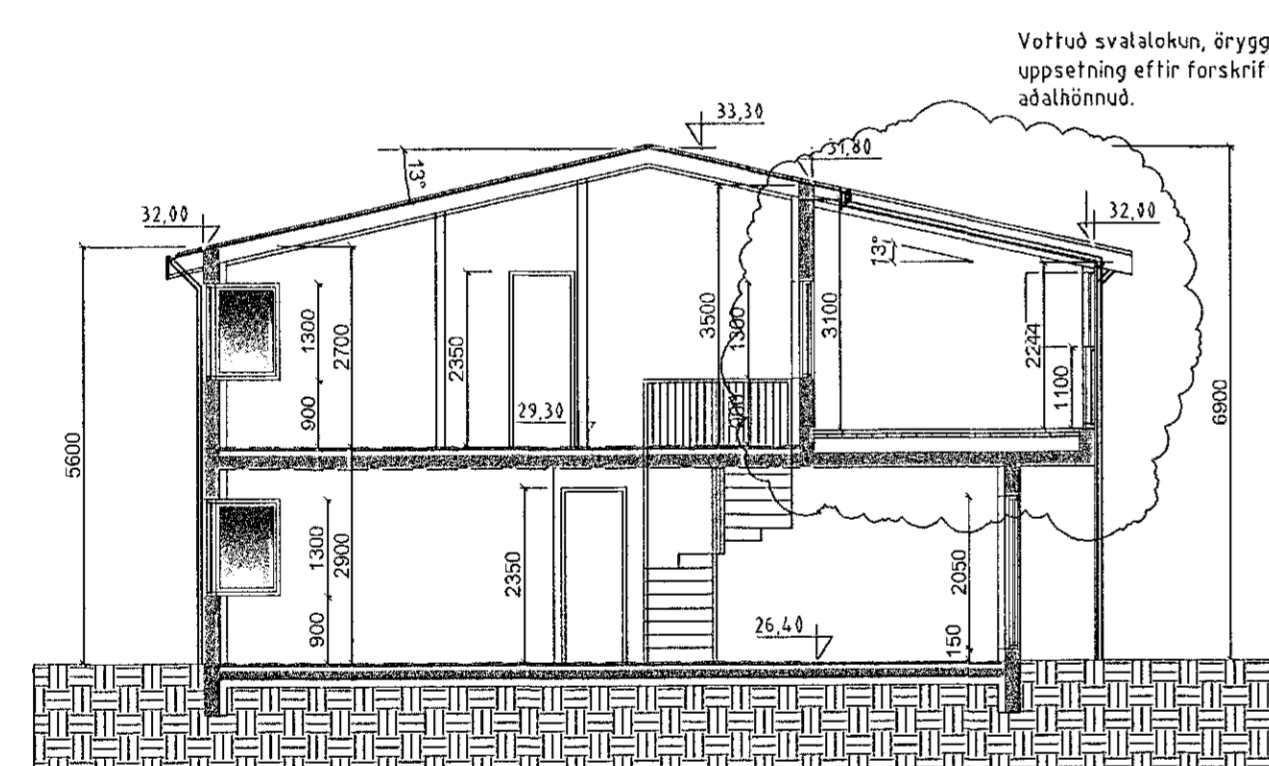


SNEIDING A-A HÚS 10
1:100

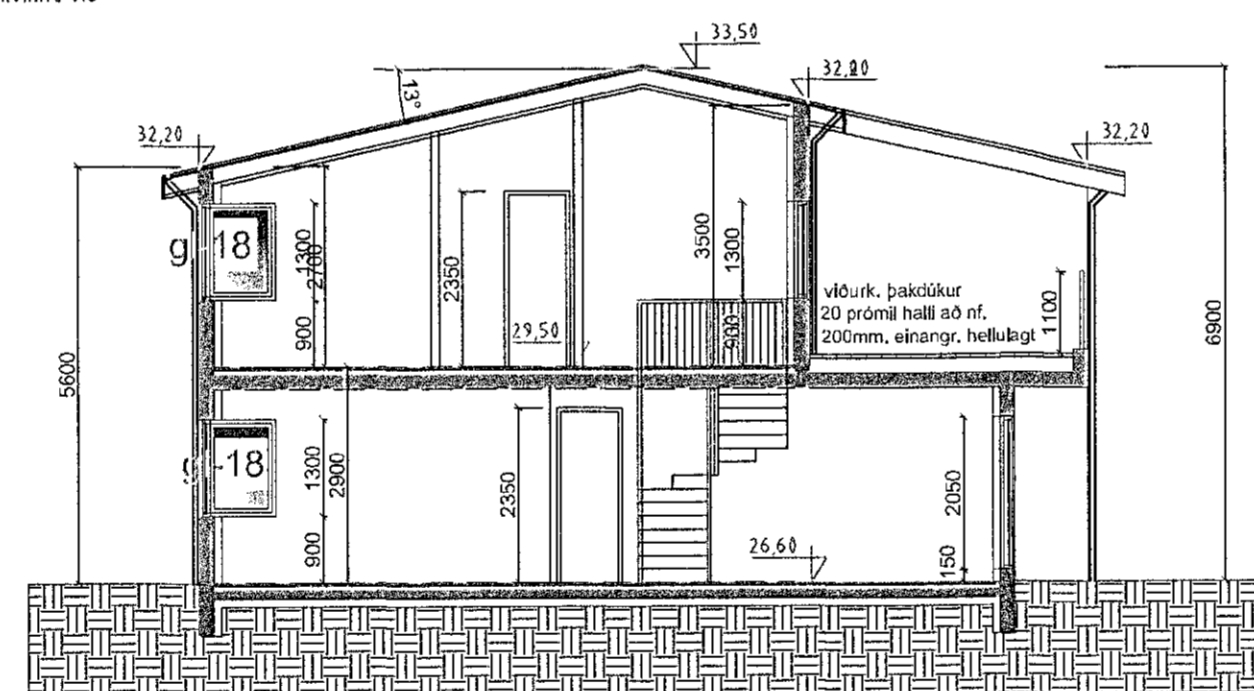

SNEIDING A-A
1:100

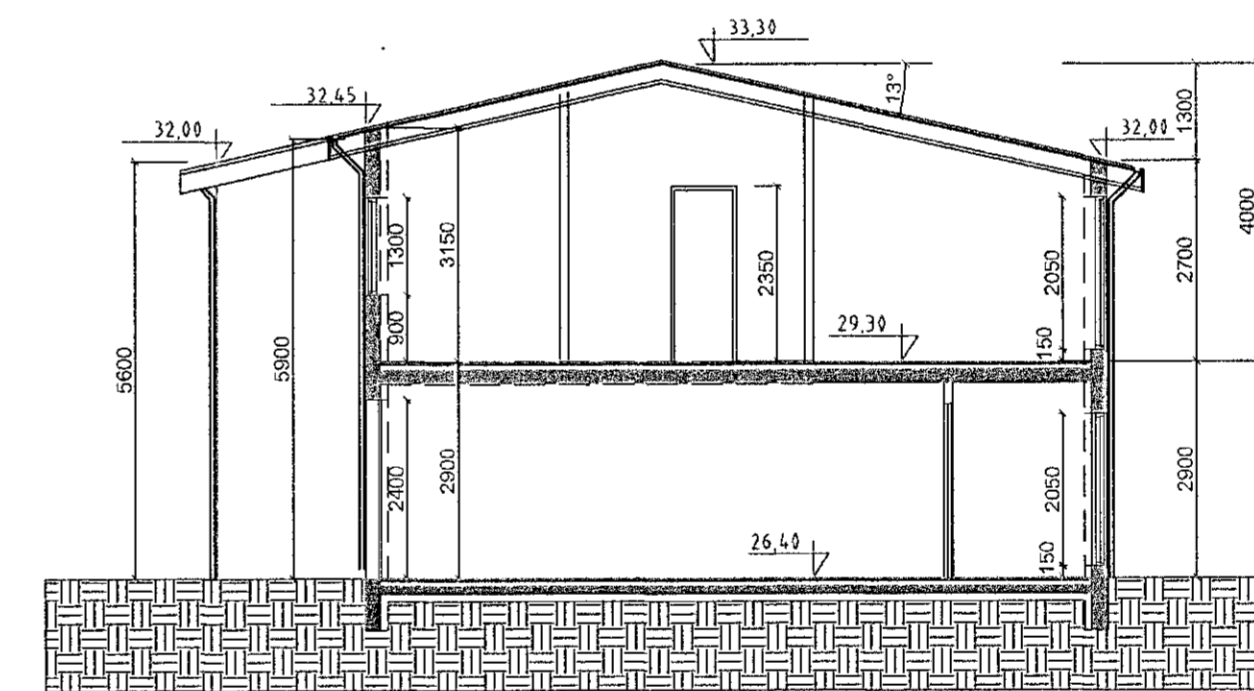

SNEIDING B-B
1:100

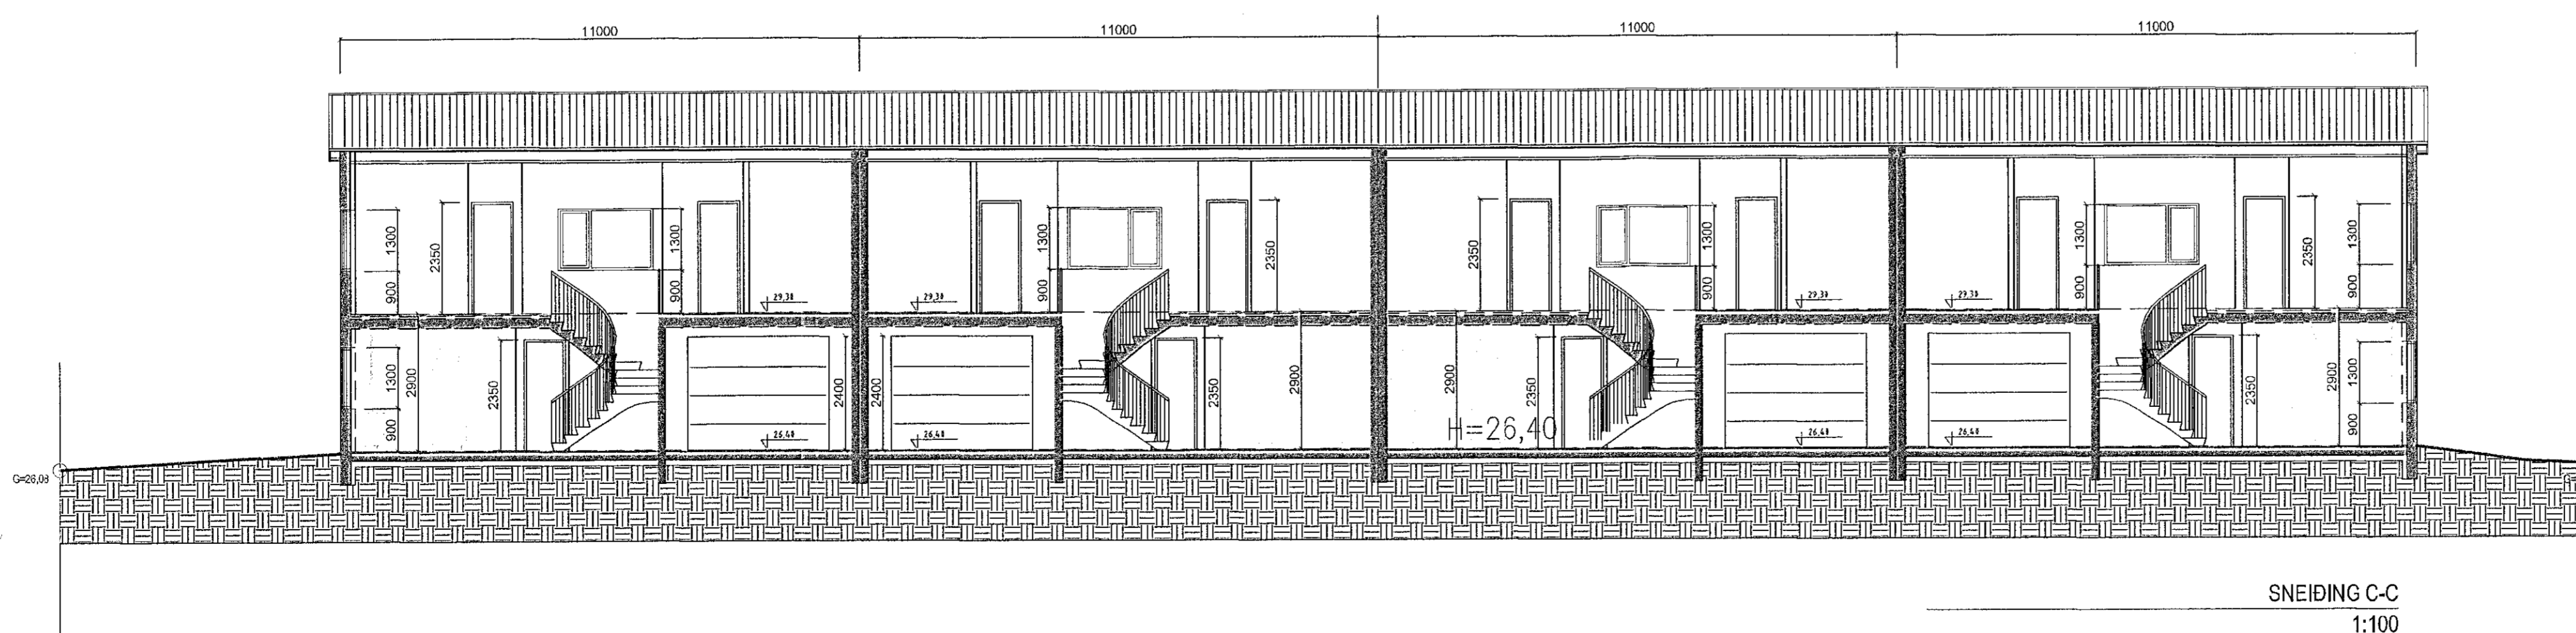

SNEIDING C-C
1:100

NR.	DAGS.	BREYTING	SP.
01	11.12.19	SVIALOKUN Á HÚSI NR. 18	



460902-2150

554-3232
899-3234
E-MAIL kjartan@vikar.is

HÖNNUN - SKIPULAG - RÁÐGJÖF
KJARTAN RAFNSSON FJELDGA
JÓN M. HALLDÓRSSON BYGGINGAFR.

Kjartan Rafnsson

VERK
KVISTAVELLIR 18-24
HAFNARFIRÐI

TEKNING
GRUNNMYND OG SNEIDINGAR

KVARDI
1:100

DAGS.
17.08.2006
TEKNAÐ AF
KR, JM/H

TEKNING NR.

10-03